



DECATUR ROAD

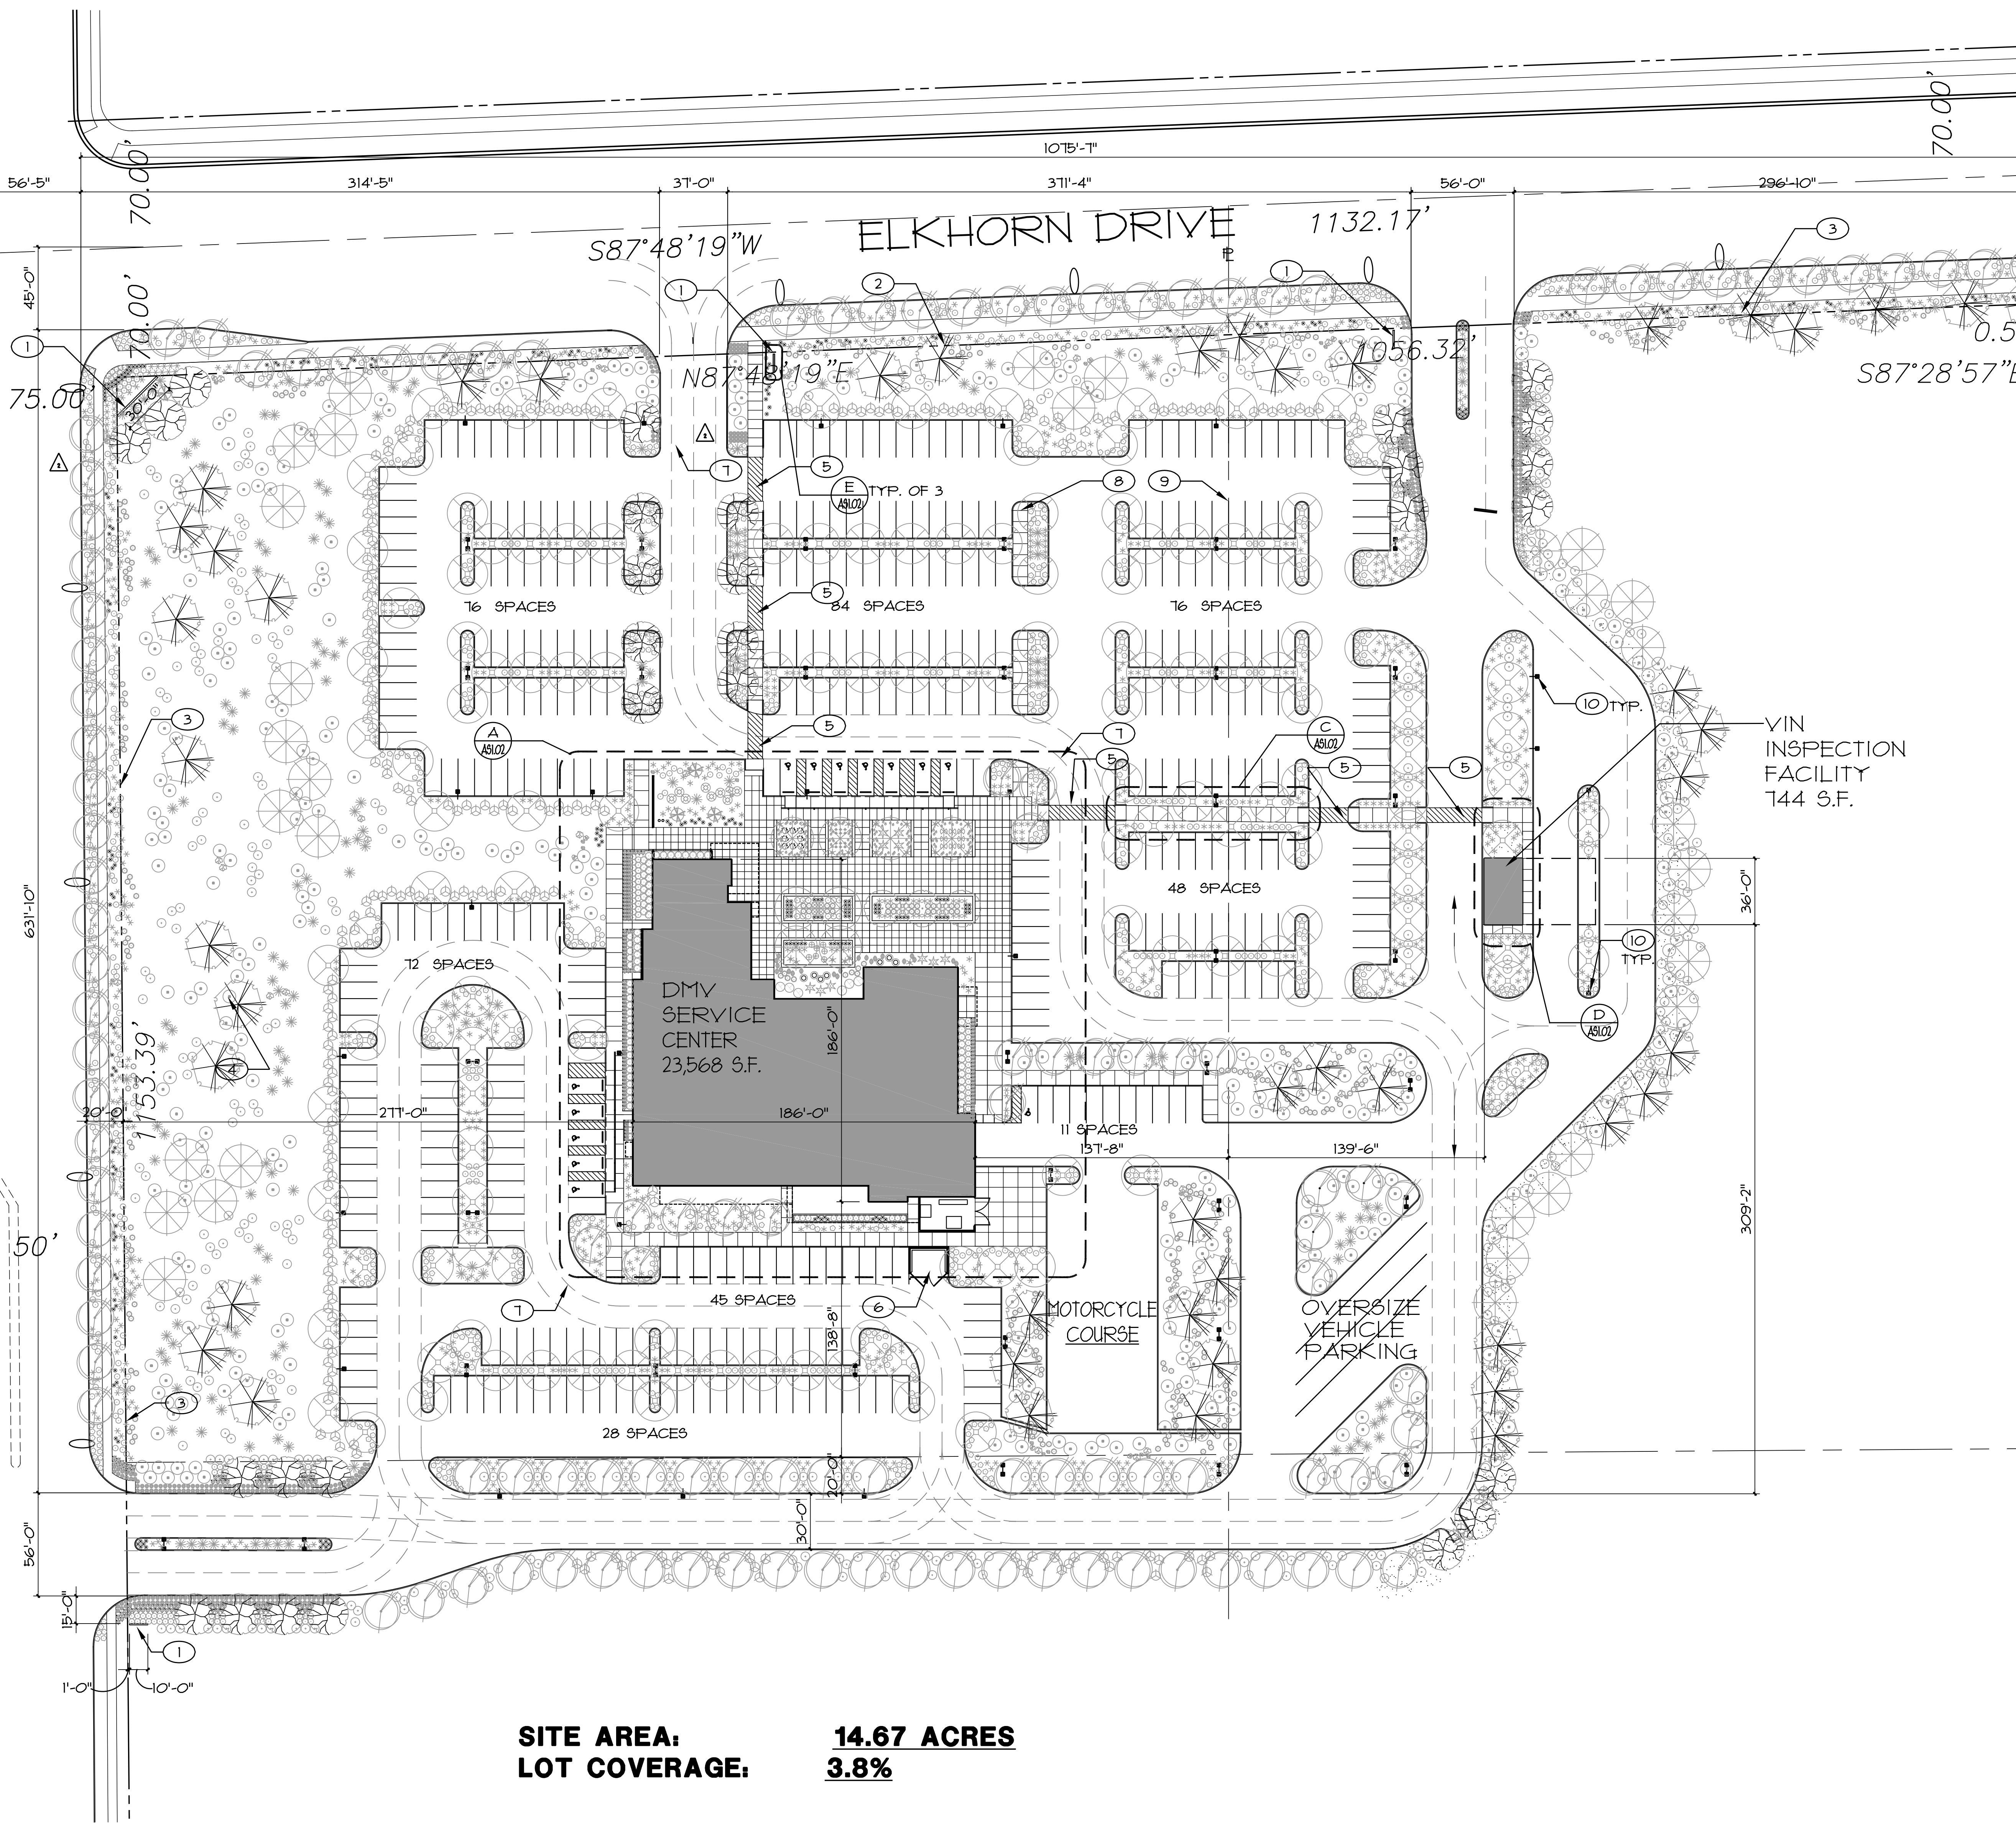

SITE AREA: 14.67 ACRES
LOT COVERAGE: 3.8%

SITE PLAN
SCALE: 1" = 40'-0"

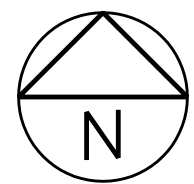

KEYNOTES

- 1 MONUMENT SIGN SEE DETAIL 1/A91.04
- 2 PROPERTY LINE
- 3 RIGHT OF WAY GRANT FOR ROADWAY AND UTILITIES
- 4 LANDSCAPED AREA
- 5 8' WIDE ACCESSIBLE PATH OF TRAVEL STRIPE SIMILAR TO ACCESSIBLE AISLE.TYP.
- 6 TRASH ENCLOSURE
- 7 FIRE TRUCK LANE TYPICAL
- 8 SIDEWALK TYPICAL
- 9 ASSUMED PROPERTY LINE
- 10 FOR LIGHTING TYPE & LOCATION SEE ELECTRICAL DRAWINGS

**RECORD DRAWINGS
NOT FOR CONSTRUCTION**

1. TO ALTER THESE DOCUMENTS FOR ANOTHER PROJECT BY ANYONE OTHER THAN THE ORIGINAL ARCHITECT IS A VIOLATION OF AIA A191.04.
2. THIS RECORD DRAWING HAS BEEN PREPARED BY PARTY BASED UPON INFORMATION FURNISHED BY THE ORIGINAL CONTRACTOR. WHILE THIS INFORMATION IS BELIEVED TO BE RELIABLE, THE DESIGN PROFESSIONAL CANNOT ASSUME ITS ACCURACY AND SHALL NOT BE RESPONSIBLE FOR THE ACCURACY OF THE RECORD DRAWING OR FOR ANY ERRORS OR OMISSIONS WHICH MAY HAVE BEEN INCORPORATED INTO IT AS A RESULT OF THE DESIGN PROFESSIONAL'S REVIEW AND DOES NOT WARRANT THEIR ACCURACY.
3. INFORMATION THAT MAY BE INCLUDED, WOULD BE SIGNIFICANT CHANGES TO ROOM ARRANGEMENTS ON THE FLOOR PLANS AND ASSOCIATED DRAWINGS, WOULD DIMENSION OR CONSTRUCTION DETAIL CHANGES MAY NOT BE INCLUDED.

SUBCONTRACTOR

MARTIN HARRIS CONSTRUCTION

DATE

DATE

ARCHITECTS

TATE SNYDER KIMSEY

Consultant

Sheet Title
SITE PLAN

Project
**NORTH DECATUR
DMV SERVICES CENTER
NORTH LAS VEGAS, NEVADA**

Revisions

RECORD DRAWINGS

Date: 03.31.06

Job No.: 1003019

Sheet No.


AS1.01

703 Valle Verde Court Henderson, Nevada 89014 ph. 702.456.3000 fax 702.898.6209
www.tatesnyderkimsey.com

THESE DRAWINGS AND SPECIFICATIONS ARE THE PROPERTY OF THE ARCHITECT AND MAY NOT BE REPRODUCED OR USED IN ANY MANNER WITHOUT THE WRITTEN CONSENT OF THE ARCHITECT. ANY REPRODUCTION OR USE OF THESE DOCUMENTS ARE NOT FINAL AND READY FOR USE, AND THEREFORE NOT VALID, UNLESS THEY ARE SIGNED, SEALED, DATED, AND INITIALED BY THE ARCHITECT.


Copyright Tate Snyder Kimsey, Ltd. 2001

1=1
019G110

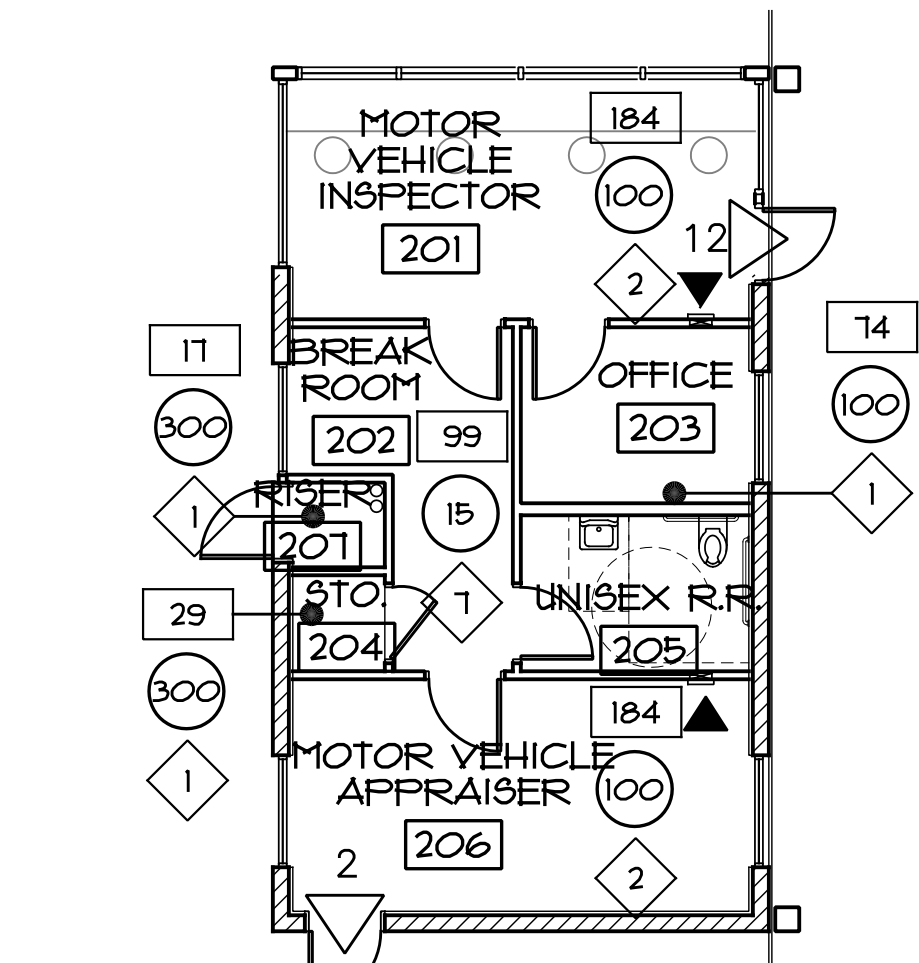

**VIN BUILDING
LIFE SAFETY PLAN**
SCALE: 1/8" = 1'-0"

2

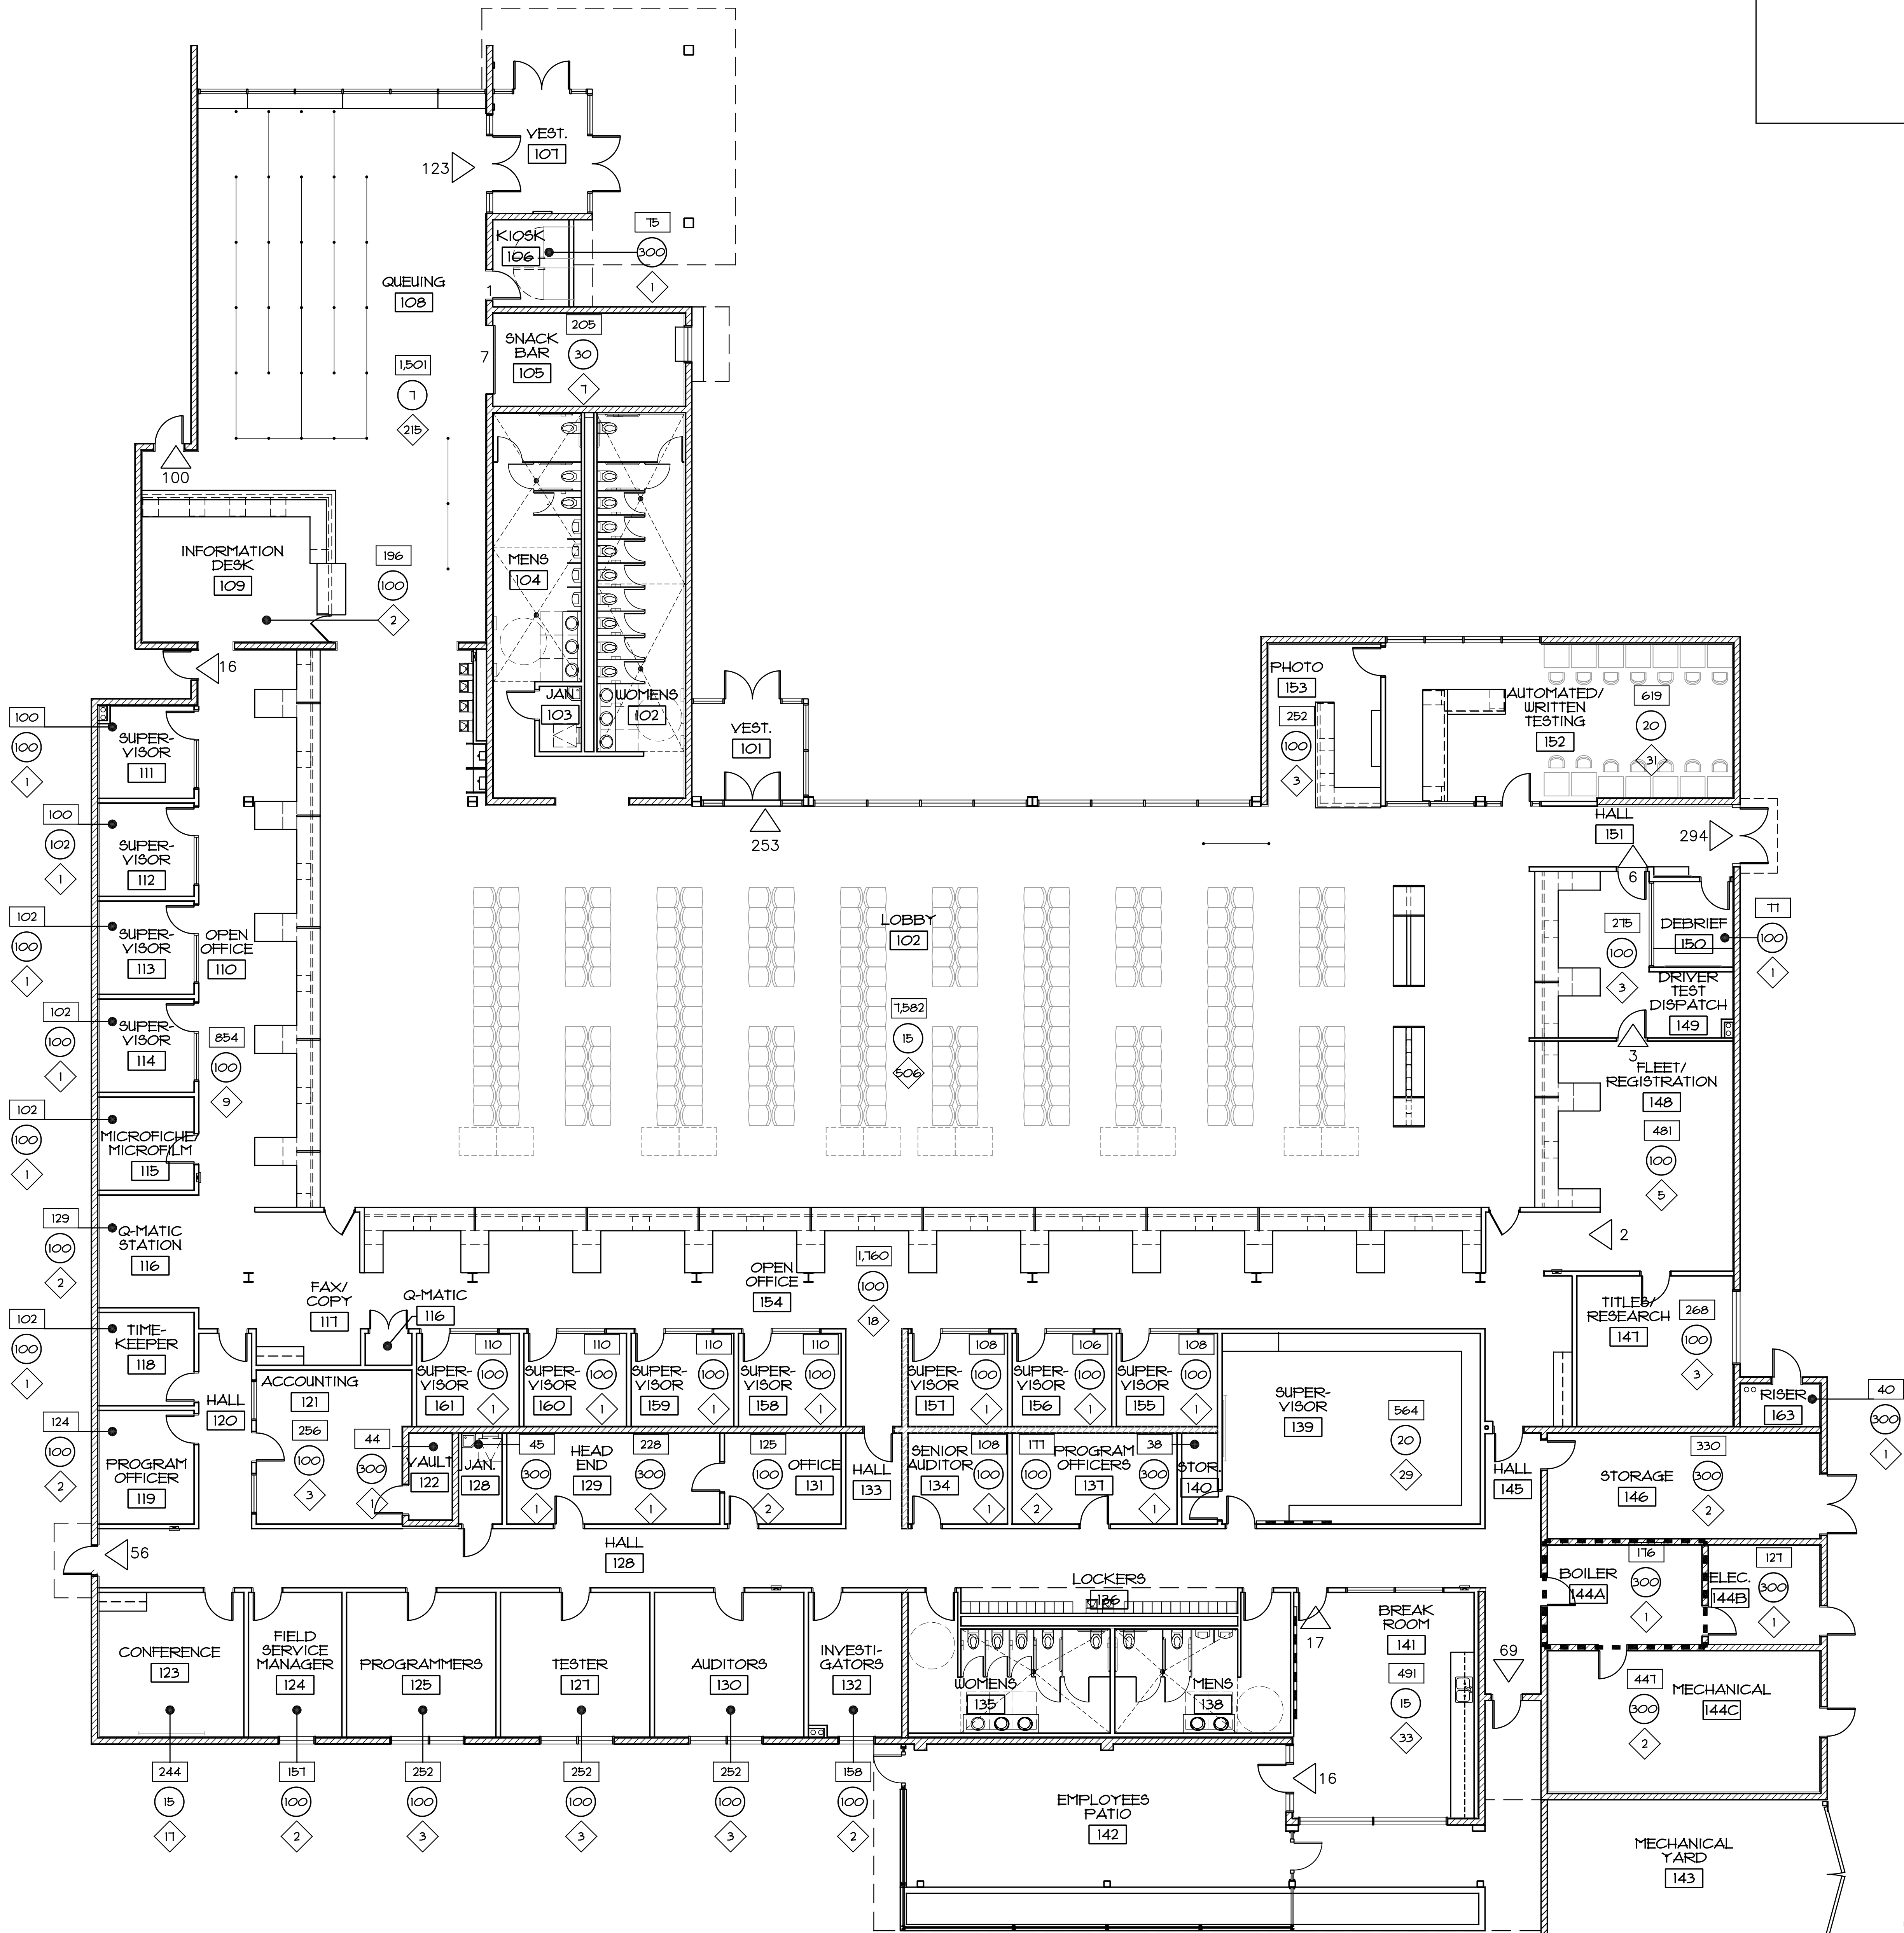

**LIFE SAFETY
FLOOR PLAN**
SCALE: 1/8" = 1'-0"

1

LEGEND

■ ■ ■ ■ ■ 1 HR RATED WALL	○ ○ ○ ○ ○ OCCUPANCY GROUP E-1 UNO.
⊗	⊗ AREA
⊗	⊗ OCCUPANT LOAD FACTOR
⊗	⊗ NUMBER OF OCCUPANTS
⊗	⊗ EXITING QUANTITY
⊗	⊗ FIRE EXTINGUISHER CABINET

**RECORD DRAWINGS
NOT FOR CONSTRUCTION**

1. TO ALTER THESE DOCUMENTS FOR ANOTHER PROJECT BY ANYONE OTHER THAN THE ORIGINAL ARCHITECT IS A VIOLATION OF AIA ETHICS.
2. THIS RECORD DRAWING HAS BEEN PREPARED BY PARTY BASED UPON INFORMATION FURNISHED BY THE ORIGINAL CONTRACTOR. WHILE THIS INFORMATION IS BELIEVED TO BE RELIABLE, THE DESIGN PROFESSIONAL CANNOT ASSUME ITS ACCURACY AND BEHOLDERS OF THIS DRAWING FOR THE ACCURACY OF THE RECORD DRAWING OR FOR ANY ERRORS OR OMISSIONS WHICH MAY HAVE BEEN INCORPORATED INTO IT AS A RESULT OF THE DESIGN PROFESSIONAL'S CARE AND DOES NOT WARRANT THEIR ACCURACY.
3. INFORMATION THAT MAY BE INCLUDED WOULD BE SIGNIFICANT CHANGES TO ROOM ARRANGEMENTS ON THE FLOOR PLANS AND ASSOCIATED DRAWINGS, SHOW DIMENSIONS OR CONSTRUCTION DETAIL, CHANGES MAY NOT BE INCLUDED.

SUBCONTRACTOR: _____ DATE: _____
MARTIN HARRIS CONSTRUCTION DATE: _____

TATE SNYDER KIMSEY ARCHITECTS

Sheet Title
LIFE SAFETY PLAN

Consultant

703 Valle Verde Court Henderson, Nevada 89014 ph. 702.456.3000 fax 702.898.6209
www.tatesnyderkimsey.com
THESE DRAWINGS AND SPECIFICATIONS ARE THE PROPERTY OF THE ARCHITECT AND MAY NOT BE REPRODUCED OR USED FOR ANY OTHER PROJECT WITHOUT THE ARCHITECT'S WRITTEN CONSENT. ANY REPRODUCTION OR USE OF THESE DRAWINGS WITHOUT THE ARCHITECT'S WRITTEN CONSENT IS A VIOLATION OF THE ARCHITECT'S PROFESSIONAL ETHICS AND MAY BE SUBJECT TO LEGAL ACTION. THESE DOCUMENTS ARE NOT FINAL AND READY FOR USE, AND THEREFORE THEY ARE NOT TO BE SIGNED, SEALED, AND DATED.

Project
**NORTH DECATUR
DMV SERVICES CENTER
NORTH LAS VEGAS, NEVADA**

RECORD DRAWINGS
Date: 03.31.06
Job No.: 1003019
Sheet No.

G1.10