

Grant Sawyer State Office Building

Programming and Feasibility Studies



Volume Two | Property Condition Assessment

January 2, 2019





Grant Sawyer State Office Building Programming and Feasibility Studies Volume Two

Prepared for the Nevada State Public Works Division
January 2, 2019

Project Team:

KGA

Architecture and Interior Design

NV5 Consulting Engineers + Bombard

Mechanical, Plumbing and Electrical Engineering

Lochsa Engineering

Civil Engineering

John A. Martin & Associates

Structural Engineering

HKA Elevator Consulting

Elevator Consultants

OCMI

Cost Estimating

The project team wishes to extend a special word of thanks to the members of the State Public Works Division and Buildings and Grounds Section, and to each of the twenty-three additional departments and agencies who participated in the property condition and program needs assessment surveys, interviews, and site visits. The access, support and information provided by the individuals involved have been invaluable to our team and have made the contents of this study possible.



January 2, 2019

We are pleased to submit within these three volumes the Programming and Feasibility Studies prepared by KGA and its consultant team for the Grant Sawyer State Office Building. As home to a range of critical state agencies and departments, and as a touchpoint for the many citizens who visit these agencies each year, the Grant Sawyer State Office Building is an important facility for the operations of the state of Nevada.

In Volume One, the Program Needs Assessment, we provide a comprehensive overview of the current and projected future space needs of the twenty-three subject departments and agencies. Volume Two, the Property Condition Assessment, provides a detailed overview of the current condition and future needs of building systems and components.

In the third volume, Proposed Implementations, the project team proposes a series of potential courses of action for facility improvements. These six concepts are organized by the three 'R's - Repair, Reprogramming and Replacement - which represent a broad range of options which will address the needs of Grant Sawyer occupants looking forward to the year 2040.

As the vital service of the building's occupants to the citizens and economy of the state of Nevada will continue until 2040 and beyond, it is our hope and intent that in the contents of this study, the State will find the best way forward to supporting the physical space needs of the subject departments and agencies through the next two decades.

We thank the State for the opportunity to be involved in this important and exciting project. Please contact us at any time if we can be of further assistance in the process of interpretation and implementation of this study.

Sincerely,

James C. Lord II
Partner, CEO
Brian Henley
Partner, Director of Design
Scott Carter
Associate, Senior Project Manager
Kris Piyaachariya
Senior Designer

Las Vegas
9075 West Diablo Drive, Suite 300
Las Vegas, NV 89148

Austin
1701 Directors Boulevard, Suite 770
Austin, TX 78744

kga.design

Volume Two | Property Condition Assessment



Volume Two | Property Condition Assessment

Executive Summary

In this volume, the project team, consisting of architects, civil, structural, mechanical, plumbing and electrical engineers, mechanical and electrical contractors, and an elevator consultant, provides findings and analysis which is the result of detailed investigation and consideration of the building's systems, their current condition, and their projected needs for repair, upgrade or replacement in order to keep the facility in operation through the target year of 2040.

The project team, in concert with State representatives from the Public Works Division with the Buildings and Grounds Section, has conducted a series of extensive facility visits and investigations which have covered a wide range of building systems and components.

Visual investigation of each system has been conducted at numerous locations throughout the building, and the resulting observations have been accounted for in the narratives, illustrations and drawings contained in Volume Two. Additionally, the prior knowledge provided in the form of several prior studies and tests, which have been conducted separately by the State Public Works Division, has been taken into account. This abundance of information allows for a deep understanding of the status and needs of the Grant Sawyer Building looking into the future.

The narratives, illustrations and drawings contained within Volume Two provide a thorough basis of understanding for the conceptual design and engineering recommendations and associated cost analysis which will follow in later sections of this study.

Volume Two | Contents Index

Civil Engineering Assessment

100

Structural Engineering Assessment

149

Mechanical, Plumbing and Electrical
Engineering Assessment

151

Elevator Assessment

193

Civil Engineering Assessment



T 702-365-9312 | F 702-365-9317
 6345 S Jones Blvd, Suite 100
 Las Vegas, NV 89118



CIVIL CONDITION ASSESSMENT REPORT

1.0 General Information

On October 17, 2018, Lochsa Engineering reviewed the subject site located at 555 East Washington Avenue, Las Vegas, Nevada. Record drawings were also reviewed and compared to field conditions.

Identified as APN 139-26-201-012, the property is located at the northeast corner of North Las Vegas Boulevard and East Washington Avenue, Las Vegas, Nevada. It covers approximately 22.77 acres.

Approximately 25 years ago, the site previously served as Lions Park. The property sits in the areas of the original Las Vegas Creek and was one of the original settlements within the Las Vegas Valley. Since the original construction of the Grant Sawyer office site, a Veteran's Memorial was constructed south of the building's main entrance, and a solar panel farm was installed on the east side of the site near Fantasy Lane. Other than these site modifications, the remainder of the site appears unchanged.

John Youngberg from the State Facilities Staff escorted Lochsa staff and provided information on problem areas and site maintenance known to him.

2.0 Drainage and Grading

The site appears to drain well during storm events and few obvious ponding areas were observed. Primary roof drains appear to connect to underground storm drain pipes and are directed away from the building. The west plaza area drainage is collected, directed north, then east, through and with the truck dock drainage to a large storm drain pump station just east of the dock. From there the water is pumped up to the east to a surface gutter north of the northeast corner of the building. From there, runoff flows east then southeast toward Washington Avenue. The south and east sides of the site drain south and east as well. All runoff originating from the site drains to Washington Avenue and its underground storm drain facilities. Note that the original design at the southeast side of the building showed a combination of primary roof drains from three locations combining and outletting at one point to a south curb face. It appears that the primary roof drains do not combine but outlet through three separate curb face outlets. These appear to function adequately. Maintenance and clean up appears to be very good with all area drains clean and open and very little silt, debris, leaves or trash was observed.

All storm facilities appear to function adequately except the valley gutter crossing the access gate controlled southeast driveway. The original design was for all site runoff to flow on the surface via a 5-foot wide valley gutter east through the Fantasy Park area then south to an existing drop inlet along the north side of Washington Avenue at the southeast corner of the site. At some point in time, it appears an 8-inch diameter steel pipe was placed on the bottom of the 5-foot valley gutter and was covered with fill material. This appears to create a ponding condition on the valley gutter crossing this driveway. While the site may generate over sixty six (66) cubic feet per second of runoff volume during a 100-year storm event, it is doubtful the 8-inch pipe can convey any more than one (1) cubic foot per second of flow. This creates a ponding situation that slowly drains and appears to create the need for excess maintenance. It is our recommendation to remove the pipe and to clean the valley gutter of all fill and debris along the length of the parking lot to the back of the Washington Avenue drop inlet.

The future Fleet Maintenance Facility should not impact the Sawyer drainage conditions.

Future expansion of the Sawyer building appears to be something that can be accomplished with limited impact to existing conditions. This is dependent on location and size. Locating any expansion on the west side of the site could be challenging due to slopes and grade differences. It should be noted that underlying soils below improvements installed as a part of the Grant Sawyer office site may require modifications and improvements for future structures. Ground water levels should also be measured and elevation fluctuations determined for future design considerations since this area is known to have shallow ground water.

The property is covered by the Federal Emergency Management Agency (FEMA) and Flood Insurance Rate Map (FIRM) for the Clark County, Nevada and incorporated areas, Community Panel Number: 32003C2170F, effective date: November 16, 2011. The majority of the project site is located within a FEMA Shaded Zone X defined as: "Areas of 0.2% annual chance flood; areas of 1% annual chance flood with average depths of less than 1 foot or with drainage areas less than 1 square mile; and areas protected by levees from the 1% annual chance flood." The remaining project site area is located within a FEMA Zone X (unshaded), defined as: "Areas determined to be outside the 0.2% annual chance floodplain." The FEMA Flood Insurance Rate Map is included in the attachments.

3.0 Utilities

Water service to the site is provided by two 8-inch by 2-inch combined fire/domestic meters. One is located at the northwest corner of the site and one at the northeast corner of the site. These meters are somewhat outdated and may need to be replaced at some point in time since parts for these sort of antiquated water meters become scarcer. They are no longer allowed or produced. The backflow preventers behind each meter are detector check valves and may need to be replaced with current standard reduced pressure backflow devices at some point in time. If Las Vegas Valley Water District (LVVWD) has not notified the need to replace these items, it may be required as a part of any expansion.

Onsite combined fire and domestic waterlines are 8-inch in size and loop around the building. All located valves and hydrants appear to be built per plans. A designed gate valve near the southeast building corner was not located. The fire hydrant northeast of the dock appears to have been moved west to accommodate a parking expansion area. This hydrant may be more than 100-feet away from the Fire Department connection located on the north side of the fire pump building. A fire hydrant south of the southwest corner of the building and east of the Veteran's Memorial may not be accessible by fire fighting vehicles. All gate valves designed near this hydrant were not located. Static water pressure on site is estimated to be approximately 40 psi.

Site sewer exits the site via an 8-inch on-site main at the southwest corner of the site out to Washington Avenue. We are not aware of any site sewer problems with this main. We are aware that a grease line was recently replaced through the west side of the building. Three previously designed cleanouts on the south side of the building were not located in the field. The 8-inch onsite sewer main should be of adequate size to accept future flow for reasonable expansions.

Dry utilities appear to enter the building on the north side and appear to originate along Las Vegas Boulevard or Fantasy Lane. Capacities are unknown at this time.

4.0 Hardscape

Existing exterior concrete (curbs, gutters, sidewalks) appear to be in good condition with no apparent failures and minimal cracking. Drainage under sidewalks and through curbs appears satisfactory.

The site asphalt appears to be in fair condition for its age. Some cracking and slow draining areas were observed but failure was not. Regular asphalt maintenance should occur every five ± years for a maximum life extension. This maintenance should include heavy crack sealing with a thick asphalt material and slurry seal with a thinner emulsion. Restriping will also be required during this maintenance and as warranted.

5.0 Summary

The site appears to have aged quite well. We assume this can be attributed to adequate initial design and construction as well as persistent and comprehensive maintenance. Minor site issues were observed and expansion opportunities appear to exist.

Attachments:

- Assessor's Parcel Map
- Assessor's Aerial Photo
- Assessor's Aerial Photo with 2' Contours
- Flood Insurance Rate Map
- City of Las Vegas Improvement Plans
- Improvement Plans with Review Walk Comments from 10/17/2018
- Photographs

ASSESSOR'S PARCEL MAP

NOTES

This map is for assessment use only and does NOT represent a survey.

No liability is assumed for the accuracy of the data delineated herein. Information on roads and other non-assessed parcels may be obtained from the Road Document Listing in the Assessor's Office.

This map is compiled from official records, including surveys and deeds, but only contains the information required for assessment. See the recorded documents for more detailed legal information.

USE THIS SCALE (FEET) WHEN MAP REDUCED FROM 11X17 ORIGINAL

ASSESSOR'S PARCELS - CLARK CO., NV.
Michele W. Shafe - Assessor

BOOK **T20S R61E**

125	124	12312
138	139	14014
163	162	16116

SEC. **26**

6	5	4	3	2	1
7	8	9	10	11	12
18	17	16	15	14	13
19	20	21	22	23	24
30	29	28	27	26	25
31	32	33	34	35	36


MAP **S 2 NW 4**

8	4	8	4
5	1	5	1
6	2	6	2
7	3	7	3
8	4	8	4
5	1	5	1


139-26-2

MAP LEGEND

—	PARCEL BOUNDARY	□	CONDOMINIUM UNIT	001	ROAD PARCEL NUMBER
- - -	SUB BOUNDARY	□	AIR SPACE PCL	001	PARCEL NUMBER
- - -	PM/LD BOUNDARY	□	RIGHT OF WAY PCL	1.00	ACREAGE
- - -	ROAD EASEMENT	□	SUB-SURFACE PCL	202	PARCEL SUB/SEQ NUMBER
- - -	MATCH / LEADER LINE			PB 24-45	PLAT RECORDING NUMBER
- - -	HISTORIC LOT LINE			5	BLOCK NUMBER
- - -	HISTORIC SUB BOUNDARY			5	LOT NUMBER
- - -	HISTORIC PM/LD BOUNDARY			GL5	GOV. LOT NUMBER
- - -	SECTION LINE				

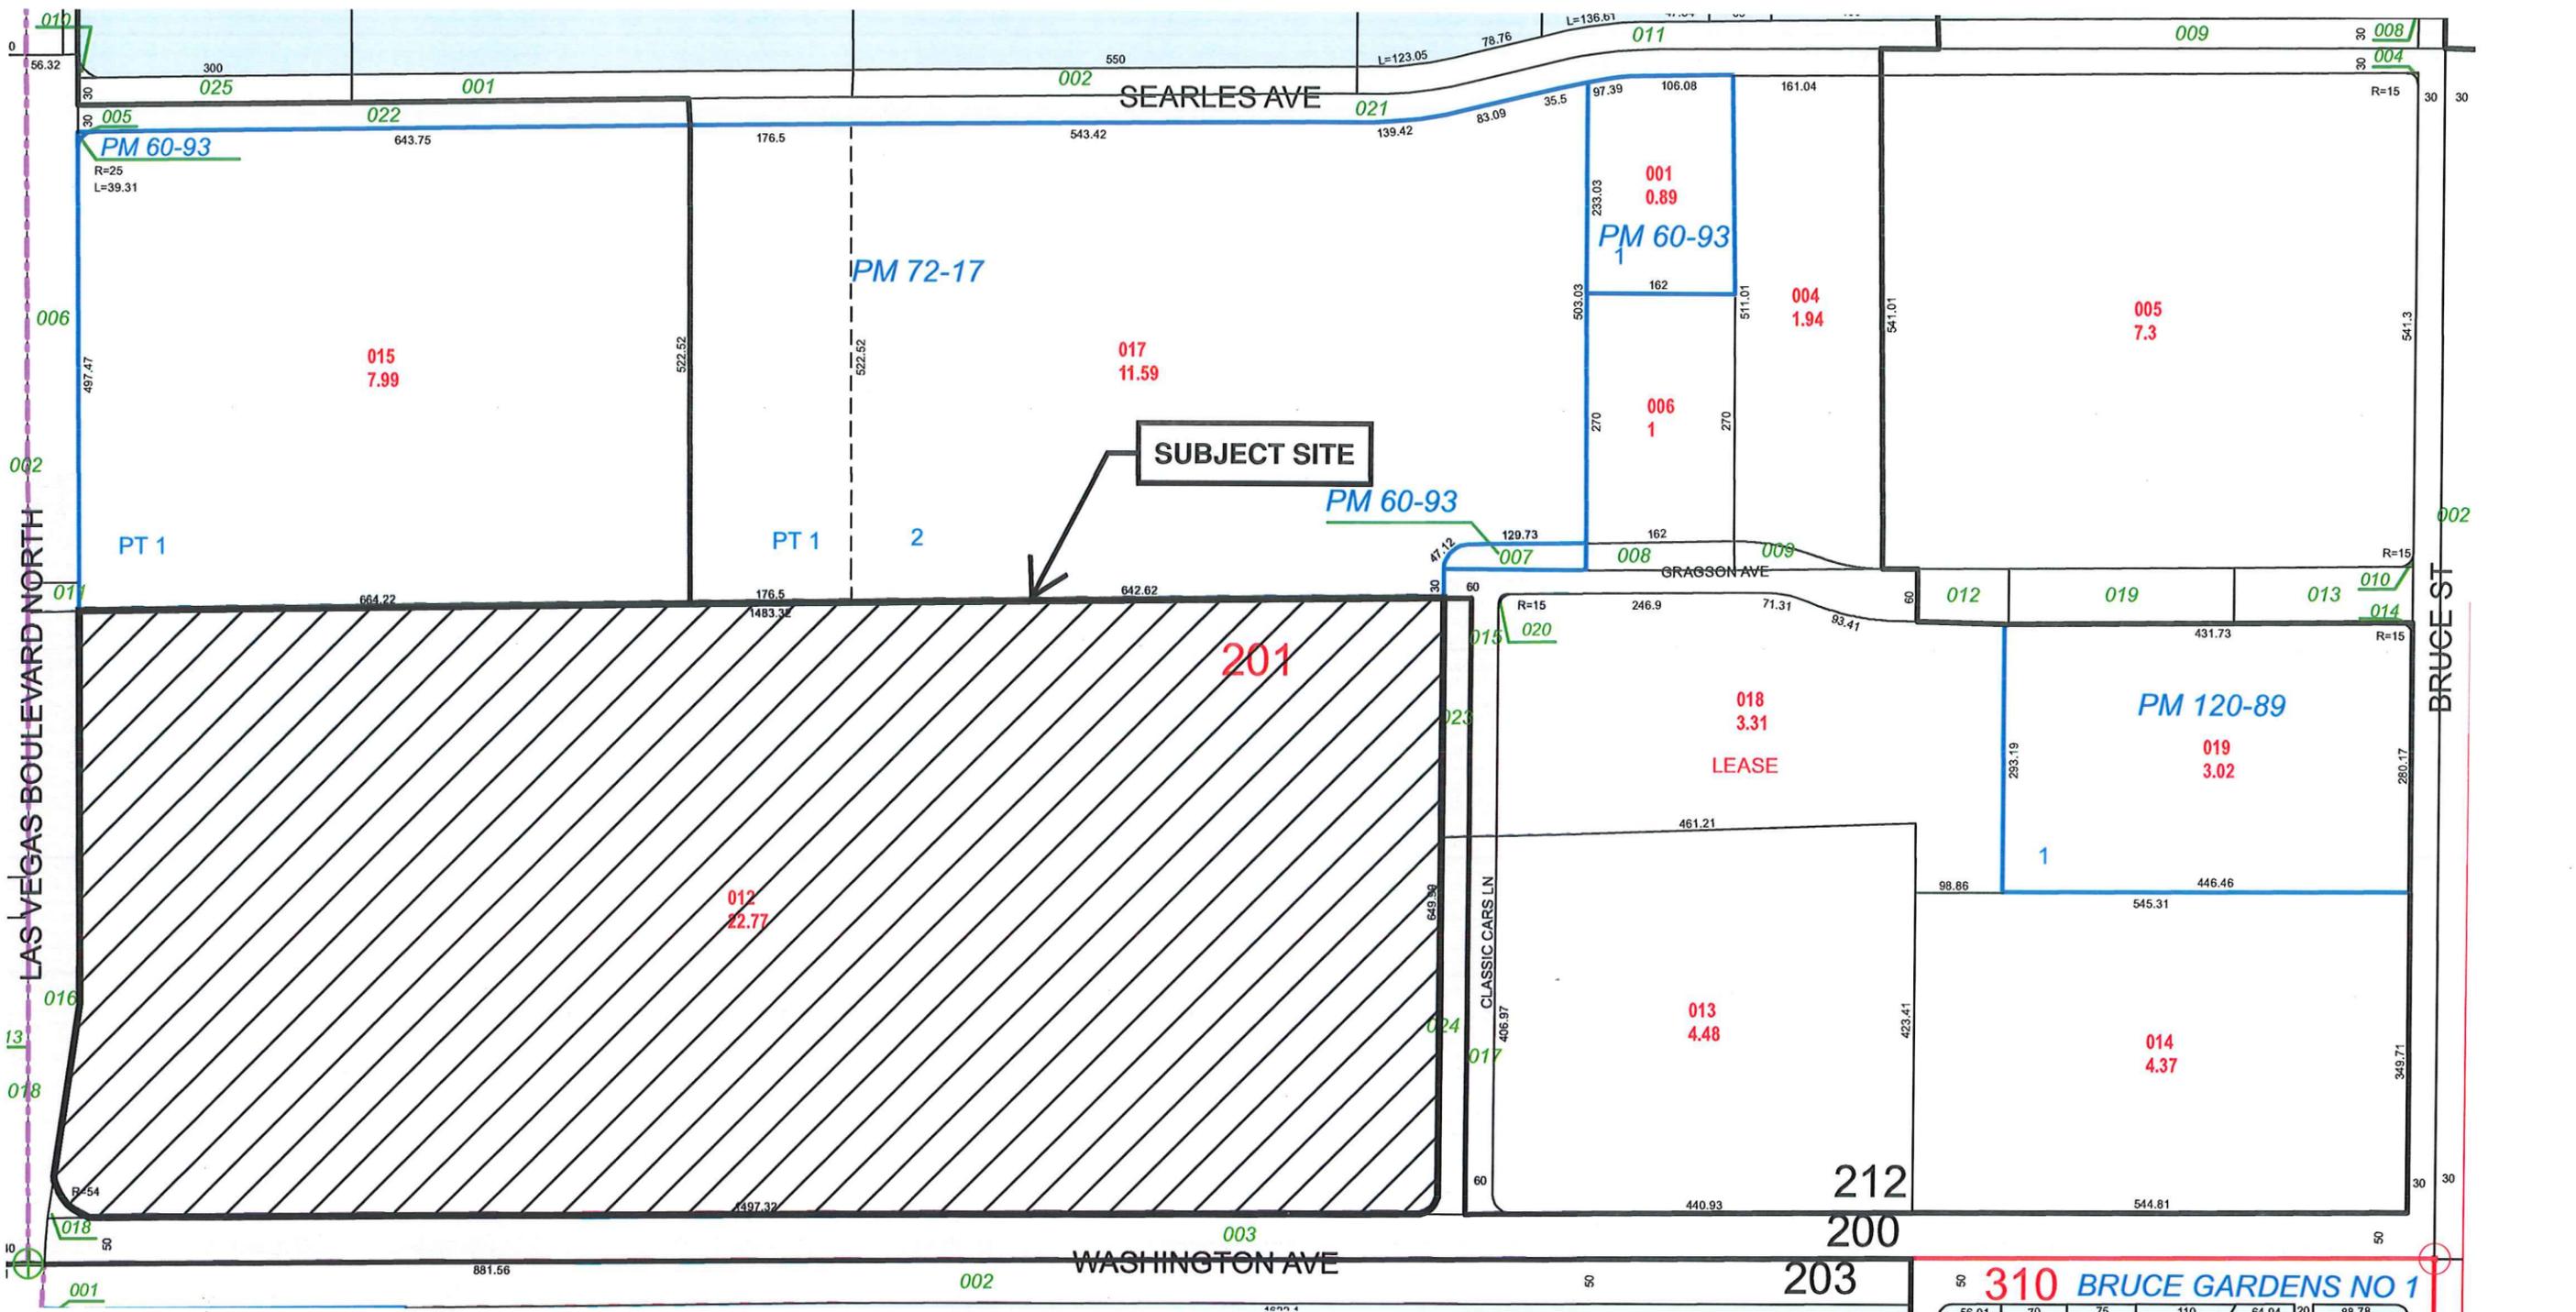

ASSESSOR'S AERIAL PHOTO

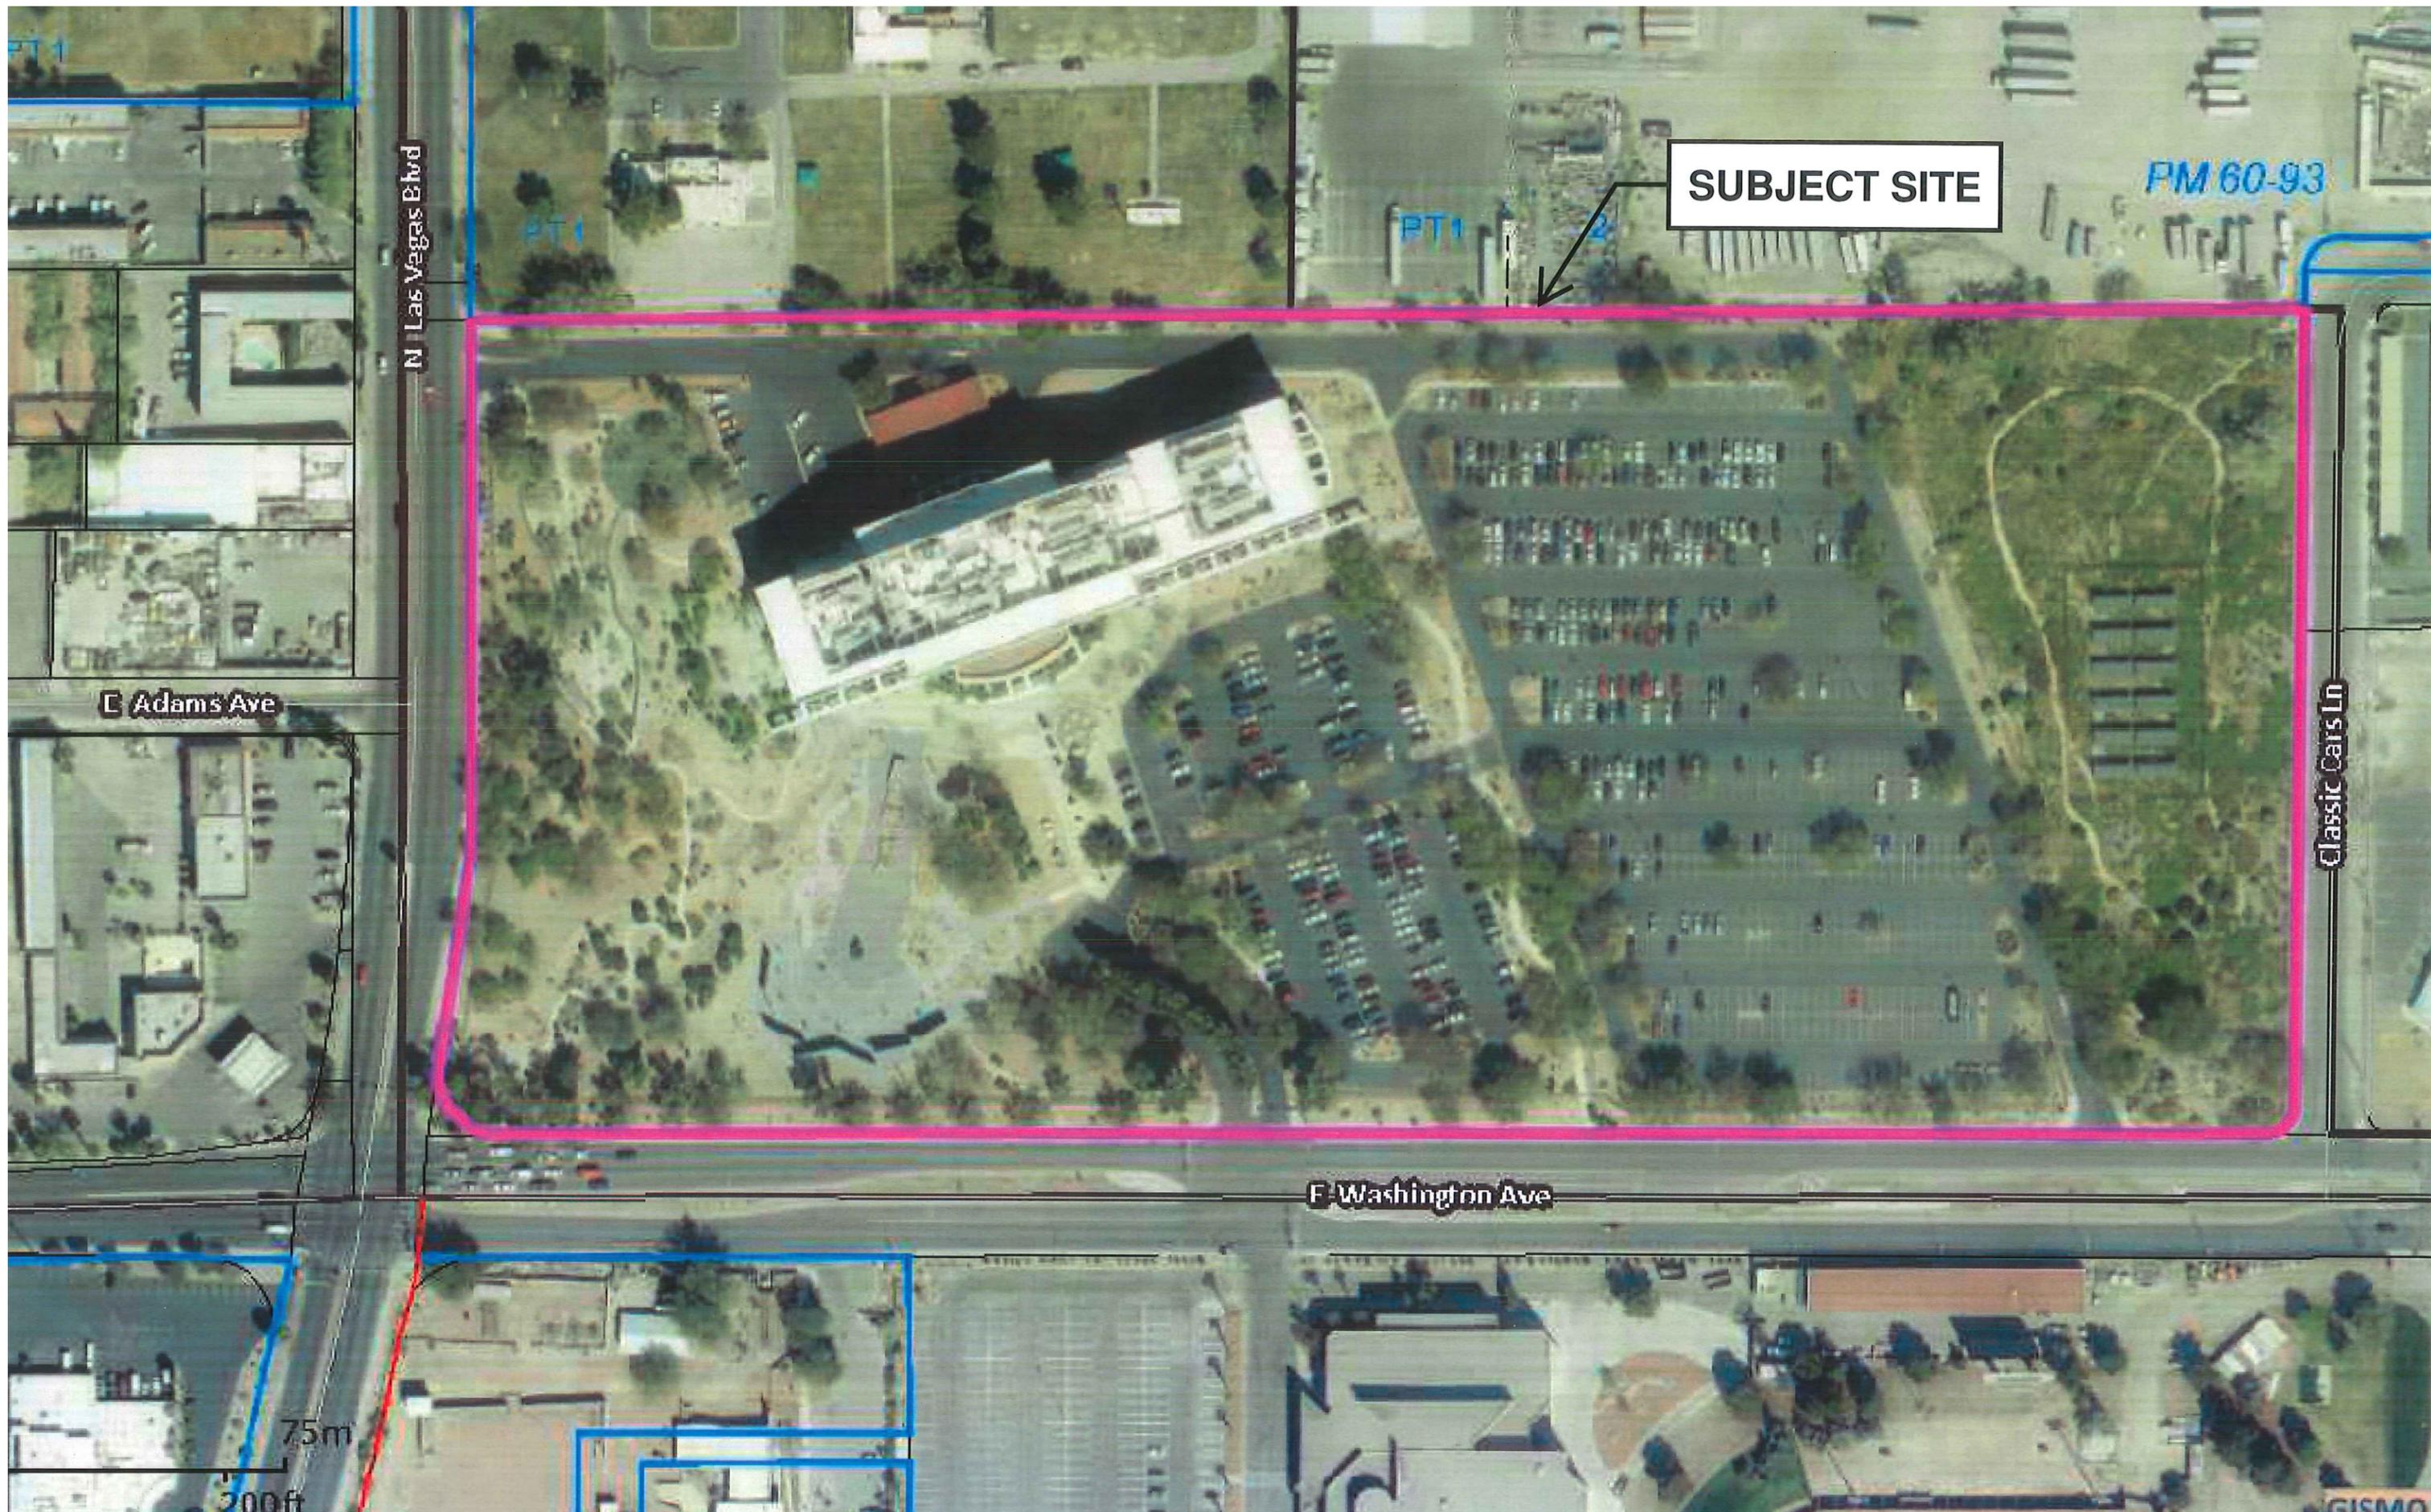

SUBJECT SITE

N Las Vegas Blvd

E Adams Ave

F Washington Ave

Classic Cars Ln

PM 60-93


PT1

75m

200ft



GISMO

ASSESSOR'S AERIAL PHOTO WITH 2' CONTOURS

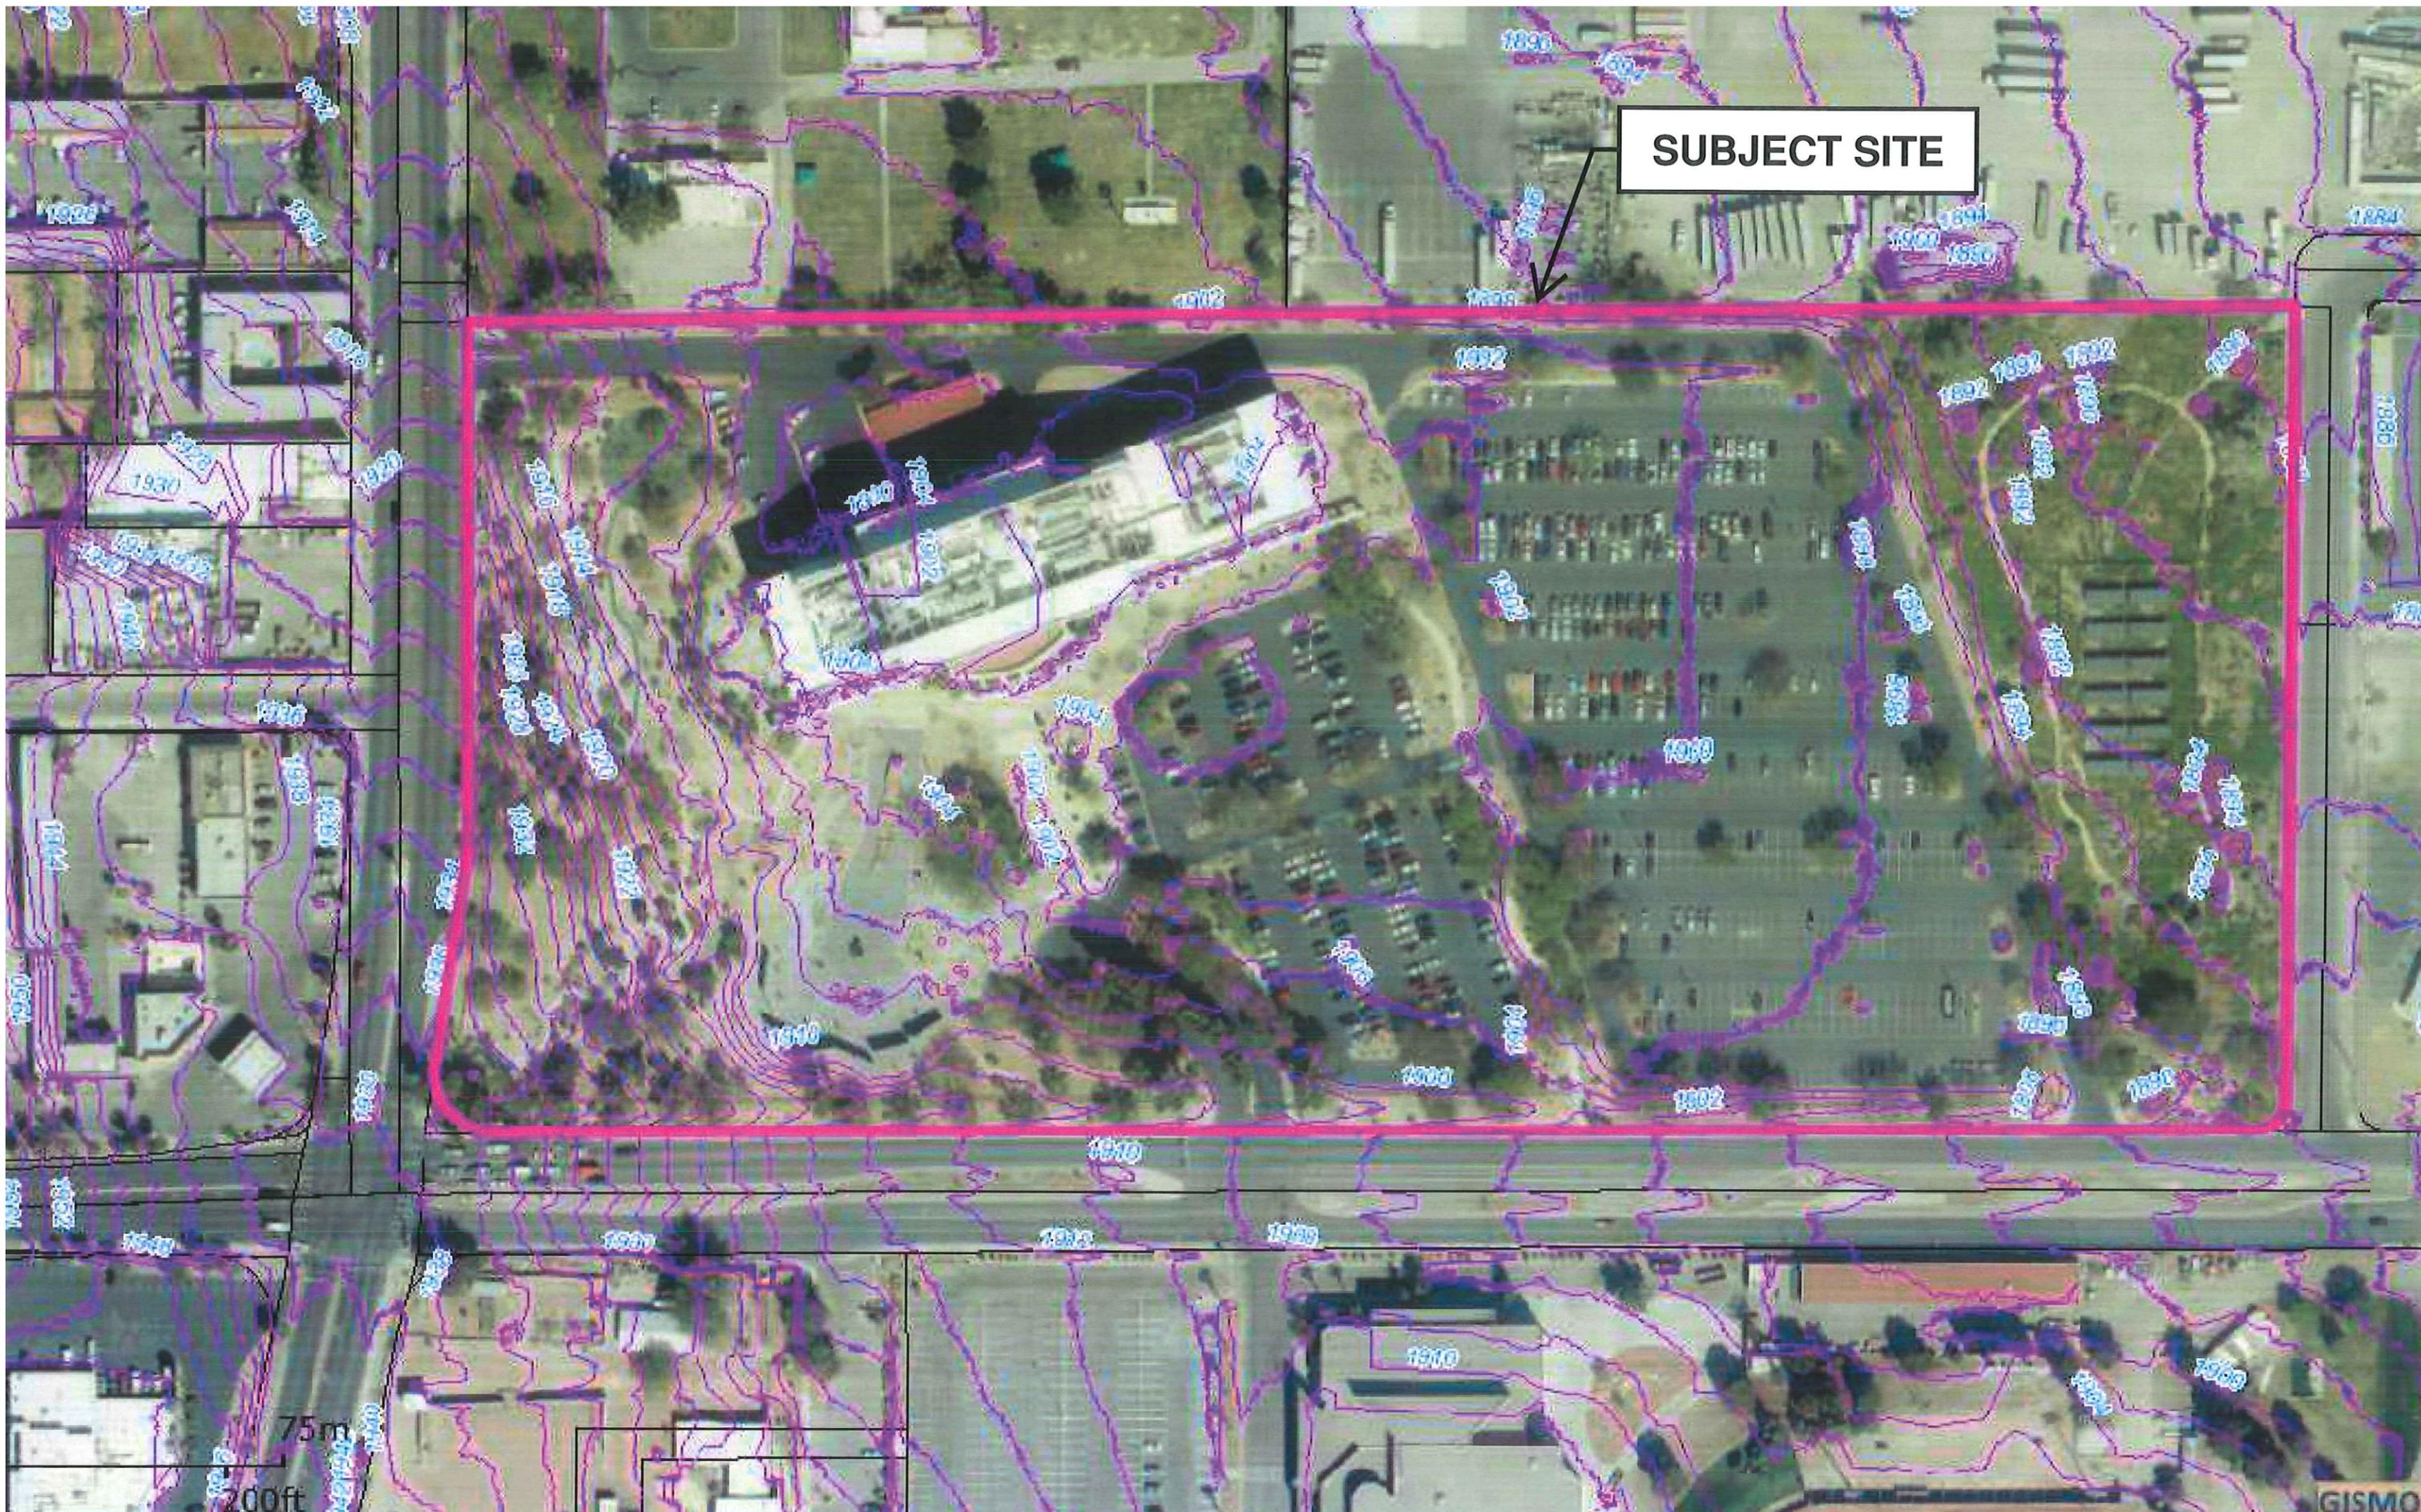

FLOOD INSURANCE RATE MAP

APN: 139-26-201-012

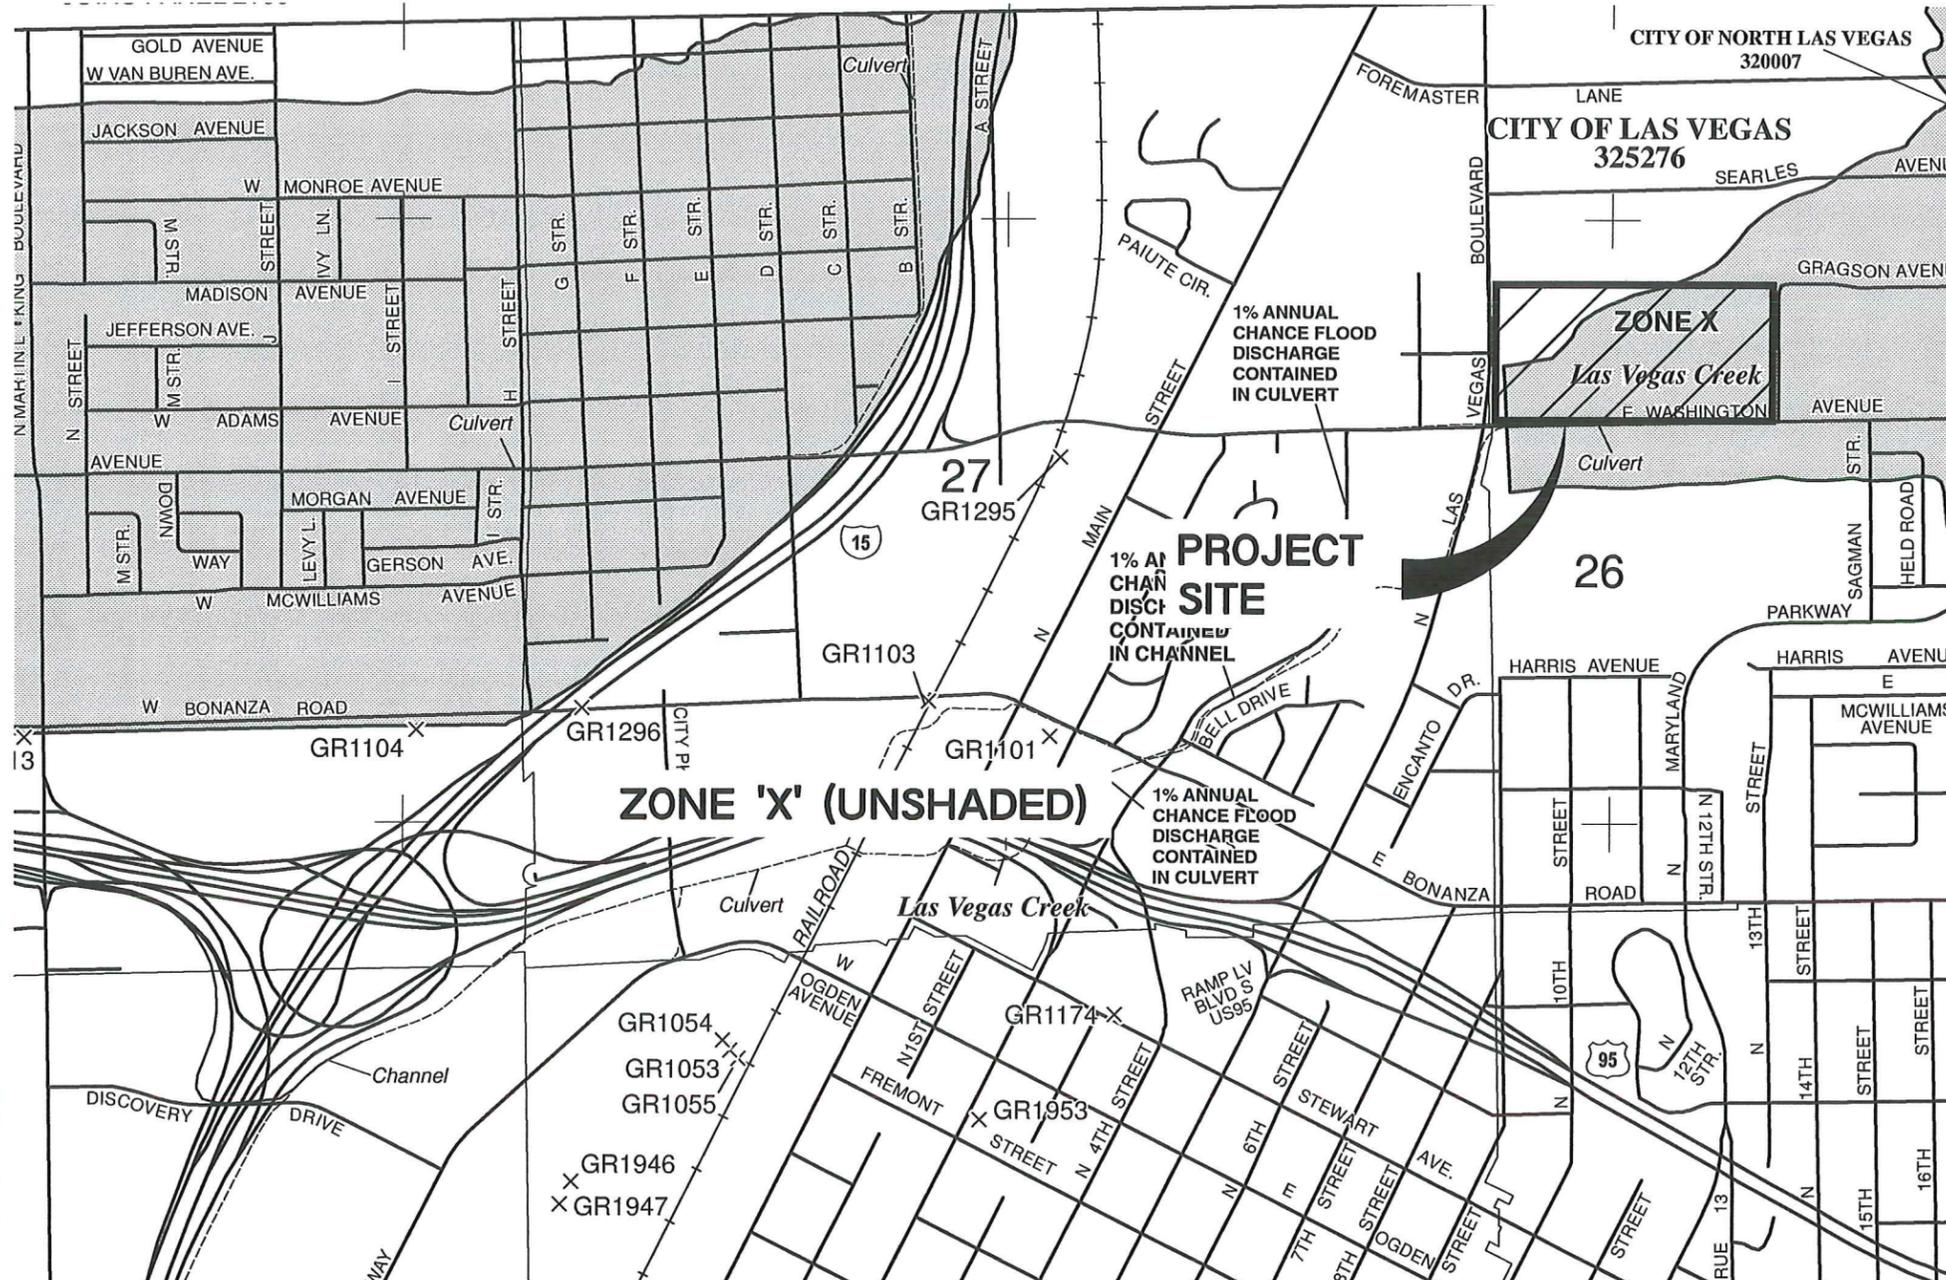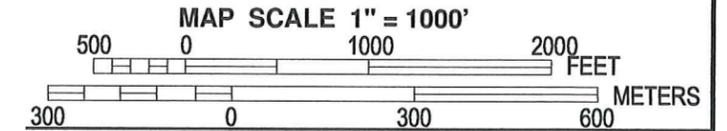

- LEGEND**
- SPECIAL FLOOD HAZARD AREAS (SFHAs) SUBJECT TO INUNDATION BY THE 1% ANNUAL CHANCE FLOOD
 - The 1% annual chance flood (100-year flood), also known as the base flood, is the flood that has a 1% chance of being equaled or exceeded in any given year. The Special Flood Hazard Area is the area subject to flooding by the 1% annual chance flood. Areas of Special Flood Hazard include Zones A, AE, AH, AO, AR, A99, V and VE. The Base Flood Elevation is the water-surface elevation of the 1% annual chance flood.
 - ZONE A** No Base Flood Elevations determined.
 - ZONE AE** Base Flood Elevations determined.
 - ZONE AH** Flood depths of 1 to 3 feet (usually areas of ponding); Base Flood Elevations determined.
 - ZONE AO** Flood depths of 1 to 3 feet (usually sheet flow on sloping terrain); average depths determined. For areas of alluvial fan flooding, velocities also determined.
 - ZONE AR** Special Flood Hazard Area formerly protected from the 1% annual chance flood by a flood control system that was subsequently discontinued. Zone AR indicates that the former flood control system is being restored to provide protection from the 1% annual chance or greater flood.
 - ZONE A99** Area to be protected from 1% annual chance flood by a Federal flood protection system under construction; no Base Flood Elevations determined.
 - ZONE V** Coastal flood zone with velocity hazard (wave action); no Base Flood Elevations determined.
 - ZONE VE** Coastal flood zone with velocity hazard (wave action); Base Flood Elevations determined.
 - FLOODWAY AREAS IN ZONE AE
 - The floodway is the channel of a stream plus any adjacent floodplain areas that must be kept free of encroachment so that the 1% annual chance flood can be carried without substantial increases in flood heights.
 - OTHER FLOOD AREAS
 - ZONE X** Areas of 0.2% annual chance flood; areas of 1% annual chance flood with average depths of less than 1 foot or with drainage areas less than 1 square mile; and areas protected by levees from 1% annual chance flood.
 - OTHER AREAS
 - ZONE X** Areas determined to be outside the 0.2% annual chance floodplain.
 - ZONE D** Areas in which flood hazards are undetermined, but possible.
 - COASTAL BARRIER RESOURCES SYSTEM (CBRS) AREAS
 - OTHERWISE PROTECTED AREAS (OPAs)
 - CBRS areas and OPAs are normally located within or adjacent to Special Flood Hazard Areas.
 - Floodplain boundary
 - Floodway boundary
 - Zone D boundary
 - CBRS and OPA boundary
 - Boundary dividing Special Flood Hazard Areas of different Base Flood Elevations, flood depths or flood velocities.
 - Base Flood Elevation line and value; elevation in feet*
 - Base Flood Elevation value where uniform within zone; elevation in feet*
 - * Referenced to the North American Vertical Datum of 1988 (NAVD 88)
 - Cross section line
 - Transect line
 - 97 9730', 32 92230'
 - 42 75 000" N
 - 6000000 FT
 - DX5510
 - M1.5
 - 1000-meter Universal Transverse Mercator grid ticks, zone 11
 - 5000-foot grid ticks: Nevada State Plane coordinate system, east zone (FIPS ZONE 2701), Transverse Mercator
 - Bench mark (see explanation in Notes to Users section of this FIRI panel)
 - River Mile

PANEL 2170F

FIRM
FLOOD INSURANCE RATE MAP
CLARK COUNTY,
NEVADA
AND INCORPORATED AREAS

PANEL 2170 OF 4090
(SEE MAP INDEX FOR FIRM PANEL LAYOUT)

CONTAINS:	COMMUNITY	NUMBER	PANEL	SUFFIX
CLARK COUNTY		32003	2170	F
LAS VEGAS, CITY OF		32526	2170	F
NORTH LAS VEGAS, CITY OF		32007	2170	F

Notice to User: The Map Number shown below should be used when placing map orders; the Community Number shown above should be used on insurance applications for the subject community.

MAP NUMBER
32003C2170F
MAP REVISED
NOVEMBER 16, 2011

Federal Emergency Management Agency

DRAWN BY: JMD SCALE: 1"=1000' FILE NAME: C-181155-FIRM.dwg

CHECKED BY: MLH DATE: 10/31/18

LOCHSA ENGINEERING
6345 SOUTH JONES BLVD., SUITE 100
LAS VEGAS, NV 89118
P: 702 365-9312, F: 702 365-9317

FLOOD INSURANCE RATE MAP

THE GRANT SAWYER OFFICE SITE
555 E. WASHINGTON AVENUE

PROJECT No.:
181155

SHEET No.

FIRM
SHEET 1 OF 1

CITY OF LAS VEGAS RECORD IMPROVEMENT PLANS FOR THE GRANT SAWYER OFFICE SITE



2770 SOUTH MARLYND PARKWAY SUITE 510 LAS VEGAS, NEVADA 89109 (702) 733-7107



STATE OFFICE BUILDING

DEPARTMENT OF GENERAL SERVICES

SPWB JOB # 91-C9

MARTIN & MARTIN ENGINEERS MARTIN & MARTIN CIVIL ENGINEERS 1701 W. CHARLESTON BLVD. SUITE 400 LAS VEGAS, NEVADA 89102 PHONE (702) 389-8008



Check and verify all dimensions and report all errors to the Architect prior to construction work. These drawings are not to be used for any other project without the written consent of the Architect. No part of these drawings shall be reproduced or transmitted in any form or by any means, electronic, mechanical, photocopying, recording, or by any information storage and retrieval system, without the prior written permission of the Architect. Copyright © 1993 by Martin & Martin, Inc. All rights reserved.

Date: FEBRUARY 23, 1993 Project No: 91-C9 Scale: Drawn By: R. YOUNG Revisions:

Sheet Title:

COVER AND APPROVAL SHEET


Sheet Number: 1 of 11

C1.01

ABBREVIATIONS table with columns for abbreviations and full names of construction terms like ASPHALTIC CONCRETE, ARRESTOR ELEMENT PIPE, etc.

SHEET INDEX table listing sheet numbers and titles such as C1.01 COVER AND APPROVAL SHEET, C2.01 DEMOLITION PLAN, etc.

GENERAL NOTES section containing 17 numbered notes regarding construction standards, utility lines, and safety protocols.

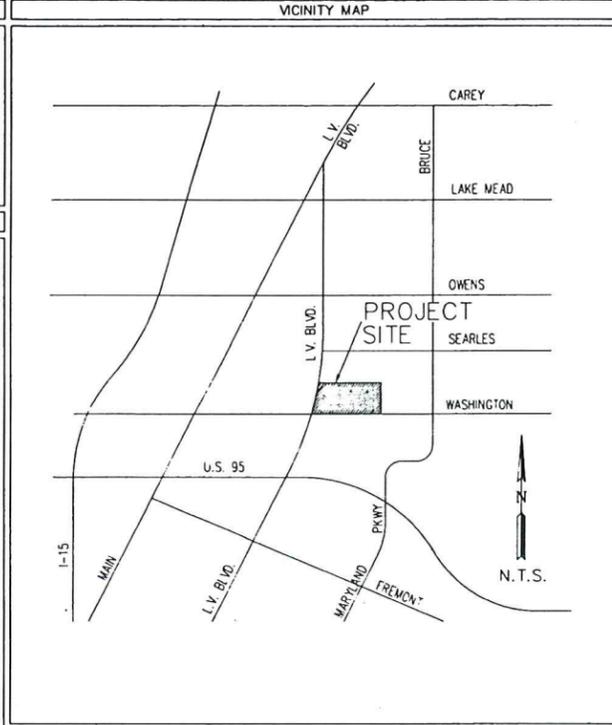

SYMBOLS LEGEND table defining symbols for existing and proposed features like RIGHT-OF-WAY, CENTERLINE, WATER LINE, etc.

APPROVALS section with signatures and dates for Central Telephone Company, Southwest Gas Company, Nevada Power Company, and City Engineer Dennis Anderson.

EXISTING PROPOSED	
—	RIGHT-OF-WAY
—	CONCRETE
—	WATER LINE
—	SANITARY SEWER LINE
—	GAS LINE
—	STORM DRAIN
—	POWER LINE / POWER POLE
—	TELEPHONE LINE
—	FIRE HYDRANT
—	WATER VALVE
—	METERS / MALL BOXES
—	RENDER
—	MANHOLE
—	CLEANOUT
—	STREET LIGHT
—	EXIST. ON-SITE AREA LIGHT
—	HANDRAIL
—	SCREEN / RETAINING WALL
—	WIRE OR CHAIN LINK FENCE
—	BRUSH ENCLOSURE
—	GRADE BREAK
—	CONTOUR LINE
—	FINISH FLOOR
—	CLEARANCE INVERT ELEVATION
—	C.C. R.Y.
—	FLOW LINE
—	FINISH GRADE
—	BACK OF SIDEWALK
—	TOP OF CURB
—	TOP OF WALL
—	A.C. PAVING
—	TYPE 'L' CURB & OUTER
—	TYPE 'A' CURB
—	R.O. ROOF DRAIN
—	ENG. RETAINING WALL
—	FREELANE DESIGNATION


BENCHMARK
 THE BENCHMARK FOR THIS PROJECT IS C.C.E.O. BENCHMARK NO. 7C012355W6; BEING AN ALUMINUM PLATE AND RIVET ON THE TOP OF THE CURB, NORTHEAST QUADRANT OWENS AND LAS VEGAS BLVD. NORTH. ELEVATION = 1897.81

MARTIN & MARTIN ASSUMES NO RESPONSIBILITY FOR EXISTING UTILITY LOCATIONS. THE UTILITIES SHOWN ON THIS DRAWING HAVE BEEN PLOTTED FROM THE BEST AVAILABLE INFORMATION. IT IS, HOWEVER, THE CONTRACTORS RESPONSIBILITY TO FIELD VERIFY THE LOCATION OF ALL UTILITIES PRIOR TO THE COMMENCEMENT OF ANY CONSTRUCTION. CONTRACTOR TO FIELD VERIFY ALL EXISTING SITE CONDITIONS PRIOR TO CONSTRUCTION. IF A CONFLICT EXISTS BETWEEN WHAT IS SHOWN ON THESE DRAWINGS AND WHAT EXISTS IN THE FIELD, THE CONTRACTOR IS TO NOTIFY THE ARCHITECT OR ENGINEER IMMEDIATELY.


DISTURBED (SANDY AND SILTY MATERIALS), SHOULD BE PROTECTED WITH BURLAP OR OTHER EROSION CONTROL FABRIC/MATERIAL, UNLESS OTHERWISE SPECIFIED BY LANDSCAPE DRAWINGS AND SPECIFICATIONS, OR THE SOILS REPORT.

CONTRACTOR SHALL DETERMINE HIS OWN FOOTING OR BASEMENT EXCAVATION QUANTITIES, EVEN THOUGH SHOWN ON ROUGH GRADING PLANS. ADDITIONALLY, STRUCTURE BACKFILL COSTS SHOULD BE INCLUDED IN THE COST OF THE STRUCTURE, UNLESS OTHERWISE SPECIFIED IN THE CONTRACT DOCUMENTS.


CONTRACTOR SHALL NOTIFY MARTIN & MARTIN WITHIN 24 HOURS OF OMISSIONS AND ERRORS DISCOVERED ON PLANS. MARTIN & MARTIN WILL REVISE AND RE-ISSUE DRAWINGS AS SOON AS POSSIBLE. MARTIN & MARTIN WILL NOT BE RESPONSIBLE FOR ANY "CORRECTIVE" WORK DONE BY OTHERS.

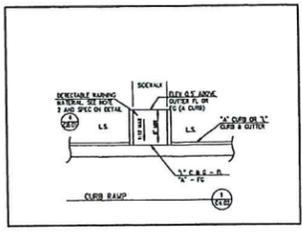

1. REMOVE EXIST. DWY. & REPLACE W/ 'L' C&G
 2. REMOVE AND REPLACE DAMAGED 'L' CURB
 3. 5' DEPRESSED CURB SECTION. DEPRESSED TO ALLOW POSITIVE DRAINAGE WITH NO PONDING ALLOWED
- NOTE:
 1. ALL REMOVED AND REPLACED C&G LENGTHS ARE APPROXIMATE.
 2. N.D.O.T. OWNERSHIP IS TO BACK OF SIDEWALK ALONG L.V. BLVD.
 3. ADJUST ALL PULLBOXES, SIGNAL BOXES, ECT. TO TOP OF S.W. ELEV.
 4. REFER TO DESIGN LEVEL GEOTECHNICAL INVESTIGATION BY CONVERSE CONSULTANTS INC. PROJECT NO. 91-31402-02 DATED MAY 26, 1992 FOR ALL GRADING AND COMPACTION RECOMMENDATIONS.

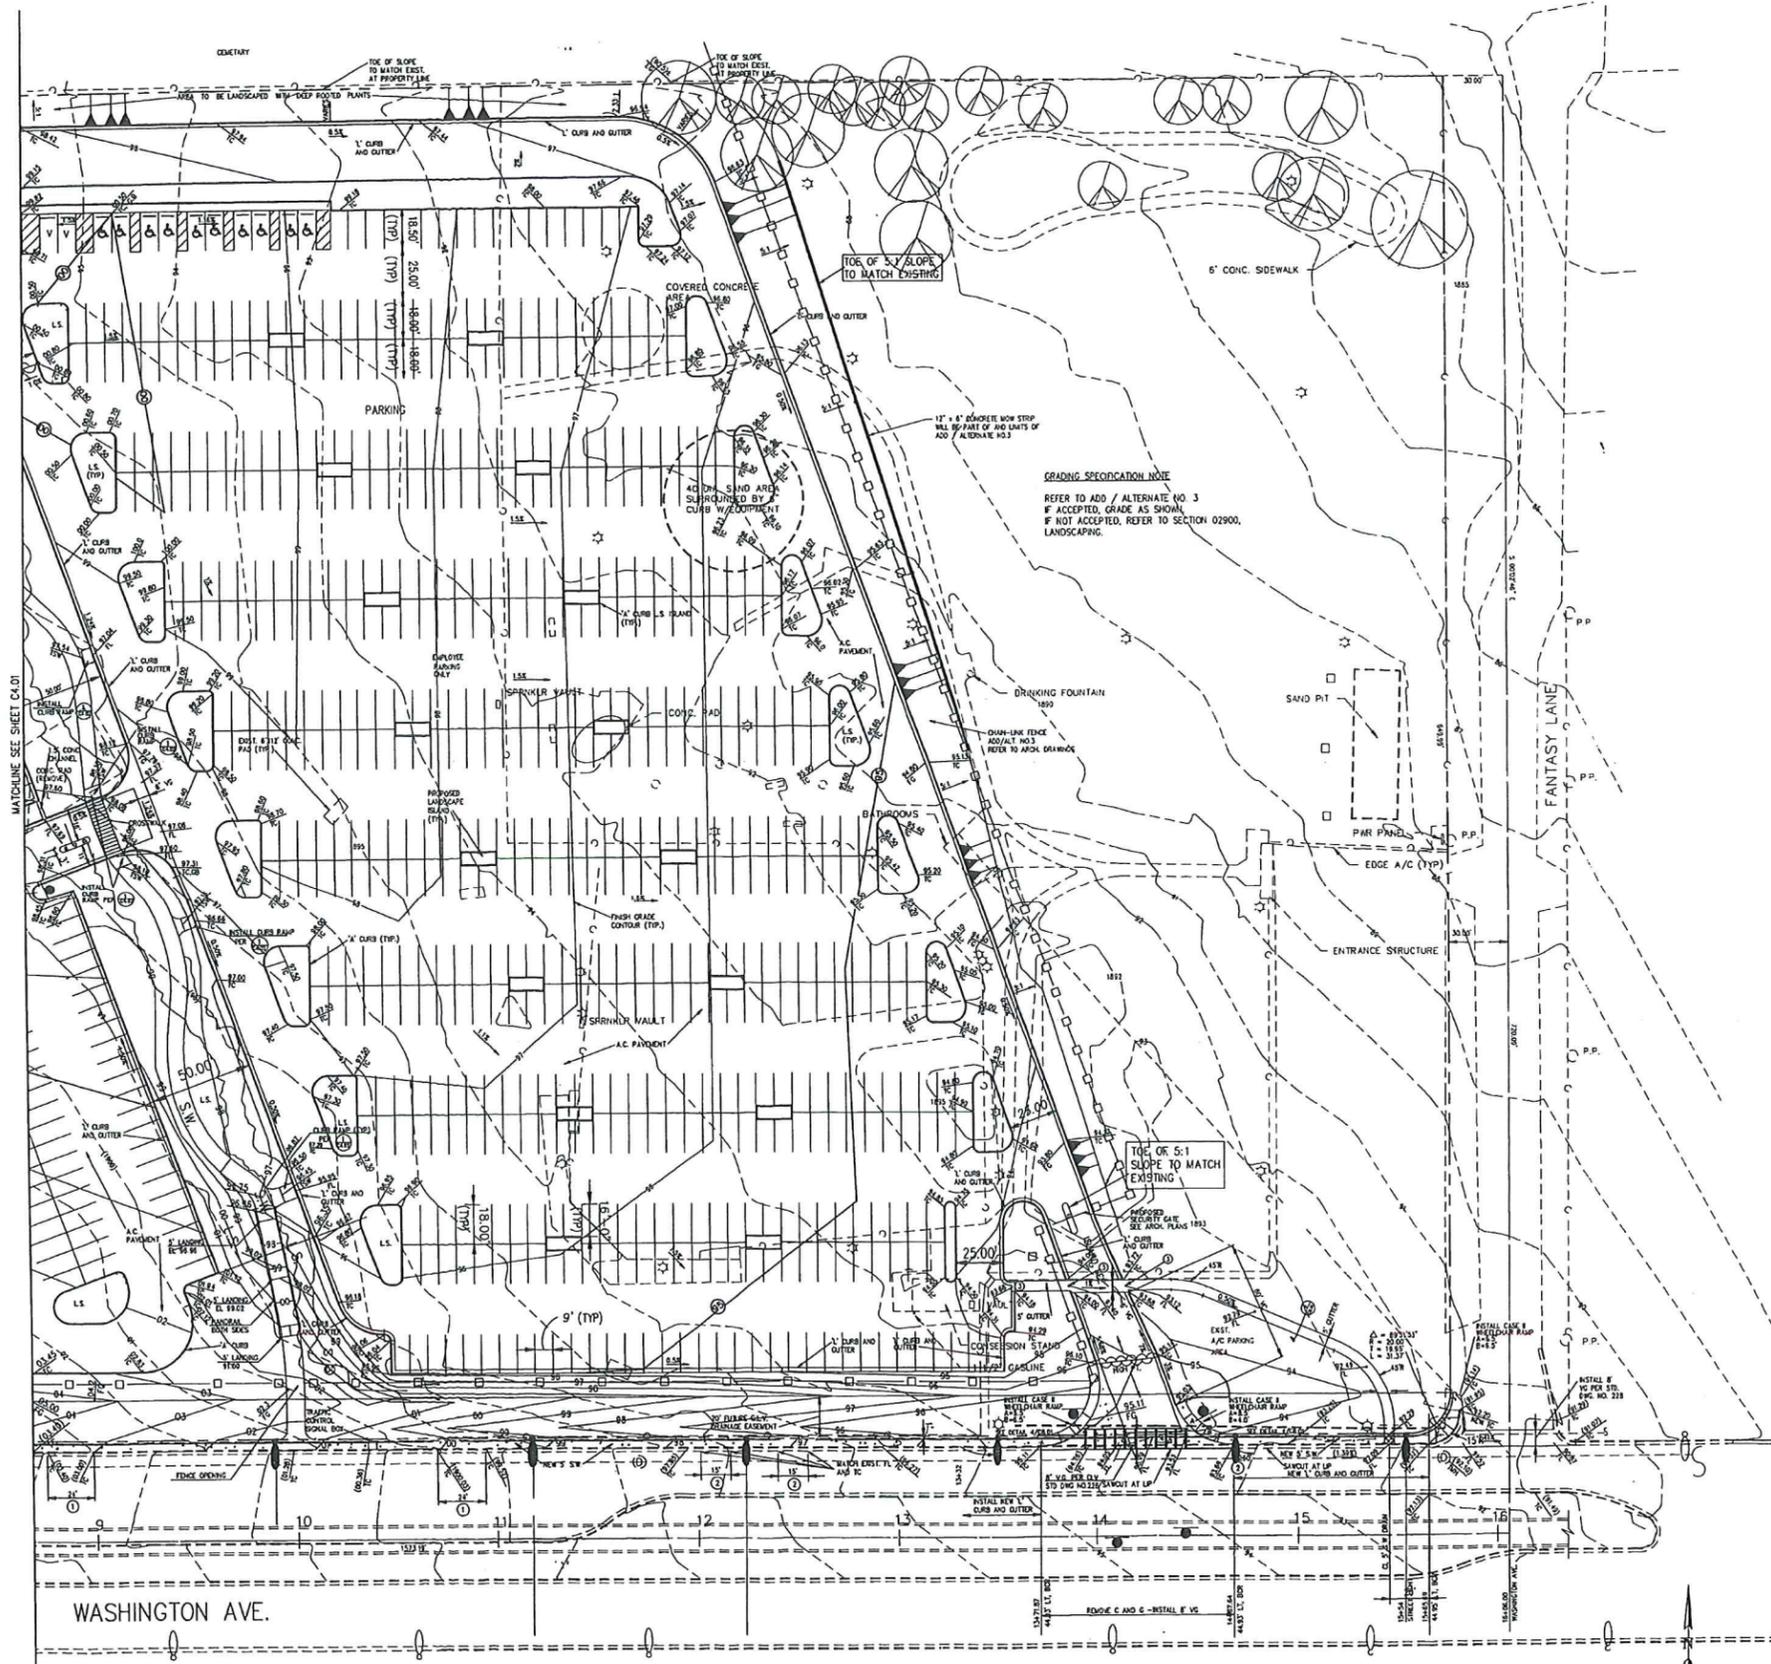

GRADING SPECIFICATION NOTE
 REFER TO ADD / ALTERNATE (NO. 3) IF ACCEPTED, GRADE AS SHOWN. IF NOT ACCEPTED, REFER TO SECTION 02900, LANDSCAPING.

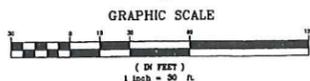

LUCCHESI GALATI ARCHITECTS
 2770 SOUTH MARYLAND PARKWAY
 SUITE 510
 LAS VEGAS, NEVADA 89109
 (702) 733-7107

STATE OFFICE BUILDING
 DEPARTMENT OF GENERAL SERVICES
 SPWB JOB # 91-C9

MARTIN & MARTIN
 CIVIL ENGINEERS
 1705 W. CHARLESTON BLVD.
 SUITE 430
 LAS VEGAS, NEVADA 89102
 PHONE: (702) 388-0000



Check and verify all dimensions and report all errors to the architect prior to commencing work. These drawings are not to be used for any other project without the express written consent of the architect. No part of these drawings shall be reproduced or transmitted in any form or by any means, electronic, mechanical, photocopying, recording, or by any information storage and retrieval system, without the prior written consent of the architect. Copyright 1993, Lucchese Galati Architects, Inc. A Nevada Corporation.

Date: FEBRUARY 23, 1993
 Project No.: 1098
 Scale: 1"=30'
 Drawn By: R. YOUNG / C.H.
 Revisions:

Sheet Title:
 GRADING PLAN
 NO. 2, EAST

Sheet Number: 6 of 11

C4.02

107-V2105

10-2-87



2770 SOUTH MARYLAND PARKWAY SUITE 510 LAS VEGAS, NEVADA 89109 (702) 733-7107



STATE OFFICE BUILDING

DEPARTMENT OF GENERAL SERVICES

SPWB JOB # 91-C9

MARTIN & MARTIN ARCHITECTS



Check and verify all dimensions and report all errors to the architect prior to commencing work. These drawings are not to be used for any other project without the written consent of the architect...

Date: FEBRUY 23, 1993 Project No: 91-C9 Scale: AS SHOWN Drawn By: R. YOUNG Revisions:


Sheet Title:

OFF-SITE WATER PLAN

Sheet Number: 9 of 11

C6.01

107-V 2105

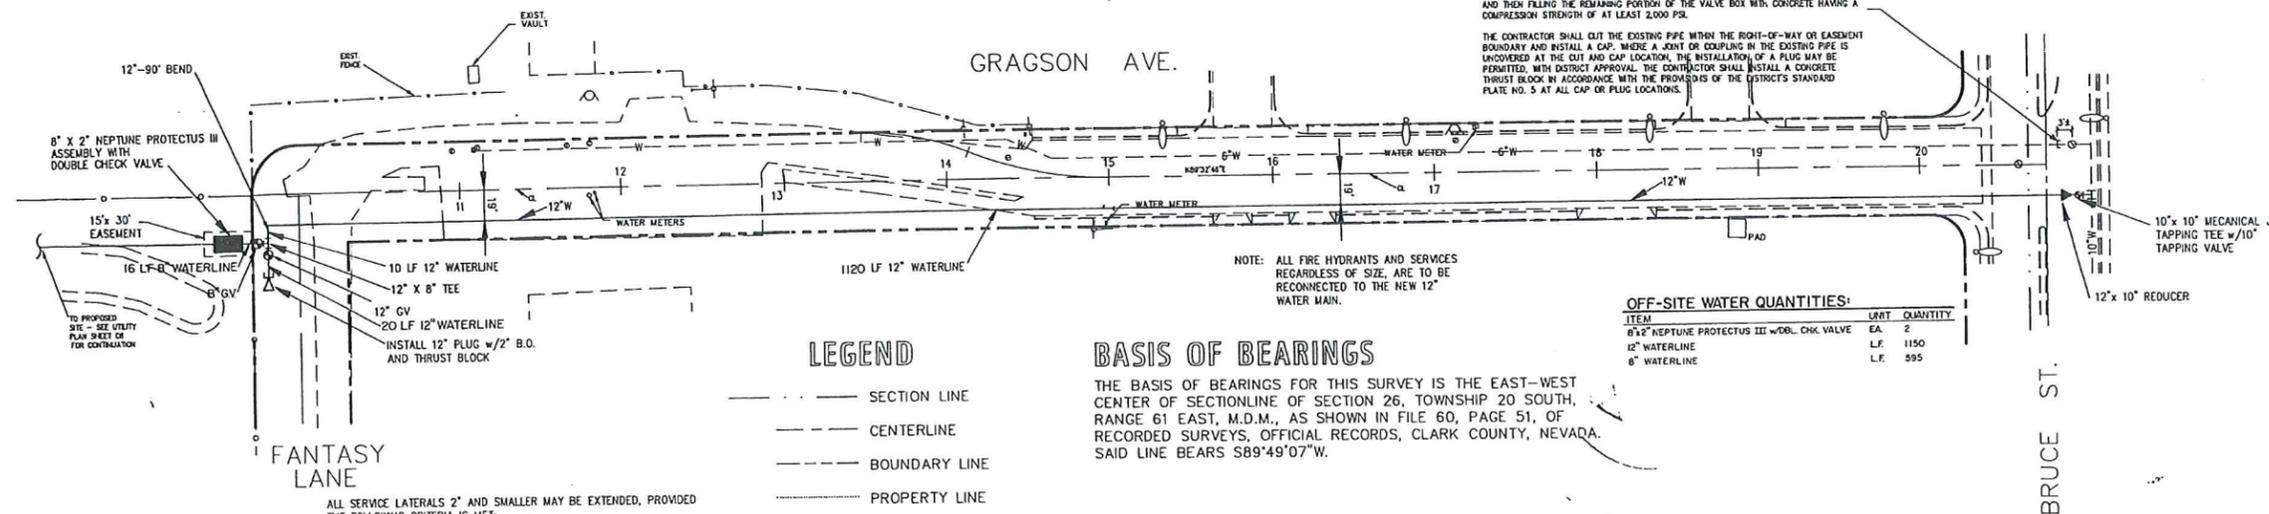

ALL VALVES TO BE ABANDONED SHALL BE ABANDONED IN THE CLOSED POSITION, UNLESS SHOWN OTHERWISE, BY REMOVING A PORTION OF THE TOP 12" OF THE VALVE BOX AND THEN FILLING THE REMAINING PORTION OF THE VALVE BOX WITH CONCRETE HAVING A COMPRESSION STRENGTH OF AT LEAST 2,000 PSI.

OFF-SITE WATER QUANTITIES table with columns for ITEM, UNIT, and QUANTITY.

BASIS OF BEARINGS

THE BASIS OF BEARINGS FOR THIS SURVEY IS THE EAST-WEST CENTER OF SECTIONLINE OF SECTION 26, TOWNSHIP 20 SOUTH, RANGE 61 EAST, M.D.M., AS SHOWN IN FILE 60, PAGE 51, OF RECORDED SURVEYS, OFFICIAL RECORDS, CLARK COUNTY, NEVADA. SAID LINE BEARS S89°49'07"W.

BENCHMARK

THE BENCHMARK FOR THIS SURVEY IS C.C.E.D. BENCHMARK # 7C0123SSW6, BEING AN ALUM. PLATE AND RIVET ON THE TOP OF CURB, NORTHEAST QUADRANT OWENS AND LAS VEGAS BLVD NORTH. ELEVATION: 1897.81'

LEGEND

- SECTION LINE, CENTERLINE, BOUNDARY LINE, PROPERTY LINE, AREA LIGHT, STREET LIGHT (EXIST.), FIRE HYDRANT (EXIST.), EXIST. FENCE

ALL SERVICE LATERALS 2" AND SMALLER MAY BE EXTENDED, PROVIDED THE FOLLOWING CRITERIA IS MET:

- 1. LATERAL CAN ONLY BE EXTENDED IF CONNECTING TO COPPER. LATERAL MUST BE INSTALLED AT 90 DEGREES TO MAIN. EXISTING SERVICE LATERAL THAT IS NOT COPPER AND IS TO BE ABANDONED FROM THE EXISTING WATER MAIN, SHALL HAVE THE CORPORATION STOP TURNED OFF AT THE MAIN, THE LATERAL CUT 6" DOWNSTREAM FROM THE CORPORATION STOP AND AGAIN CUT 6" DOWNSTREAM FROM THE FIRST CUT SO THAT A 6" PIECE OF THE EXISTING SERVICE LATERAL IS REMOVED...

LAS VEGAS VALLEY WATER DISTRICT NOTES

- 1. NO WORK SHALL BEGON ON THE WATER PLANS UNTIL THEY HAVE BEEN RELEASED FOR CONSTRUCTION BY THE LVWD. FOLLOWING APPROVAL OF THE PLANS, NOTICE SHALL BE GIVEN TO THE LVWD CUSTOMER SERVICE DEPARTMENT (870-4194) 48 HOURS PRIOR TO ACTUAL CONSTRUCTION, AND 24 HOURS PRIOR TO AN INSPECTION. 2. CALL BEFORE YOU DIG 1-800-227-2600. 3. ALL WORK SHALL CONFORM TO LVWD LATEST STANDARD PLATES, DRAWINGS, AND SPECIFICATIONS. 4. ALL WORK, EXCEPT AS MODIFIED HEREON OR BY NOTE 3, SHALL BE DONE IN ACCORDANCE WITH THE MOST CURRENT DRAFT OR ADDITION OF THE UNIFORM STANDARD SPECIFICATIONS FOR PUBLIC WORKS CONSTRUCTION...

Table with columns: PIPE SIZES, ACP, DUCTILE IRON SLIP JOINT, DUCTILE IRON MECHANICAL JOINT.



ON PVC PIPE, THE MAXIMUM OFFSET FOR A 20' LENGTH OF FACTORY BELLED PIPE SHALL BE 16 INCHES FOR 6" PIPE, 12 INCHES FOR 8" PIPE, AND 9 INCHES FOR 10" AND 12" PIPE.

IF THESE OFFSETS CONFLICT WITH THE PIPE MANUFACTURERS RECOMMENDATION, THE MORE STRINGENT REQUIREMENT SHALL APPLY.

- 8. ALL WATER METER BOXES SHALL BE LOCATED OUTSIDE OF DRIVEWAY AREAS. 9. ALL VALVES SHALL BE LOCATED OUTSIDE OF DRIVEWAYS AND VALLEY GUTTERS. 10. DETECTOR TAPE SHALL BE REQUIRED IN ACCORDANCE WITH STANDARD PLATE NO. 27 WHERE INDICATED, AND AS FOLLOWS: A) OVER ALL MAINS NOT INSTALLED 6 FEET FROM BACK OF CURB B) OVER ALL SERVICE LATERALS NOT INSTALLED AT RIGHT ANGLES TO MAIN. 11. ALL WATER MAINS SHALL BE PRESSURE TESTED AT 200 PSI FOR A CONTINUOUS TWO HOUR PERIOD, IN ACCORDANCE WITH DISTRICT STANDARDS. 12. ALL WATER MAINS SHALL BE DISINFECTED, FLUSHED, AND AN ACCEPTABLE HEALTH SAMPLE OBTAINED, PRIOR TO THE CONNECTION OF THE WATER MAIN(S) AND/OR LATERAL(S) TO THE DISTRICT'S SYSTEM. 13. CONTRACTOR TO OBTAIN ALL METERS 2" AND SMALLER FROM LVWD CENTRAL STORES. TELEPHONE 258-3152 FORTY-EIGHT (48) HOURS PRIOR TO PICKUP.

APPROVALS

FIRE FLOW = 2,500 David Brennan 3/12/93 C.C. FIRE DEPARTMENT (C.L.V.) DATE R. Young 4/15/93 LAS VEGAS VALLEY WATER DISTRICT DATE

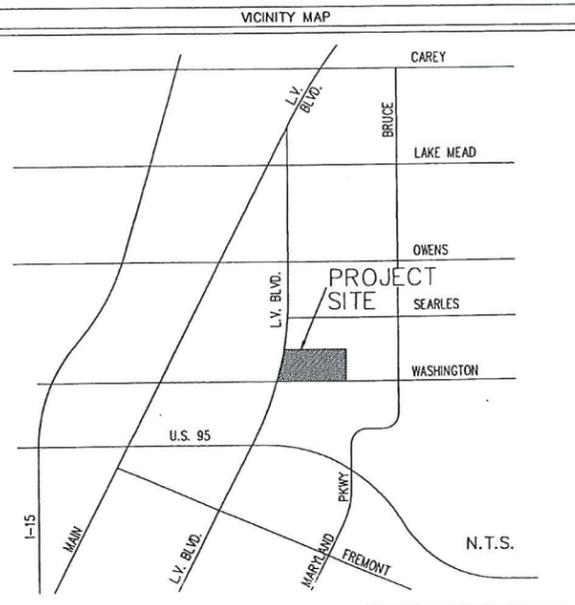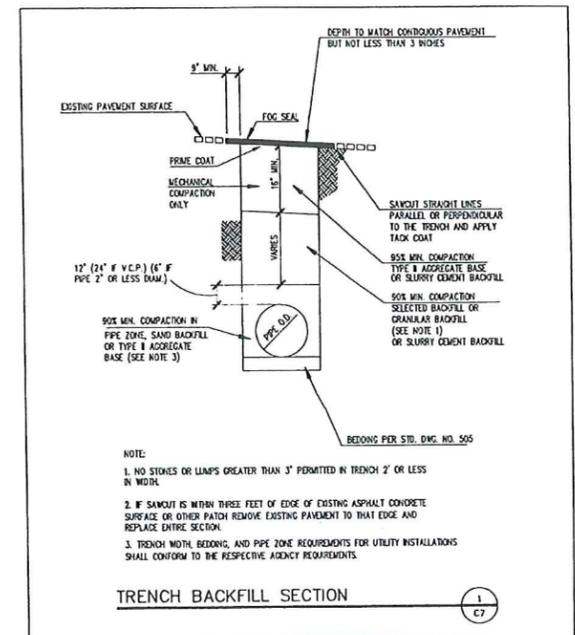

INSTALLATION OF METER AND VAULT

THE METER(S) AND VAULT(S) WITH NON-TRAFFIC BEARING COVER(S) SHALL BE INSTALLED IN ACCORDANCE WITH THE ATTACHED DETAIL AND WITH STANDARD VAULT DRAWING C-475, LATEST REVISION.

ANY BLOCK WALL OR OTHER FENCE MATERIAL SHALL BE DESIGNED AND CONSTRUCTED AROUND THE OUTSIDE OF THE EASEMENT(S), SO AS TO ALLOW THE DISTRICT DIRECT ACCESS TO THE VAULT(S) FROM THE ADJACENT RIGHT-OF-WAY.





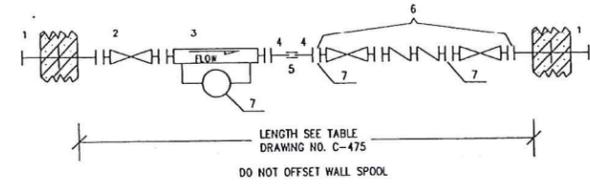


Table with columns: ITEM NO., DESCRIPTION, QTY. listing materials like flanged steel epoxy coated and lined wall spool, gate valve, etc.

NOTES: ALL PIPING, FITTINGS, AND APPURTENANCES SHALL CONFORM TO APPLICABLE DISTRICT SPECIFICATIONS.

THIS INSTALLATION IS FOR USE ONLY IN SYSTEMS HAVING ANOTHER SOURCE OF SUPPLY.

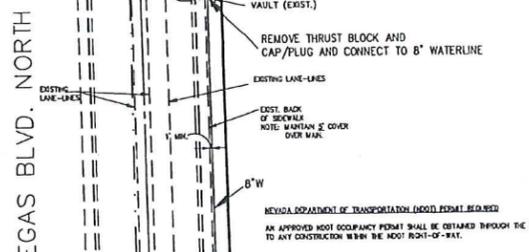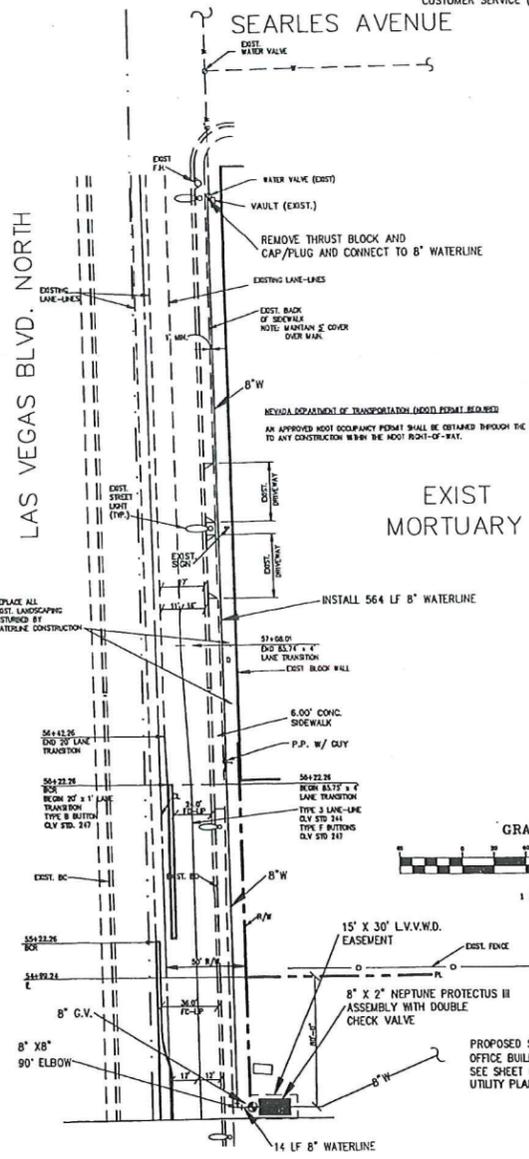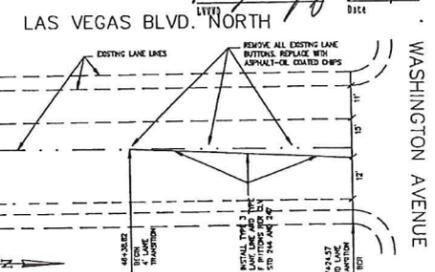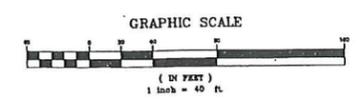

LUCCHESI GALATI ARCHITECTS
 2770 SOUTH MARYLAND PARKWAY
 SUITE 510
 LAS VEGAS, NEVADA 89109
 (702) 733-7107

STATE OFFICE BUILDING
 DEPARTMENT OF GENERAL SERVICES
 SPWB JOB # 91-C9

MARTIN & MARTIN
 MARTIN & MARTIN
 ONE, ONEFOUR
 1100 W. SHARPLESS BLVD.
 SUITE 400
 LAS VEGAS, NEVADA 89102
 PHONE (702) 388-0225

Handwritten signature and date
 1/22

Check and verify all dimensions and report of errors to the architect prior to commencing work. These drawings are not to be used for any other project without the written consent of the architect. Each document is to be read in conjunction with the contract and all other documents. No part of these drawings shall be used for any other project without the written consent of the architect. The architect assumes no responsibility for any errors or omissions in these drawings. The contractor shall be responsible for verifying all dimensions and conditions prior to construction. If any conflict exists between what is shown on these drawings and what exists in the field, the contractor is to notify the architect or engineer immediately.

Date: FEBRUARY 23, 1993
 Project No: 1098
 Scale: 1"=30'
 Drawn By: R. YOUNG
 Revisions:


Sheet Title:

ON-SITE UTILITY PLAN (WEST)

Sheet Number: 7 of 11

C5.01

107-12105

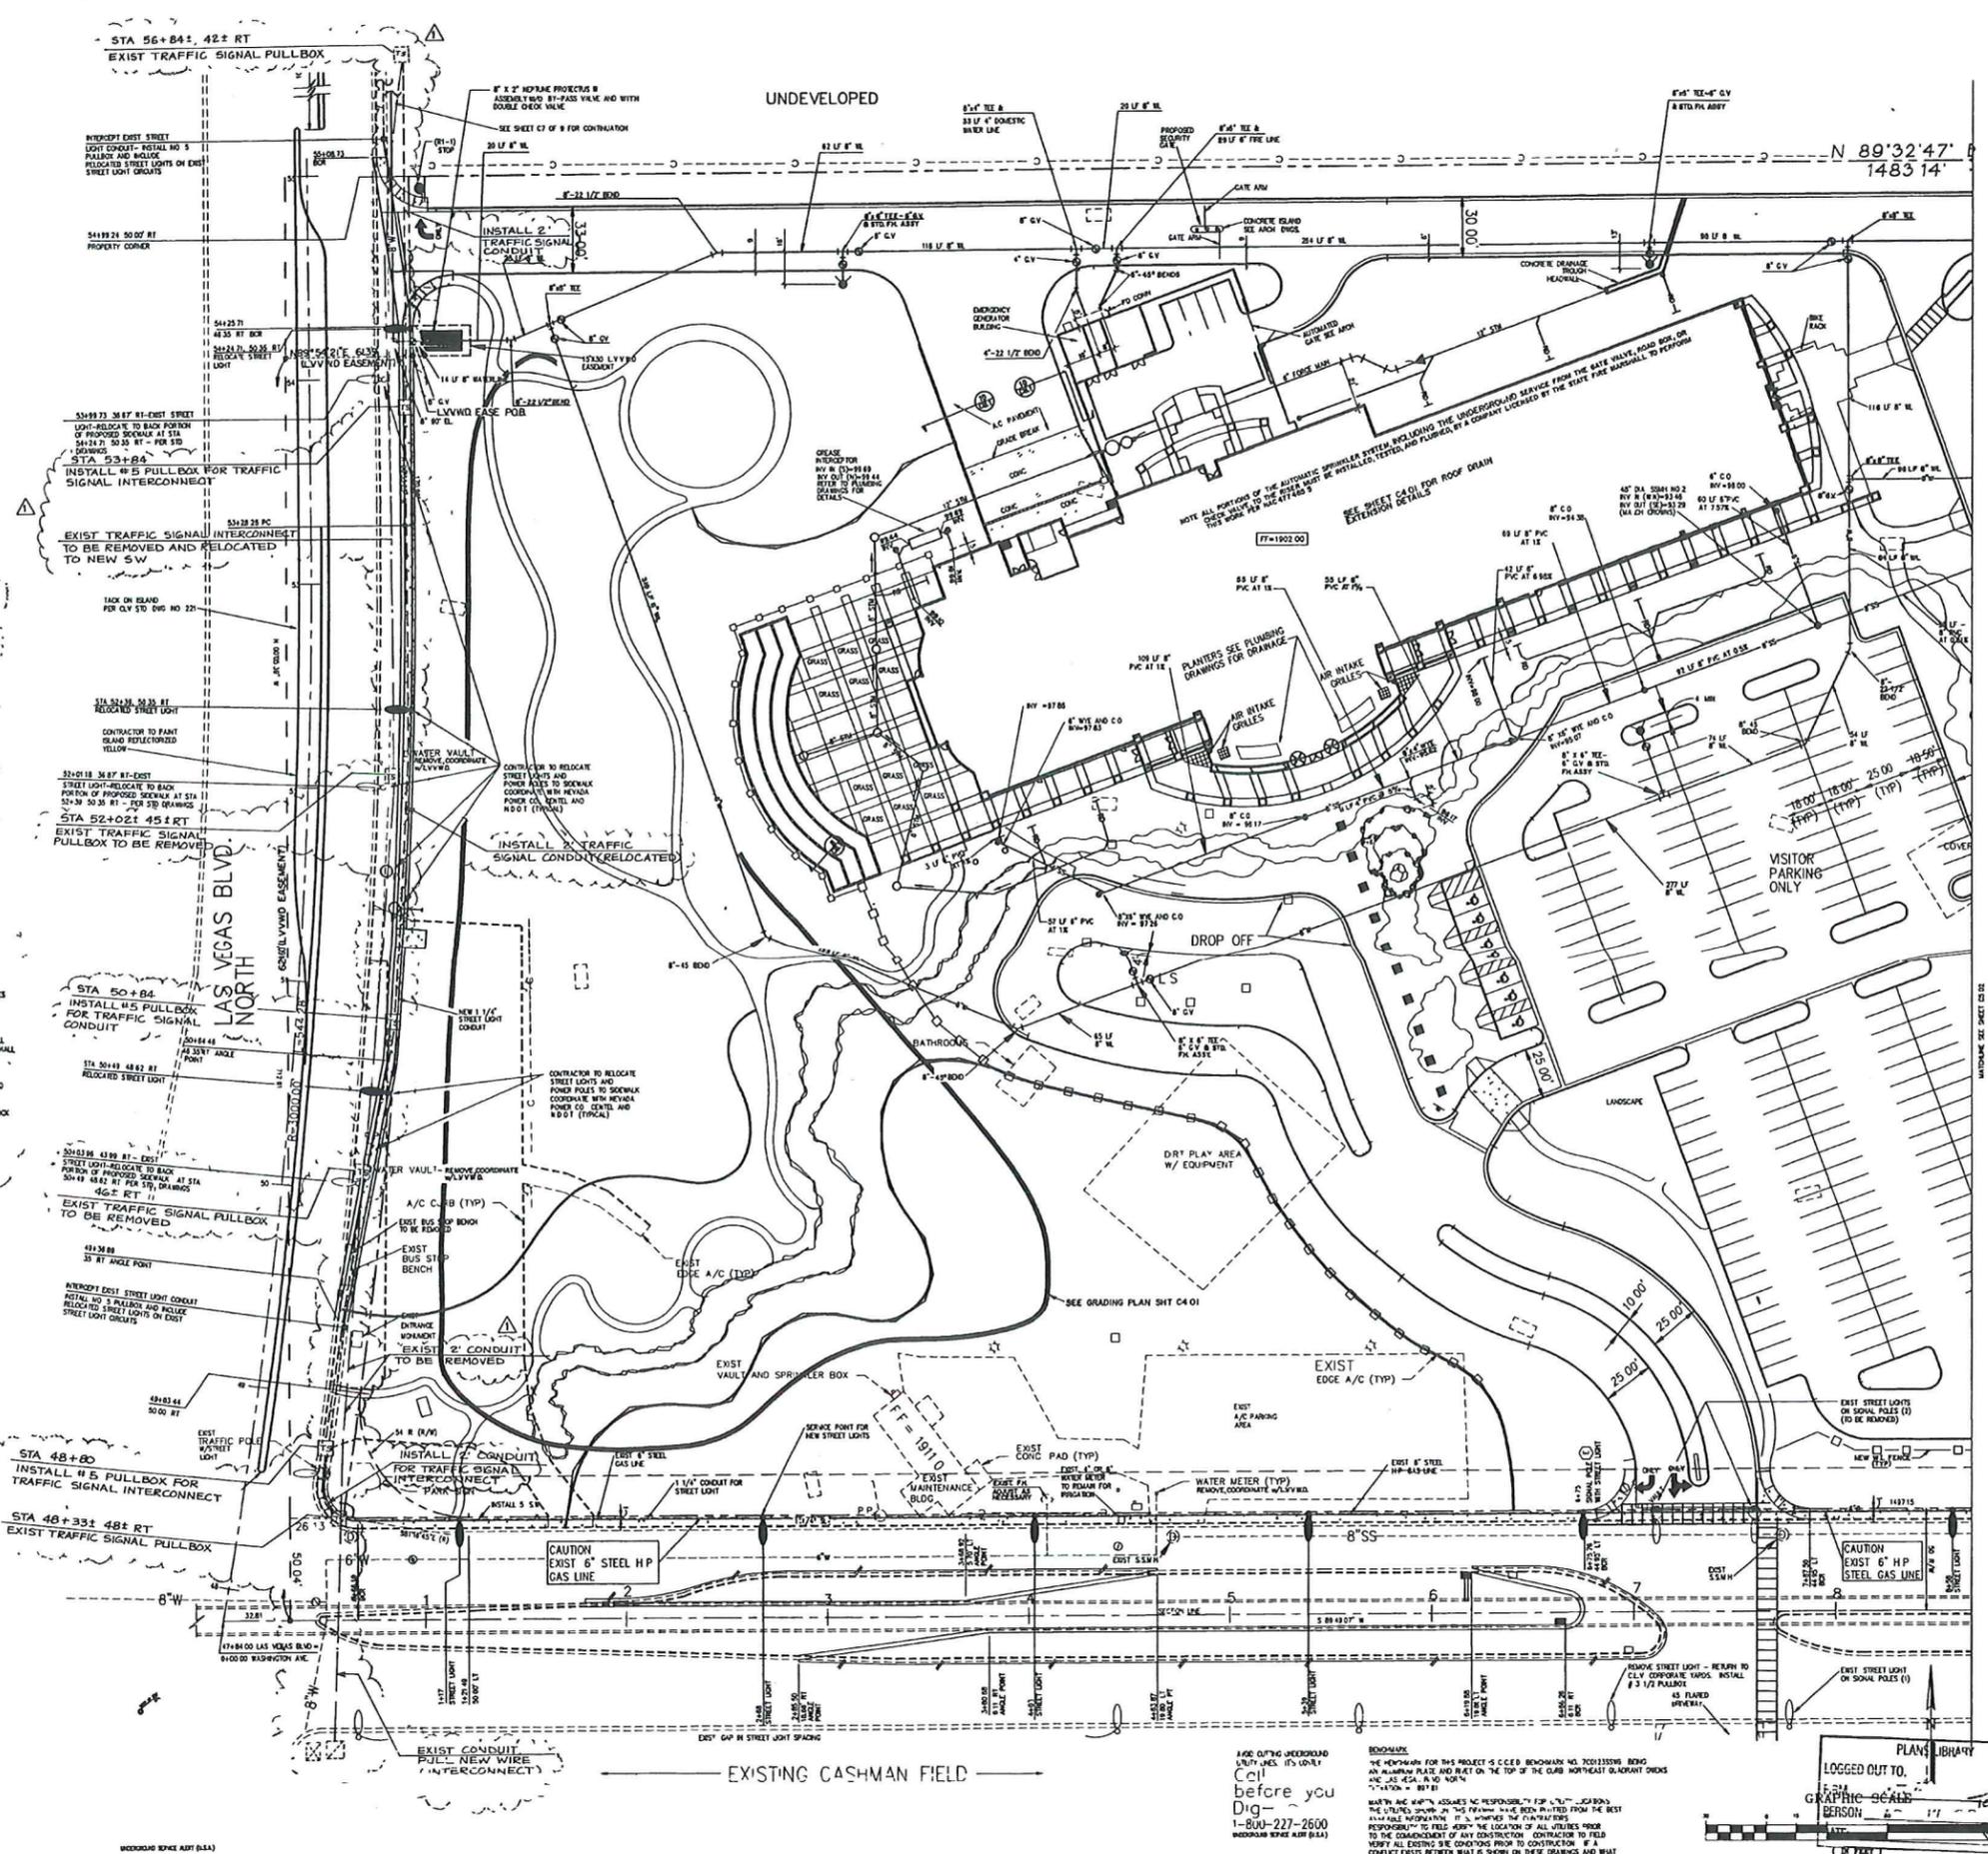

CONSTRUCTION NOTES


- INSTALL NEW 2" TRAFFIC SIGNAL CONDUIT IN SAME TRENCH (COMMON) ADJACENT TO PROJECT SITE AS THE STREET LIGHT CONDUIT
- ANY DAMAGE TO EXISTING LANDSCAPING AND IRRIGATION FACILITIES, CONTRACTOR TO REPAIR AND REPLACE TO ORIGINAL CONDITION.
- FOR DISCONNECTION AND CONNECTION OF INTERCONNECT CABLE, AT SPLICE BOX, CONTACT LAS VEGAS AREA COMPUTER TRAFFIC SYSTEM (LVACTS) AT (702)-229-6613.

CITY OF LAS VEGAS TRAFFIC NOTES

- IT IS THE RESPONSIBILITY OF THE CONTRACTOR TO LOCATE ALL UTILITIES PRIOR TO CONSTRUCTION AND NOTIFY ALL UTILITY OWNERS PRIOR TO THE START OF CONSTRUCTION. THE CONTRACTOR SHALL VERIFY THE LOCATION AND DEPTH OF ALL UTILITIES PRIOR TO CONSTRUCTION. ALL UTILITIES SHALL BE MARKED WITH PINK SURVEYING TAPE. THE CONTRACTOR SHALL BE RESPONSIBLE FOR THE PROTECTION OF ALL UTILITIES. ANY DAMAGE TO UTILITIES SHALL BE REPAIRED BY THE CONTRACTOR AT HIS OWN EXPENSE.
- ALL UTILITIES SHALL BE MARKED WITH PINK SURVEYING TAPE. THE CONTRACTOR SHALL BE RESPONSIBLE FOR THE PROTECTION OF ALL UTILITIES. ANY DAMAGE TO UTILITIES SHALL BE REPAIRED BY THE CONTRACTOR AT HIS OWN EXPENSE.
- ALL UTILITIES SHALL BE MARKED WITH PINK SURVEYING TAPE. THE CONTRACTOR SHALL BE RESPONSIBLE FOR THE PROTECTION OF ALL UTILITIES. ANY DAMAGE TO UTILITIES SHALL BE REPAIRED BY THE CONTRACTOR AT HIS OWN EXPENSE.
no.	description of revisions	date
1	FIELD REVISIONS	10-10-93

BEFORE YOU DIG
 CALL 1-800-227-2600
 (NEVADA STATE ALERT 811)

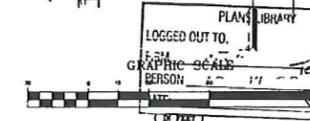

LOGGED OUT TO:
 GRAPHIC DESIGN
 BENSON

IMPROVEMENT PLANS FOR THE GRANT SAWYER OFFICE SITE WITH REVIEW WALK COMMENTS FROM 10/17/2018



2770 SOUTH MARYLAND PARKWAY
SUITE 510
LAS VEGAS, NEVADA 89109
(702) 733-7107




STATE OFFICE BUILDING

DEPARTMENT OF GENERAL SERVICES

SPWB JOB # 91-C9

MARTIN & MARTIN
MARTIN & MARTIN CIVIL ENGINEERS
1701 W. SHARPLESS BLVD.
SUITE 420
LAS VEGAS, NEVADA 89102
PHONE (702) 399-8000

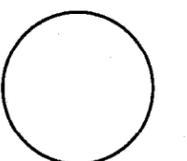

Check and verify all dimensions and report all errors to the architect prior to commencing work. These drawings are not to be scaled. All drawings, specifications and copies thereof prepared by the architect are to be used only with respect to the project and are not to be used for any other purpose without the express written consent of the architect. The architect's responsibility is limited to the design and construction of the project. The architect is not responsible for any errors or omissions in the drawings or specifications or for any other person's use or misuse of the drawings or specifications. The architect's liability is limited to the amount of the fee received by the architect for the project. Copyright © 1993 by Lucchesi Galati Architects, Inc. A Nevada Corporation. All rights reserved.

Date: FEBRUARY 23, 1993
Project No: 1096
Scale:
Drawn By: R. YOUNG
Revisions:

2-23-95
RECORD DRAWINGS

Sheet Title:

COVER AND APPROVAL SHEET

Sheet Number:

C1.01

MLH REVIEW WALK COMMENTS 10-17-2018

ABBREVIATIONS	SHEET INDEX	VICINITY MAP																																																																																																																																																																																																				
<table border="0"> <tr><td>A.C.</td><td>ASPHALIC CONCRETE</td><td>U.C.</td><td>ON CENTER</td></tr> <tr><td>A.C.P.</td><td>ASTBESTOS CEMENT PIPE</td><td>U.D.</td><td>OUTSIDE DIAMETER</td></tr> <tr><td>ADJ.</td><td>ADJUST, ADJUSTABLE</td><td>P</td><td>POWER LINE</td></tr> <tr><td>AL</td><td>ARC LENGTH</td><td>P.C.</td><td>POINT OF CURVATURE</td></tr> <tr><td>B.C.</td><td>BEGINNING OF CURB OR BACK OF CURB</td><td>P.C.C.</td><td>POINT OF COMPOUND CURVE</td></tr> <tr><td>B.C.R.</td><td>BEGINNING OF CURB RETURN OR BACK OF CURB RADIUS</td><td>P.G.</td><td>PAID GRADE</td></tr> <tr><td>B.D.</td><td>BOUNDARY</td><td>P.H.P.</td><td>PLASTIC HIGH PRESSURE</td></tr> <tr><td>BEG.</td><td>BEGIN</td><td>P.I.</td><td>POINT OF INTERSECTION</td></tr> <tr><td>B.M.</td><td>BENCHMARK</td><td>P.L.</td><td>PROPERTY LINE</td></tr> <tr><td>B.S.W.</td><td>BACK OF SIDEWALK</td><td>P.P.</td><td>POWER POLE</td></tr> <tr><td>B.V.C.</td><td>BEGINNING OF VERTICAL CURVE</td><td>P.R.C.</td><td>POINT OF REVERSE CURVE</td></tr> <tr><td>C&G</td><td>CURB AND GUTTER</td><td>PROP.</td><td>PROPOSED</td></tr> <tr><td>C.F.</td><td>CURB FACE</td><td>P.T.</td><td>POINT OF TANGENT</td></tr> <tr><td>C.I.P.</td><td>CAST IRON PIPE</td><td>P.V.C.</td><td>POLYVINYL CHLORIDE PIPE</td></tr> <tr><td>CL</td><td>CENTERLINE</td><td>P.V.I.</td><td>POINT OF VERTICAL INTERSECTION</td></tr> <tr><td>C.M.P.</td><td>CORRUGATED METAL PIPE</td><td>P.W.M.</td><td>PAVEMENT</td></tr> <tr><td>CONC.</td><td>CONCRETE</td><td>Q</td><td>RATE OF FLOW</td></tr> <tr><td>CONCR.</td><td>CONCRETE CONSTRUCTION</td><td>RAD.</td><td>RADIUS</td></tr> <tr><td>D.C.</td><td>DEPRESSED CURB</td><td>R.C.P.</td><td>REINFORCED CONCRETE PIPE</td></tr> <tr><td>D.I.</td><td>DROPP INLET</td><td>R</td><td>RIGHT</td></tr> <tr><td>DIA.</td><td>DIAMETER</td><td>R/W</td><td>RIGHT OF WAY</td></tr> <tr><td>D.I.P.</td><td>DUCTILE IRON PIPE</td><td>S</td><td>SOUTH SANITARY SEWER</td></tr> <tr><td>D.M.H.</td><td>DROPP MANHOLE</td><td>S.D.</td><td>STORM DRAIN</td></tr> <tr><td>E.C.</td><td>END OF CURVE</td><td>S.H.P.</td><td>STEEL HIGH PRESSURE</td></tr> <tr><td>F.C.S.</td><td>END OF CURB RETURN</td><td>SHT.</td><td>SHEET</td></tr> <tr><td>EL.</td><td>ELEVATION</td><td>SP, MH</td><td>SPECIAL MANHOLE</td></tr> <tr><td>E.P.</td><td>EDGE OF PAVING</td><td>STA.</td><td>STATION</td></tr> <tr><td>E.V.C.</td><td>EDGE OF VERTICAL CURVE</td><td>STD.</td><td>STANDARD</td></tr> <tr><td>EXST.</td><td>EXISTING</td><td>STL.</td><td>STEEL</td></tr> <tr><td>FIN. FL.</td><td>FINISHED FLOOR</td><td>SW</td><td>SIDEWALK</td></tr> <tr><td>FIN. GR.</td><td>FINISHED GRADE</td><td>T</td><td>TANGENT DISTANCE</td></tr> <tr><td>F.H.</td><td>FIRE HYDRANT</td><td>TEL.</td><td>TELEPHONE</td></tr> <tr><td>FL</td><td>FLOWLINE</td><td>T.O.C.</td><td>TOP OF CURB</td></tr> <tr><td>G</td><td>GAS</td><td>T.O.C.</td><td>TOP OF CONCRETE</td></tr> <tr><td>GR. BRK.</td><td>GRADE BREAK</td><td>T.O.M.</td><td>TOP OF MANHOLE</td></tr> <tr><td>HOT</td><td>HOT</td><td>T.O.W.</td><td>TOP OF WALL</td></tr> <tr><td>HORIZ.</td><td>HORIZONTAL</td><td>TRANS.</td><td>TRANSITION</td></tr> <tr><td>H.P.</td><td>HIGH POINT</td><td>T.S.C.</td><td>TRAFFIC SIGNAL CONDUIT</td></tr> <tr><td>I.D.</td><td>INSIDE DIAMETER</td><td>T.S.W.</td><td>TOP OF SIDEWALK</td></tr> <tr><td>INV.</td><td>INVERT</td><td>V.C.</td><td>VERTICAL CURVE</td></tr> <tr><td>LS</td><td>LANDSCAPE</td><td>V.C.P.</td><td>VERTICAL CLAY PIPE</td></tr> <tr><td>LAT.</td><td>LATERAL</td><td>VERT.</td><td>VERTICAL</td></tr> <tr><td>L.F.</td><td>LANDSCAPE FOOT</td><td>V.G.</td><td>VALLEY GUTTER</td></tr> <tr><td>LT</td><td>LEFT</td><td>W</td><td>WEST, WATER</td></tr> <tr><td>MAX.</td><td>MAXIMUM</td><td></td><td></td></tr> <tr><td>M.H.</td><td>MANHOLE</td><td></td><td></td></tr> <tr><td>MIN.</td><td>MINIMUM</td><td></td><td></td></tr> <tr><td>N.L.C.</td><td>NOT IN CONTRACT</td><td></td><td></td></tr> <tr><td>NO.</td><td>NUMBER</td><td></td><td></td></tr> </table>	A.C.	ASPHALIC CONCRETE	U.C.	ON CENTER	A.C.P.	ASTBESTOS CEMENT PIPE	U.D.	OUTSIDE DIAMETER	ADJ.	ADJUST, ADJUSTABLE	P	POWER LINE	AL	ARC LENGTH	P.C.	POINT OF CURVATURE	B.C.	BEGINNING OF CURB OR BACK OF CURB	P.C.C.	POINT OF COMPOUND CURVE	B.C.R.	BEGINNING OF CURB RETURN OR BACK OF CURB RADIUS	P.G.	PAID GRADE	B.D.	BOUNDARY	P.H.P.	PLASTIC HIGH PRESSURE	BEG.	BEGIN	P.I.	POINT OF INTERSECTION	B.M.	BENCHMARK	P.L.	PROPERTY LINE	B.S.W.	BACK OF SIDEWALK	P.P.	POWER POLE	B.V.C.	BEGINNING OF VERTICAL CURVE	P.R.C.	POINT OF REVERSE CURVE	C&G	CURB AND GUTTER	PROP.	PROPOSED	C.F.	CURB FACE	P.T.	POINT OF TANGENT	C.I.P.	CAST IRON PIPE	P.V.C.	POLYVINYL CHLORIDE PIPE	CL	CENTERLINE	P.V.I.	POINT OF VERTICAL INTERSECTION	C.M.P.	CORRUGATED METAL PIPE	P.W.M.	PAVEMENT	CONC.	CONCRETE	Q	RATE OF FLOW	CONCR.	CONCRETE CONSTRUCTION	RAD.	RADIUS	D.C.	DEPRESSED CURB	R.C.P.	REINFORCED CONCRETE PIPE	D.I.	DROPP INLET	R	RIGHT	DIA.	DIAMETER	R/W	RIGHT OF WAY	D.I.P.	DUCTILE IRON PIPE	S	SOUTH SANITARY SEWER	D.M.H.	DROPP MANHOLE	S.D.	STORM DRAIN	E.C.	END OF CURVE	S.H.P.	STEEL HIGH PRESSURE	F.C.S.	END OF CURB RETURN	SHT.	SHEET	EL.	ELEVATION	SP, MH	SPECIAL MANHOLE	E.P.	EDGE OF PAVING	STA.	STATION	E.V.C.	EDGE OF VERTICAL CURVE	STD.	STANDARD	EXST.	EXISTING	STL.	STEEL	FIN. FL.	FINISHED FLOOR	SW	SIDEWALK	FIN. GR.	FINISHED GRADE	T	TANGENT DISTANCE	F.H.	FIRE HYDRANT	TEL.	TELEPHONE	FL	FLOWLINE	T.O.C.	TOP OF CURB	G	GAS	T.O.C.	TOP OF CONCRETE	GR. BRK.	GRADE BREAK	T.O.M.	TOP OF MANHOLE	HOT	HOT	T.O.W.	TOP OF WALL	HORIZ.	HORIZONTAL	TRANS.	TRANSITION	H.P.	HIGH POINT	T.S.C.	TRAFFIC SIGNAL CONDUIT	I.D.	INSIDE DIAMETER	T.S.W.	TOP OF SIDEWALK	INV.	INVERT	V.C.	VERTICAL CURVE	LS	LANDSCAPE	V.C.P.	VERTICAL CLAY PIPE	LAT.	LATERAL	VERT.	VERTICAL	L.F.	LANDSCAPE FOOT	V.G.	VALLEY GUTTER	LT	LEFT	W	WEST, WATER	MAX.	MAXIMUM			M.H.	MANHOLE			MIN.	MINIMUM			N.L.C.	NOT IN CONTRACT			NO.	NUMBER			<p>C1.01 COVER AND APPROVAL SHEET C2.01 DEMOLITION PLAN C3.01 HORIZONTAL CONTROL PLAN NO. 1, (WEST) C3.02 HORIZONTAL CONTROL PLAN NO. 2, (EAST) C4.01 GRADING PLAN NO. 1, (WEST) C4.02 GRADING PLAN NO. 2, (EAST) C5.01 ON-SITE UTILITY PLAN, (WEST) C5.02 ON-SITE UTILITY PLAN, (EAST) C6.01 OFF-SITE WATER PLAN C7.01 SIGNAL MODIFICATION PLAN C8.01 SECTIONS AND DETAILS</p>	
A.C.	ASPHALIC CONCRETE	U.C.	ON CENTER																																																																																																																																																																																																			
A.C.P.	ASTBESTOS CEMENT PIPE	U.D.	OUTSIDE DIAMETER																																																																																																																																																																																																			
ADJ.	ADJUST, ADJUSTABLE	P	POWER LINE																																																																																																																																																																																																			
AL	ARC LENGTH	P.C.	POINT OF CURVATURE																																																																																																																																																																																																			
B.C.	BEGINNING OF CURB OR BACK OF CURB	P.C.C.	POINT OF COMPOUND CURVE																																																																																																																																																																																																			
B.C.R.	BEGINNING OF CURB RETURN OR BACK OF CURB RADIUS	P.G.	PAID GRADE																																																																																																																																																																																																			
B.D.	BOUNDARY	P.H.P.	PLASTIC HIGH PRESSURE																																																																																																																																																																																																			
BEG.	BEGIN	P.I.	POINT OF INTERSECTION																																																																																																																																																																																																			
B.M.	BENCHMARK	P.L.	PROPERTY LINE																																																																																																																																																																																																			
B.S.W.	BACK OF SIDEWALK	P.P.	POWER POLE																																																																																																																																																																																																			
B.V.C.	BEGINNING OF VERTICAL CURVE	P.R.C.	POINT OF REVERSE CURVE																																																																																																																																																																																																			
C&G	CURB AND GUTTER	PROP.	PROPOSED																																																																																																																																																																																																			
C.F.	CURB FACE	P.T.	POINT OF TANGENT																																																																																																																																																																																																			
C.I.P.	CAST IRON PIPE	P.V.C.	POLYVINYL CHLORIDE PIPE																																																																																																																																																																																																			
CL	CENTERLINE	P.V.I.	POINT OF VERTICAL INTERSECTION																																																																																																																																																																																																			
C.M.P.	CORRUGATED METAL PIPE	P.W.M.	PAVEMENT																																																																																																																																																																																																			
CONC.	CONCRETE	Q	RATE OF FLOW																																																																																																																																																																																																			
CONCR.	CONCRETE CONSTRUCTION	RAD.	RADIUS																																																																																																																																																																																																			
D.C.	DEPRESSED CURB	R.C.P.	REINFORCED CONCRETE PIPE																																																																																																																																																																																																			
D.I.	DROPP INLET	R	RIGHT																																																																																																																																																																																																			
DIA.	DIAMETER	R/W	RIGHT OF WAY																																																																																																																																																																																																			
D.I.P.	DUCTILE IRON PIPE	S	SOUTH SANITARY SEWER																																																																																																																																																																																																			
D.M.H.	DROPP MANHOLE	S.D.	STORM DRAIN																																																																																																																																																																																																			
E.C.	END OF CURVE	S.H.P.	STEEL HIGH PRESSURE																																																																																																																																																																																																			
F.C.S.	END OF CURB RETURN	SHT.	SHEET																																																																																																																																																																																																			
EL.	ELEVATION	SP, MH	SPECIAL MANHOLE																																																																																																																																																																																																			
E.P.	EDGE OF PAVING	STA.	STATION																																																																																																																																																																																																			
E.V.C.	EDGE OF VERTICAL CURVE	STD.	STANDARD																																																																																																																																																																																																			
EXST.	EXISTING	STL.	STEEL																																																																																																																																																																																																			
FIN. FL.	FINISHED FLOOR	SW	SIDEWALK																																																																																																																																																																																																			
FIN. GR.	FINISHED GRADE	T	TANGENT DISTANCE																																																																																																																																																																																																			
F.H.	FIRE HYDRANT	TEL.	TELEPHONE																																																																																																																																																																																																			
FL	FLOWLINE	T.O.C.	TOP OF CURB																																																																																																																																																																																																			
G	GAS	T.O.C.	TOP OF CONCRETE																																																																																																																																																																																																			
GR. BRK.	GRADE BREAK	T.O.M.	TOP OF MANHOLE																																																																																																																																																																																																			
HOT	HOT	T.O.W.	TOP OF WALL																																																																																																																																																																																																			
HORIZ.	HORIZONTAL	TRANS.	TRANSITION																																																																																																																																																																																																			
H.P.	HIGH POINT	T.S.C.	TRAFFIC SIGNAL CONDUIT																																																																																																																																																																																																			
I.D.	INSIDE DIAMETER	T.S.W.	TOP OF SIDEWALK																																																																																																																																																																																																			
INV.	INVERT	V.C.	VERTICAL CURVE																																																																																																																																																																																																			
LS	LANDSCAPE	V.C.P.	VERTICAL CLAY PIPE																																																																																																																																																																																																			
LAT.	LATERAL	VERT.	VERTICAL																																																																																																																																																																																																			
L.F.	LANDSCAPE FOOT	V.G.	VALLEY GUTTER																																																																																																																																																																																																			
LT	LEFT	W	WEST, WATER																																																																																																																																																																																																			
MAX.	MAXIMUM																																																																																																																																																																																																					
M.H.	MANHOLE																																																																																																																																																																																																					
MIN.	MINIMUM																																																																																																																																																																																																					
N.L.C.	NOT IN CONTRACT																																																																																																																																																																																																					
NO.	NUMBER																																																																																																																																																																																																					
SYMBOLS LEGEND	GENERAL NOTES	APPROVALS																																																																																																																																																																																																				
<table border="0"> <tr><td>EXISTING PROPOSED</td><td>RIGHT-OF-WAY</td><td>EXISTING PROPOSED</td><td>SCREEN / RETAINING WALL</td></tr> <tr><td>---</td><td>CONCRETE</td><td>-----</td><td>WIRE OR CHAIN LINK FENCE</td></tr> <tr><td>---</td><td>WATER LINE</td><td>---</td><td>TRASH ENCLOSURE</td></tr> <tr><td>---</td><td>SANITARY SEWER LINE</td><td>---</td><td>GRADE BREAK</td></tr> <tr><td>---</td><td>GAS LINE</td><td>---</td><td>CONTOUR LINE</td></tr> <tr><td>---</td><td>STORM DRAIN</td><td>---</td><td>FINISH FLOOR</td></tr> <tr><td>---</td><td>POWER LINE / POWER POLE</td><td>---</td><td>CLEANOUT INVERT ELEVATION</td></tr> <tr><td>---</td><td>TELEPHONE LINE</td><td>---</td><td>FLOW LINE</td></tr> <tr><td>---</td><td>FIRE HYDRANT</td><td>---</td><td>FINISH GRADE</td></tr> <tr><td>---</td><td>WATER VALVE</td><td>---</td><td>BACK OF SIDEWALK</td></tr> <tr><td>---</td><td>METERS / PULL BOXES</td><td>---</td><td>B.S.W.</td></tr> <tr><td>---</td><td>REDUCER</td><td>---</td><td>TOP OF CURB</td></tr> <tr><td>---</td><td>MANHOLE</td><td>---</td><td>TOP OF WALL</td></tr> <tr><td>---</td><td>CLEANOUT</td><td>---</td><td>A.C. PAVING</td></tr> <tr><td>---</td><td>STREET LIGHT</td><td>---</td><td>TYPE "1" CURB & GUTTER</td></tr> <tr><td>---</td><td></td><td>---</td><td>TYPE "A" CURB</td></tr> <tr><td>---</td><td></td><td>---</td><td>R.D. ROOF DRAIN</td></tr> <tr><td>---</td><td></td><td>---</td><td>END RETAINING WALL</td></tr> <tr><td>---</td><td></td><td>---</td><td>F.R.W.</td></tr> <tr><td>---</td><td></td><td>---</td><td>FIRELANE DESIGNATION</td></tr> </table> <p>DEVIATIONS FROM STANDARD DRAWINGS: 1.) C.L.V. STD. DWG. NO. 235 - SEE DETAIL 2.) SEE SHEET C7.01 FOR C.L.V. TRAFFIC NOTES.</p>	EXISTING PROPOSED	RIGHT-OF-WAY	EXISTING PROPOSED	SCREEN / RETAINING WALL	---	CONCRETE	-----	WIRE OR CHAIN LINK FENCE	---	WATER LINE	---	TRASH ENCLOSURE	---	SANITARY SEWER LINE	---	GRADE BREAK	---	GAS LINE	---	CONTOUR LINE	---	STORM DRAIN	---	FINISH FLOOR	---	POWER LINE / POWER POLE	---	CLEANOUT INVERT ELEVATION	---	TELEPHONE LINE	---	FLOW LINE	---	FIRE HYDRANT	---	FINISH GRADE	---	WATER VALVE	---	BACK OF SIDEWALK	---	METERS / PULL BOXES	---	B.S.W.	---	REDUCER	---	TOP OF CURB	---	MANHOLE	---	TOP OF WALL	---	CLEANOUT	---	A.C. PAVING	---	STREET LIGHT	---	TYPE "1" CURB & GUTTER	---		---	TYPE "A" CURB	---		---	R.D. ROOF DRAIN	---		---	END RETAINING WALL	---		---	F.R.W.	---		---	FIRELANE DESIGNATION	<p>CITY OF LAS VEGAS GENERAL NOTES REQUIRED NOTES - OTHERS ONLY IF APPLICABLE</p> <ol style="list-style-type: none"> ALL CONSTRUCTION AND MATERIALS SHALL BE IN ACCORDANCE WITH THE UNIFORM STANDARD SPECIFICATIONS FOR PUBLIC WORKS CONSTRUCTION OFF-SITE IMPROVEMENTS, CLARK COUNTY AREA NEVADA, LATEST EDITION, THE "UNIFORM STANDARD DRAWINGS FOR PUBLIC WORKS CONSTRUCTION, CLARK COUNTY AREA NEVADA", LATEST EDITION, AND OTHER APPLICABLE APPROVED STANDARDS ISSUED BY THE CONTROLLING AGENCIES, THE UNIFORM BUILDING CODE, AND ALL LOCAL CITY ORDINANCES AND ORDINANCES APPLICABLE, EXCEPT AS NOTED ON THIS SHEET AS "DEVIATIONS FROM STANDARDS". THE EXISTENCE AND LOCATION OF ANY OVERHEAD OR UNDERGROUND UTILITY LINES, PIPES OR STRUCTURES SHOWN ON THESE PLANS ARE OBTAINED BY A RESEARCH OF THE AVAILABLE RECORDS. EXISTING UTILITIES ARE LOCATED ON PLANS ONLY FOR THE CONVENIENCE OF THE CONTRACTOR. EXISTING UTILITY SERVICE LATERALS MAY NOT BE SHOWN ON THE PLANS. THE CONTRACTOR SHALL, AT HIS OWN EXPENSE, LOCATE ALL UNDERGROUND AND OVERHEAD INTERFERENCES WHICH MAY AFFECT HIS OPERATION DURING CONSTRUCTION AND SHALL TAKE ALL NECESSARY PRECAUTIONS TO AVOID DAMAGE TO SAME. THE CONTRACTOR SHALL USE EXTREME CAUTION WHEN WORKING NEAR OVERHEAD OR UNDERGROUND POWER, GAS AND/OR OTHER UTILITIES SO AS TO SAFELY PROTECT ALL PERSONNEL AND EQUIPMENT, AND SHALL BE RESPONSIBLE FOR ALL COSTS AND LIABILITY IN CONNECTION THEREWITH. THE CONTRACTOR SHALL TAKE ALL PRECAUTIONARY MEASURES NECESSARY TO PROTECT EXISTING UTILITY LINES, STRUCTURES, AND STREET IMPROVEMENTS WHICH ARE TO REMAIN IN PLACE FROM DAMAGE, AND ALL SUCH IMPROVEMENTS OR STRUCTURES DAMAGED BY THE CONTRACTOR'S OPERATIONS SHALL BE REPAIRED OR REPLACED SATISFACTORY TO THE CITY ENGINEER OR DRAINING UTILITY COMPANY AT THE EXPENSE OF THE CONTRACTOR. ALL CONSTRUCTION SHALL BE AS SHOWN ON THESE PLANS, ANY REVISIONS SHALL HAVE THE PRIOR WRITTEN APPROVAL OF THE CITY ENGINEER. TYPE V CONCRETE SHALL BE USED IN ALL OFF-SITE CONCRETE WORK. CONCRETE TO BE 3000 P.S.I. MINIMUM AT 28 DAYS. MIX DESIGN TO BE APPROVED BY THE QUALITY CONTROL DIVISION PRIOR TO USE ON THE PROJECT. PERMITS ARE REQUIRED FOR ANY WORK IN THE PUBLIC RIGHT-OF-WAY. THE CONTRACTOR SHALL SECURE ALL PERMITS AND INSPECTIONS REQUIRED FOR THIS CONSTRUCTION. EXPANSION JOINTS REQUIRED, MAXIMUM EVERY 300' IN EXTRUDED TYPE CURBS. AC PAVEMENT TO BE 1/2" ABOVE LIP OF ALL GUTTERS AFTER COMPACTION, EXCEPT AT SIDEWALK RAMP. APPLY FOG SEAL ONLY AFTER ALL CORRECTIONS AND ADJUSTMENTS HAVE BEEN MADE. CURB & GUTTER WITH A GRADE OF LESS THAN FOUR TENTHS OF ONE PERCENT SHALL BE WATER TESTED AS SOON AS POSSIBLE AFTER CONSTRUCTION. ANY CURB AND GUTTER FOUND TO BE UNSATISFACTORY TO THE CITY SHALL BE REMOVED AND REPLACED. SIDEWALK RAMP SHALL BE CONSTRUCTED IN EACH QUADRANT OF AN INTERSECTION PER STANDARD DRAWING 235. EXACT LOCATION OF RAMP MAY BE ADJUSTED IN THE FIELD BY A CITY INSPECTOR. CONTRACTOR SHALL PROVIDE ALL NECESSARY HORIZONTAL AND VERTICAL TRANSITIONS BETWEEN NEW CONSTRUCTION AND EXISTING SURFACES TO PROVIDE FOR PROPER DRAINAGE, AND TO PREVENT AND AVOID TO NEW CONSTRUCTION. THE EXTENT OF TRANSITIONS TO BE AS SHOWN ON PLANS, OR AS DESIGNATED IN THE FIELD BY A CITY INSPECTOR. ALL GRADING WORK SHALL CONFORM TO THE SOIL REPORT AS PREPARED BY THE SOILS ENGINEER AND APPROVED BY THE CITY ENGINEER, AND AS SHOWN ON THESE PLANS. EXACT LOCATION OF ALL SAWCUT LINES MAY BE DETERMINED IN THE FIELD BY A CITY OF LAS VEGAS INSPECTOR IF LOCATION ON PLANS IS NOT CLEARLY SHOWN, OR EXISTING PAVEMENT CONDITION REQUIRES RELOCATION. THE CONTRACTOR SHALL TAKE ALL PRECAUTIONS NECESSARY TO PROTECT EXISTING PERMANENT SURVEY MONUMENTS. ANY MONUMENTS DISTURBED SHALL BE REPLACED AND ADJUSTED PER AVAILABLE RECORDS IN ACCORDANCE WITH N.E.S. STATUTE NO. 208.500. UTILITY COMPANY METER BOXES, MANHOLE LIDS, VALVE COVERS, ETC. SHALL BE LOCATED OUT OF DRIVEWAYS, DRIVEWAY APRONS, FLOWLINES, AND CROSS GUTTERS UNLESS WRITTEN APPROVAL IS GRANTED BY THE UTILITY COMPANY AND THE CITY ENGINEER. WALL NOTES: A. ALL WALLS, NEW OR EXISTING, ARE ONLY SHOWN FOR THE PURPOSE OF GRADING RELATIONSHIPS. B. THE STRUCTURAL AND ARCHITECTURAL DESIGN OF ALL WALLS (RETAINING OR NON-RETAINING) MUST BE APPROVED BY THE CITY ENGINEER PRIOR TO THE PLACEMENT OF ASPHALT ON CITY STREETS. ASPHALT MIX DESIGN MUST BE SUBMITTED AND APPROVED BY THE CITY ENGINEER PRIOR TO THE PLACEMENT OF ASPHALT ON CITY STREETS. REVISION 12/92 DCM ALL SLOPE SIDEWALKS WITH A SLOPE STEEPER THAN 1:20 ARE RAMP AND WILL BE TREATED IN ACCORDANCE WITH ADA STANDARDS. REFER TO EXHIBIT A OF THE ADDENDUM FOR HANDRAIL AND RAMP-EDGE DETAILS. CROSS SLOPES OF RAMP SHALL NOT EXCEED 2% (1:50). 	<table border="0"> <tr><td>CENTRAL TELEPHONE COMPANY</td><td>DATE</td></tr> <tr><td>SOUTHWEST GAS CORPORATION</td><td>DATE</td></tr> <tr><td>NEVADA POWER COMPANY</td><td>DATE</td></tr> <tr><td>APPROVED FOR CONSTRUCTION:</td><td></td></tr> <tr><td>LAS VEGAS VALLEY WATER DISTRICT</td><td>DATE</td></tr> <tr><td>CLV FIRE MARSHAL</td><td>DATE</td></tr> <tr><td>DENNIS ANDERSON, P.E. NO. 9160</td><td>DATE</td></tr> <tr><td>CLV CITY ENGINEER</td><td></td></tr> </table>	CENTRAL TELEPHONE COMPANY	DATE	SOUTHWEST GAS CORPORATION	DATE	NEVADA POWER COMPANY	DATE	APPROVED FOR CONSTRUCTION:		LAS VEGAS VALLEY WATER DISTRICT	DATE	CLV FIRE MARSHAL	DATE	DENNIS ANDERSON, P.E. NO. 9160	DATE	CLV CITY ENGINEER																																																																																																					
EXISTING PROPOSED	RIGHT-OF-WAY	EXISTING PROPOSED	SCREEN / RETAINING WALL																																																																																																																																																																																																			
---	CONCRETE	-----	WIRE OR CHAIN LINK FENCE																																																																																																																																																																																																			
---	WATER LINE	---	TRASH ENCLOSURE																																																																																																																																																																																																			
---	SANITARY SEWER LINE	---	GRADE BREAK																																																																																																																																																																																																			
---	GAS LINE	---	CONTOUR LINE																																																																																																																																																																																																			
---	STORM DRAIN	---	FINISH FLOOR																																																																																																																																																																																																			
---	POWER LINE / POWER POLE	---	CLEANOUT INVERT ELEVATION																																																																																																																																																																																																			
---	TELEPHONE LINE	---	FLOW LINE																																																																																																																																																																																																			
---	FIRE HYDRANT	---	FINISH GRADE																																																																																																																																																																																																			
---	WATER VALVE	---	BACK OF SIDEWALK																																																																																																																																																																																																			
---	METERS / PULL BOXES	---	B.S.W.																																																																																																																																																																																																			
---	REDUCER	---	TOP OF CURB																																																																																																																																																																																																			
---	MANHOLE	---	TOP OF WALL																																																																																																																																																																																																			
---	CLEANOUT	---	A.C. PAVING																																																																																																																																																																																																			
---	STREET LIGHT	---	TYPE "1" CURB & GUTTER																																																																																																																																																																																																			
---		---	TYPE "A" CURB																																																																																																																																																																																																			
---		---	R.D. ROOF DRAIN																																																																																																																																																																																																			
---		---	END RETAINING WALL																																																																																																																																																																																																			
---		---	F.R.W.																																																																																																																																																																																																			
---		---	FIRELANE DESIGNATION																																																																																																																																																																																																			
CENTRAL TELEPHONE COMPANY	DATE																																																																																																																																																																																																					
SOUTHWEST GAS CORPORATION	DATE																																																																																																																																																																																																					
NEVADA POWER COMPANY	DATE																																																																																																																																																																																																					
APPROVED FOR CONSTRUCTION:																																																																																																																																																																																																						
LAS VEGAS VALLEY WATER DISTRICT	DATE																																																																																																																																																																																																					
CLV FIRE MARSHAL	DATE																																																																																																																																																																																																					
DENNIS ANDERSON, P.E. NO. 9160	DATE																																																																																																																																																																																																					
CLV CITY ENGINEER																																																																																																																																																																																																						
	<p>EXHIBIT A</p>																																																																																																																																																																																																					



**LUCCHESI
• GALATI •**
ARCHITECTS

2770 SOUTH
MARYLAND PARKWAY
SUITE 510
LAS VEGAS, NEVADA
89109
(702) 733-7107




STATE OFFICE BUILDING

DEPARTMENT OF
GENERAL SERVICES

SPWB JOB # 91-C9

MARTIN & MARTIN
MARTIN & MARTIN
CIVIL ENGINEERS
1701 W. CHARLESTON BLVD.
SUITE 400
LAS VEGAS, NEVADA 89102
PHONE (702) 388-8005

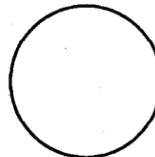

Check and verify all dimensions and report all errors to the Architect prior to commencing work. These drawings are not to be used for any other project without the written consent of the Architect. No part of these drawings shall be reproduced or transmitted in any form or by any means, electronic, mechanical, photocopying, recording, or by any information storage and retrieval system, without the prior written permission of the Architect. Copyright © 1993 Lucchesi Galati Architects, Inc. A Nevada Corporation. Copyright Lucchesi Galati Architects, Inc. 1992

Date: FEBRUARY 23, 1993
Project No.: 91-C9
Scale: 1"=60'
Drawn By: R. YOUNG
Revisions:


2-23-95
RECORD DRAWINGS

Sheet Title:

DEMOLITION PLAN

Sheet Number:

C2.01

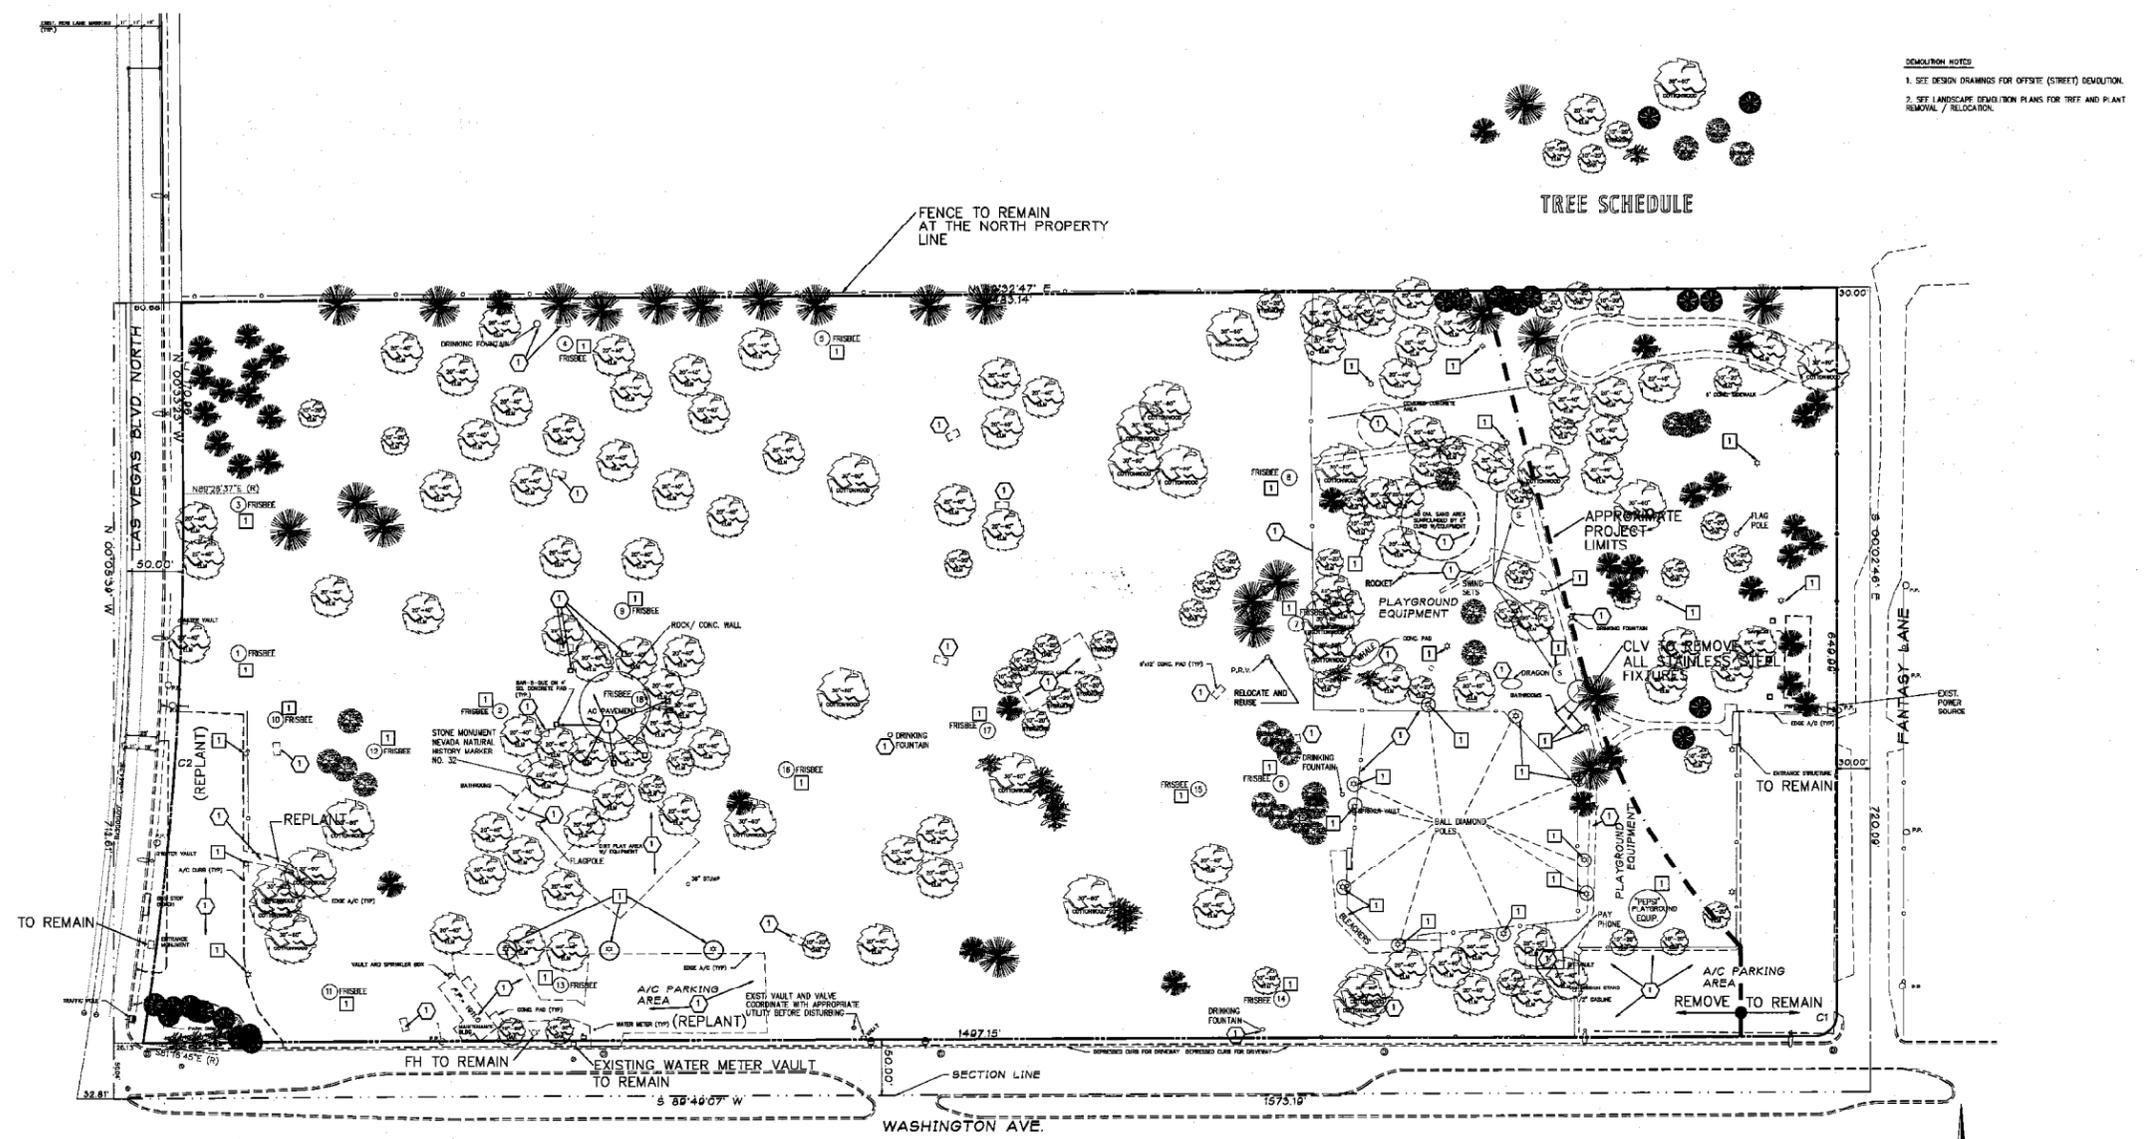

DEMOLITION NOTES
1. SEE DESIGN DRAWINGS FOR OFFSITE (STREET) DEMOLITION.
2. SEE LANDSCAPE DEMOLITION PLANS FOR TREE AND PLANT REMOVAL / RELOCATION.



TREE SCHEDULE

- LEGEND**
- FD. RLS TAC AND NAIL
 - SET PLS 7008 PLASTIC CAP
 - - - SECTION LINE
 - - - CENTERLINE
 - BOUNDARY LINE / LIMITS OF CONSTRUCTION
 - - - PROPERTY LINE EXTENSION
 - ☆ AREA LIGHT
 - ⊕ STREET LIGHT
 - ⊕ FIRE HYDRANT
 - ⊕ TRAFFIC SIGNAL POLE
 - CONCRETE SLAB

NOTE: BOUNDARY LINE INDICATES LIMITS OF CONSTRUCTION WHERE CONTRACTORS CONSTRUCTION FENCE IS TO BE LOCATED

DEMOLITION LEGEND

- ① FRISBEE STAND
- ① ITEM TO BE REMOVED BY CLV PARK AND LEISURE
- ① ITEM TO BE DEMOLISHED / REMOVED AS A PART OF STATE OFFICE PROJECT

AREA

NET AREA
992,000 sq. ft.
22.79 acres

CURVE TABLE


CURVE	RADIUS	LENGTH	TANGENT	CHORD
C1	20.00'	31.37'	16.85'	28.25'
C2	3090.00'	493.85'	247.46'	493.31'

BASIS OF BEARINGS

THE BASIS OF BEARINGS FOR THIS SURVEY IS THE EAST-WEST CENTER OF SECTIONLINE OF SECTION 28, TOWNSHIP 20 SOUTH, RANGE 61 EAST, M.D.M. AS SHOWN IN FILE 63, PAGE 51, OF RECORDED SURVEYS, OFFICIAL RECORDS, CLARK COUNTY, NEVADA. SAID LINE BEARS S89°49'07"W.

BENCHMARK

THE BENCHMARK FOR THIS SURVEY IS C.C.E.D. BENCHMARK # 700123SSW6, BEING AN ALLUM. PLATE AND RIVET ON THE TOP OF CURB, NORTHEAST QUADRANT OWENS AND LAS VEGAS BLVD NORTH. ELEVATION: 1897.81'

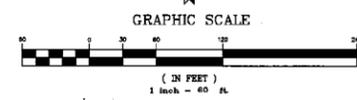



2770 SOUTH MARYLAND PARKWAY SUITE 510 LAS VEGAS, NEVADA 89109 (702) 733-7107




STATE OFFICE BUILDING

DEPARTMENT OF GENERAL SERVICES

SPWB JOB # 91-C9



MARTIN & MARTIN ARCHITECTS INC. 1709 N. CHARLESTON BLVD. SUITE 400 LAS VEGAS, NEVADA 89102 (702) 396-0005

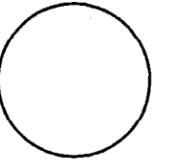

Check and verify all dimensions and report all errors to the Architect prior to commencing work. These drawings are not to be used for any other project without the written consent of the Architect. The Architect assumes no responsibility for any errors or omissions in these drawings or for any consequences arising therefrom. Copyright (c) 1993 Lucchesi Galati Architects, Inc. A Nevada Corporation.

Date: FEBRUARY 23, 1993 Project No.: 1095 Scale: 1"=40' Drawn By: R. YOUNG Revisions:

2-23-95 RECORD DRAWINGS

Sheet Title:


HORIZONTAL CONTROL PLAN NO. 1, (WEST)

Sheet Number:

C3.01


Table with columns: CURB, BARRI, LENGTH, ANCHOR, OTHER, BEARING, DIST. It lists various curb segments and their specifications.

Table with columns: LINE, DIRECTION, DISTANCE. It lists line segments and their bearings and distances.

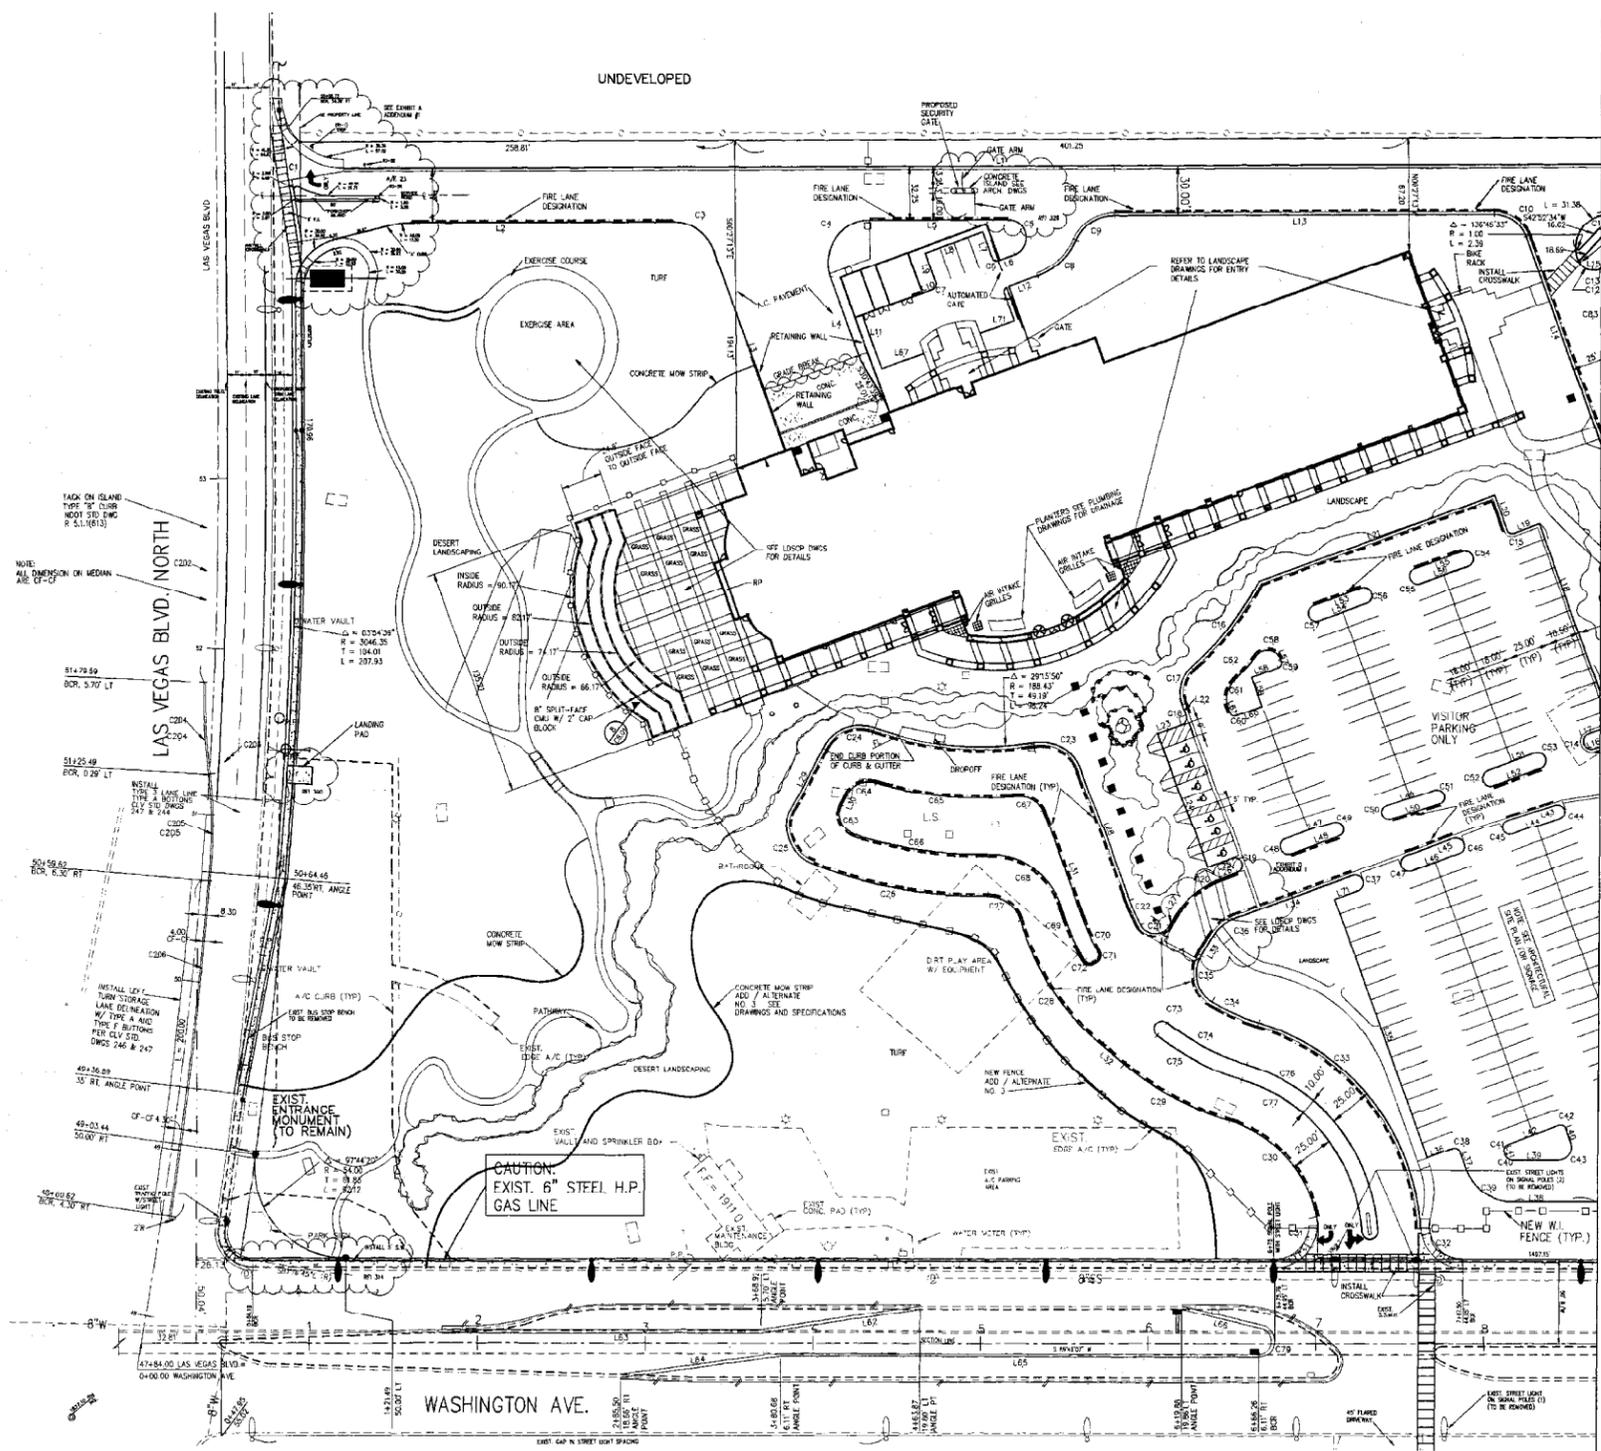

BENCHMARK: THE BENCHMARK FOR THIS PROJECT IS C.C.E.D. BENCHMARK NO. 700123596, BEING AN ALUMINUM PLATE AND NINET ON THE TOP OF THE CURB, NORTHEAST QUADRANT CORNER OF LAS VEGAS BLVD. NORTH AND LAS VEGAS BLVD. NORTH. ELEVATION = 1867.81

NOTE: ALL DIMENSIONS ARE TO BACK OF CURB UNLESS OTHERWISE NOTED. DIMENSION ON MEDIAN ISLAND ON LAS VEGAS BLVD. ARE CURB FACE TO CURB FACE.

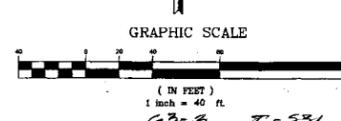

C3-8 . 7-531



2770 SOUTH MARYLAND PARKWAY
SUITE 510
LAS VEGAS, NEVADA 89109
(702) 733-7107




STATE OFFICE BUILDING

DEPARTMENT OF
GENERAL SERVICES

SPWB JOB # 91-C9

MARTIN & MARTIN
MARTIN & MARTIN
CIVIL ENGINEERS
1201 N. CHARLESTON BLVD.
SUITE 430
LAS VEGAS, NEVADA 89102
PHONE (702) 396-8005

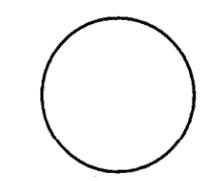

Check and verify all dimensions and report all errors to the Architect prior to commencing work. These drawings are not to be scaled. All drawings, specifications and copies thereof furnished by the Architect are to be used only with respect to this project and are not to be used on any other project without the written consent of the Architect. The Architect is not responsible for the accuracy of any information or data furnished by others. The Contractor is responsible for the accuracy of any information or data furnished by others. The Contractor is responsible for the accuracy of any information or data furnished by others. The Contractor is responsible for the accuracy of any information or data furnished by others.

Date: FEBRUARY 23, 1993
Project No: 1096
Scale: 1"=40'
Drawn By: R. YOUNG
Revisions:

2-23-95
RECORD DRAWINGS

Sheet Title:


HORIZONTAL CONTROL
PLAN NO. 2, (EAST)

Sheet Number:

C3.02

CURVE	RADIUS	LENGTH	TANGENT	CHORD	BEARING	DELTA
C03	7.50	14.40	10.71	12.29	S34.49/07 W	110.00/00
C04	3.00	4.71	3.60	4.24	N44.49/07 E	90.00/00
C05	5.00	8.11	6.50	7.24	S55.50/53 E	70.00/00
C06	3.00	4.71	3.60	4.24	S34.49/07 W	110.00/00
C07	3.00	4.71	3.60	4.24	N44.49/07 E	90.00/00
C08	5.00	8.11	6.50	7.24	S55.50/53 E	70.00/00
C09	7.50	14.40	10.71	12.29	S34.49/07 W	110.00/00
C10	3.00	4.71	3.60	4.24	N44.49/07 E	90.00/00
C11	5.00	8.11	6.50	7.24	S55.50/53 E	70.00/00
C12	7.50	14.40	10.71	12.29	S34.49/07 W	110.00/00
C13	3.00	4.71	3.60	4.24	N44.49/07 E	90.00/00
C14	5.00	8.11	6.50	7.24	S55.50/53 E	70.00/00
C15	7.50	14.40	10.71	12.29	S34.49/07 W	110.00/00
C16	3.00	4.71	3.60	4.24	N44.49/07 E	90.00/00
C17	5.00	8.11	6.50	7.24	S55.50/53 E	70.00/00
C18	7.50	14.40	10.71	12.29	S34.49/07 W	110.00/00
C19	3.00	4.71	3.60	4.24	N44.49/07 E	90.00/00
C20	5.00	8.11	6.50	7.24	S55.50/53 E	70.00/00
C21	7.50	14.40	10.71	12.29	S34.49/07 W	110.00/00
C22	3.00	4.71	3.60	4.24	N44.49/07 E	90.00/00
C23	5.00	8.11	6.50	7.24	S55.50/53 E	70.00/00
C24	7.50	14.40	10.71	12.29	S34.49/07 W	110.00/00
C25	3.00	4.71	3.60	4.24	N44.49/07 E	90.00/00
C26	5.00	8.11	6.50	7.24	S55.50/53 E	70.00/00
C27	7.50	14.40	10.71	12.29	S34.49/07 W	110.00/00
C28	3.00	4.71	3.60	4.24	N44.49/07 E	90.00/00
C29	5.00	8.11	6.50	7.24	S55.50/53 E	70.00/00
C30	7.50	14.40	10.71	12.29	S34.49/07 W	110.00/00
C31	3.00	4.71	3.60	4.24	N44.49/07 E	90.00/00
C32	5.00	8.11	6.50	7.24	S55.50/53 E	70.00/00
C33	7.50	14.40	10.71	12.29	S34.49/07 W	110.00/00
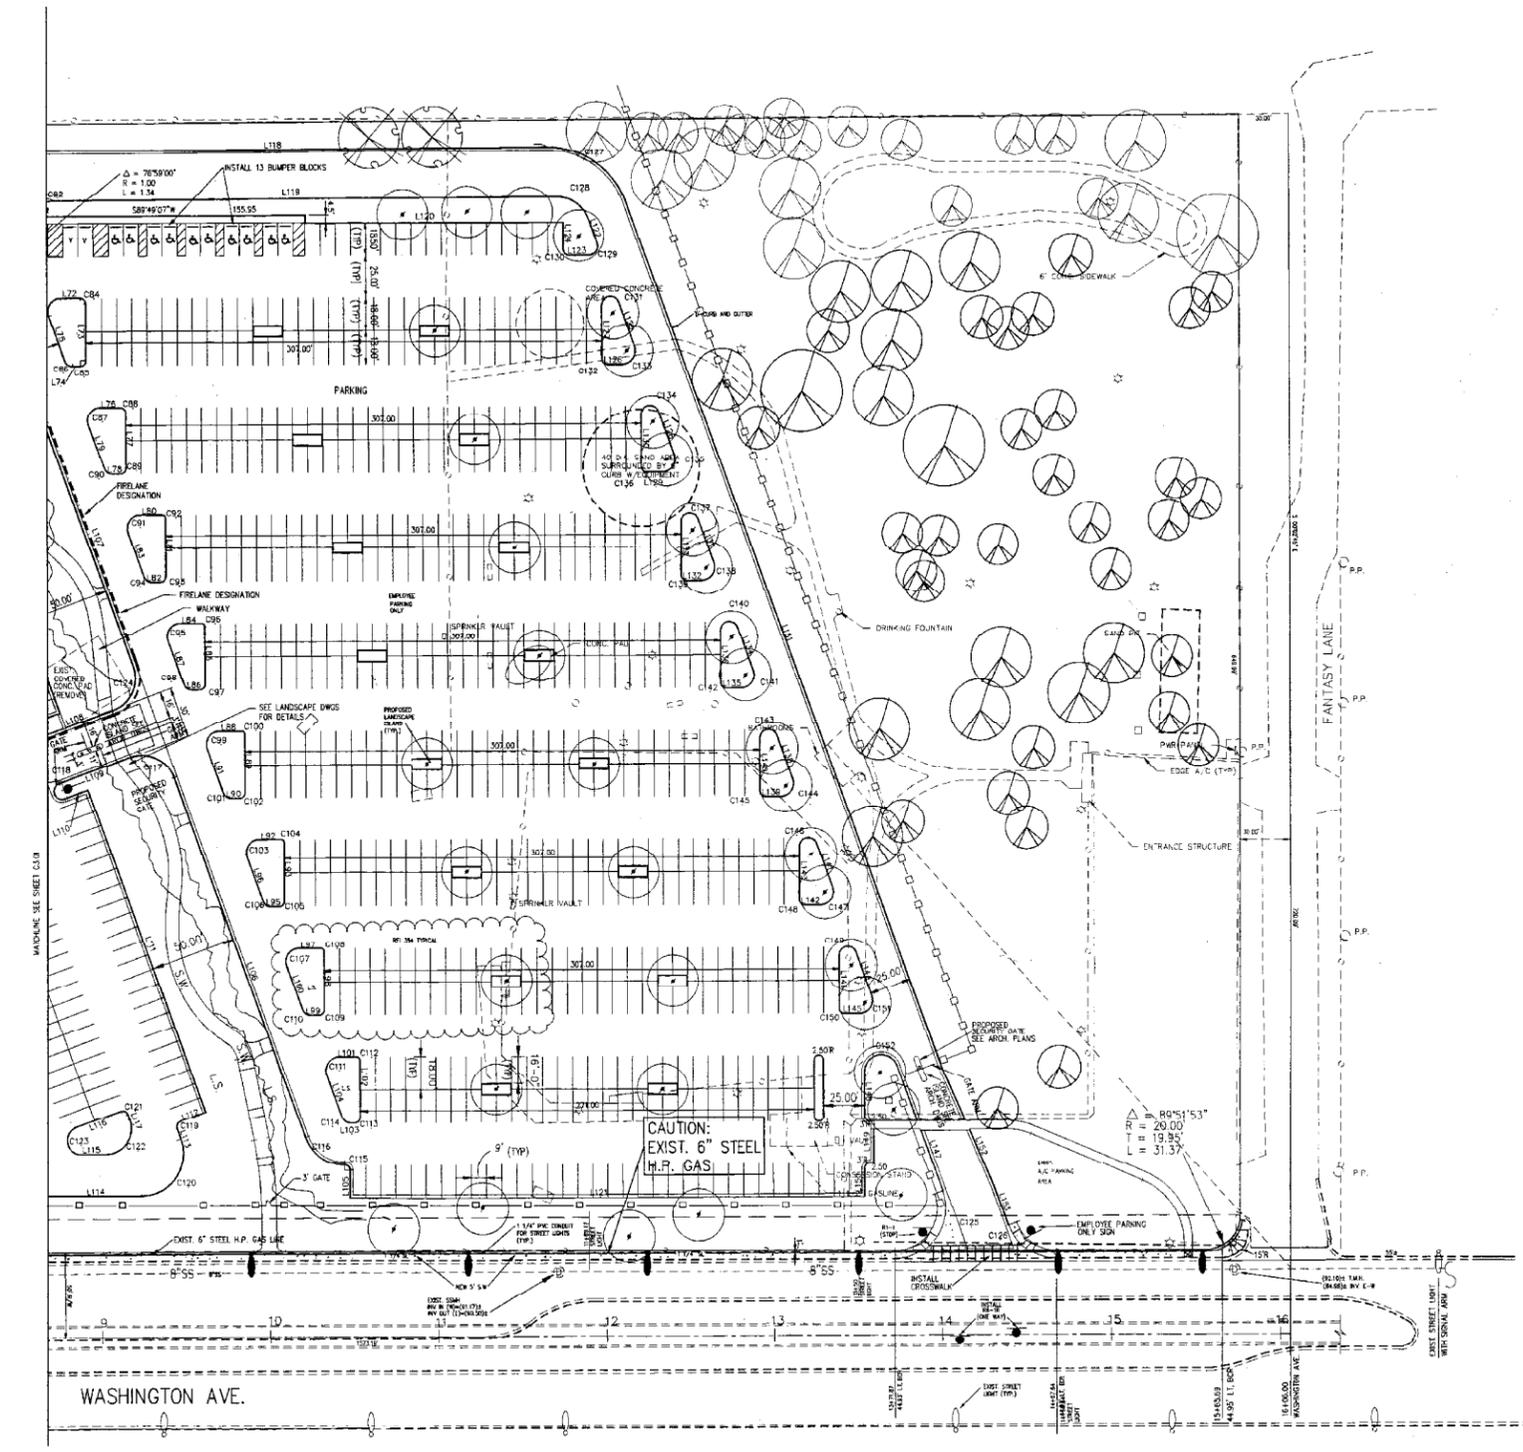

BENCHMARK
THE BENCHMARK FOR THIS PROJECT IS C.C.E.D. BENCHMARK NO. 7020232000, BEING AN ALUMINUM PLATE AND NIVET ON THE TOP OF THE CURB, NORTHEAST QUADRANT CORNER AND 1/4\"/>

MARTIN AND MARTIN ASSUMES NO RESPONSIBILITY FOR UTILITY LOCATIONS. THE UTILITIES SHOWN ON THESE DRAWINGS HAVE BEEN OBTAINED FROM THE MOST AVAILABLE INFORMATION. IT IS HOWEVER THE CONTRACTOR'S RESPONSIBILITY TO FIELD VERIFY THE LOCATION OF ALL UTILITIES PRIOR TO THE COMMENCEMENT OF ANY CONSTRUCTION. CONTRACTOR TO FIELD VERIFY ALL EXISTING SITE CONDITIONS PRIOR TO CONSTRUCTION. IF A CONFLICT EXISTS BETWEEN WHAT IS SHOWN ON THESE DRAWINGS AND WHAT EXISTS IN THE FIELD, THE CONTRACTOR IS TO NOTIFY THE ARCHITECT OR ENGINEER IMMEDIATELY.

NOTE
#1: DIMENSIONS ARE TO BACK OF CURB UNLESS OTHERWISE NOTED

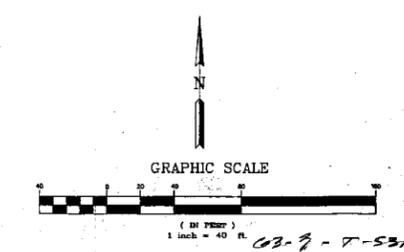



LUCCHESI GALATI ARCHITECTS

2770 SOUTH MARYLAND PARKWAY SUITE 510 LAS VEGAS, NEVADA 89109 (702) 733-7107




STATE OFFICE BUILDING

DEPARTMENT OF GENERAL SERVICES

SPWB JOB # 91-C9

MARTIN & MARTIN CIVIL ENGINEERS 1701 W. GUNBLETON BLVD. SUITE 450 LAS VEGAS, NEVADA 89102 PHONE (702) 388-8005

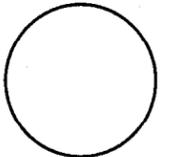

Check and verify all dimensions and report all errors to the Architect prior to commencing work. These drawings are not to be used for any other project without the written consent of the Architect. The Architect is not responsible for any errors or omissions in these drawings. The contractor is responsible for obtaining all necessary permits and for complying with all applicable laws, codes, and regulations. The contractor is also responsible for protecting all existing utilities and structures on the site. The contractor shall be responsible for all costs of construction, including but not limited to, labor, materials, and equipment. The contractor shall also be responsible for obtaining all necessary insurance and bonding. The contractor shall be responsible for all safety and health matters on the site. The contractor shall be responsible for all environmental matters on the site. The contractor shall be responsible for all quality control matters on the site. The contractor shall be responsible for all record drawing matters on the site. The contractor shall be responsible for all other matters on the site. Copyright Lucchesi Galati Architects, Inc. 1992

Date: FEBRUARY 23, 1993
Project No: 1096
Scale: 1"=30'
Drawn By: R. YOUNG / C.H.
Revisions:

2-23-95
RECORD DRAWINGS

Sheet Title:

GRADING PLAN
NO. 2, EAST

Sheet Number:

C4.02

EXISTING PROPOSED		EXISTING PROPOSED	
—	RIGHT-OF-WAY	—	SCREEN / RETAINING WALL
—	CENTERLINE	—	WIRE OR CHAIN LINK FENCE
—	WATER LINE	—	TRASH ENCLOSURE
—	SANITARY SEWER LINE	—	GRADE BREAK
—	GAS LINE	—	CONTOUR LINE
—	STORM DRAIN	—	FF+0.00 FINISH FLOOR
—	POWER LINE / POWER POLE	—	CLEANOUT INVERT ELEVATION
—	TELEPHONE LINE	—	FLOW LINE
—	FIRE HYDRANT	—	FINISH GRADE
—	WATER VALVE	—	BACK OF SIDEWALK
—	METERS / PULL BOXES	—	B.S.W. B.S.W.
—	REDUCER	—	TOP OF CURB
—	MANHOLE	—	TOP OF WALL
—	CLEANOUT	—	A.C. PAVING
—	STREET LIGHT	—	TYPE "L" CURB & GUTTER
—	EXIST. ON-SITE AREA LIGHT	—	TYPE "A" CURB
—	HANDRAIL	—	R.D. ROOF DRAIN
		—	END RETAINING WALL
		—	PAVE
		—	FIRELANE DESIGNATION

BENCHMARK


THE BENCHMARK FOR THIS PROJECT IS C.C.E.D. BENCHMARK NO. 70D123SSW6; BEING AN ALUMINUM PLATE AND RIVET ON THE TOP OF THE CURB, NORTHEAST QUADRANT OWENS AND LAS VEGAS BLVD. NORTH. ELEVATION = 1897.81

MARTIN AND MARTIN ASSUMES NO RESPONSIBILITY FOR EXISTING UTILITY LOCATIONS. THE UTILITIES SHOWN ON THIS DRAWING HAVE BEEN PLOTTED FROM THE BEST AVAILABLE INFORMATION. IT IS, HOWEVER THE CONTRACTORS RESPONSIBILITY TO FIELD VERIFY THE LOCATION OF ALL UTILITIES PRIOR TO THE COMMENCEMENT OF ANY CONSTRUCTION. CONTRACTOR TO FIELD VERIFY ALL EXISTING SITE CONDITIONS PRIOR TO CONSTRUCTION. IF A CONFLICT EXISTS BETWEEN WHAT IS SHOWN ON THESE DRAWINGS AND WHAT EXISTS IN THE FIELD, THE CONTRACTOR IS TO NOTIFY THE ARCHITECT OR ENGINEER IMMEDIATELY.

DISTURBED (SANDY AND SILT MATERIALS) SHOULD BE PROTECTED WITH BURLAP OR OTHER EROSION CONTROL FABRIC/MATERIAL, UNLESS OTHERWISE SPECIFIED BY LANDSCAPE DRAWINGS AND SPECIFICATIONS, OR THE SOILS REPORT.

CONTRACTOR SHALL DETERMINE HIS OWN FOOTING OR BASEMENT EXCAVATION QUANTITIES, EVEN THOUGH SHOWN ON ROUGH GRADING PLANS. ADDITIONALLY, STRUCTURE BACKFILL COSTS SHOULD BE INCLUDED IN THE COST OF THE STRUCTURE, UNLESS OTHERWISE SPECIFIED IN THE CONTRACT DOCUMENTS.



CONTRACTOR SHALL NOTIFY MARTIN & MARTIN WITHIN 24 HOURS OF OMISSIONS AND ERRORS DISCOVERED ON PLANS. MARTIN & MARTIN WILL REVISE AND RE-ISSUE DRAWINGS AS SOON AS POSSIBLE. MARTIN & MARTIN WILL NOT BE RESPONSIBLE FOR ANY "CORRECTIVE" WORK DONE BY OTHERS.

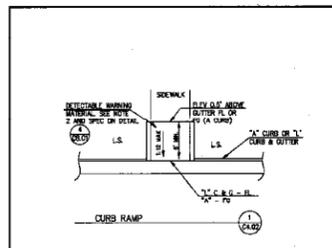

- 1 REMOVE EXIST. DWY. & REPLACE W/ "L" C&G
- 2 REMOVE AND REPLACE DAMAGED "L" CURB
- 3 9" DEPRESSED CURB SECTION, DEPRESSED TO ALLOW POSITIVE DRAINAGE WITH NO PONDING ALLOWED

NOTE:

- 1. ALL REMOVED AND REPLACED C&G LENGTHS ARE APPROXIMATE.
- 2. N.O.D.T. OWNERSHIP IS TO BACK OF SIDEWALK ALONG LV BLVD.
- 3. ADJUST ALL PULLBOXES, SIGNAL BOXES, ECT. TO TOP OF S.W. ELEV.
- 4. REFER TO DESIGN LEVEL GEOTECHNICAL INVESTIGATION BY CONVERSE CONSULTANTS INC. PROJECT NO. 91-33402-02 DATED MAY 26, 1992 FOR ALL GRADING AND COMPACTION RECOMMENDATIONS.

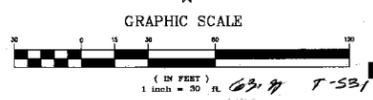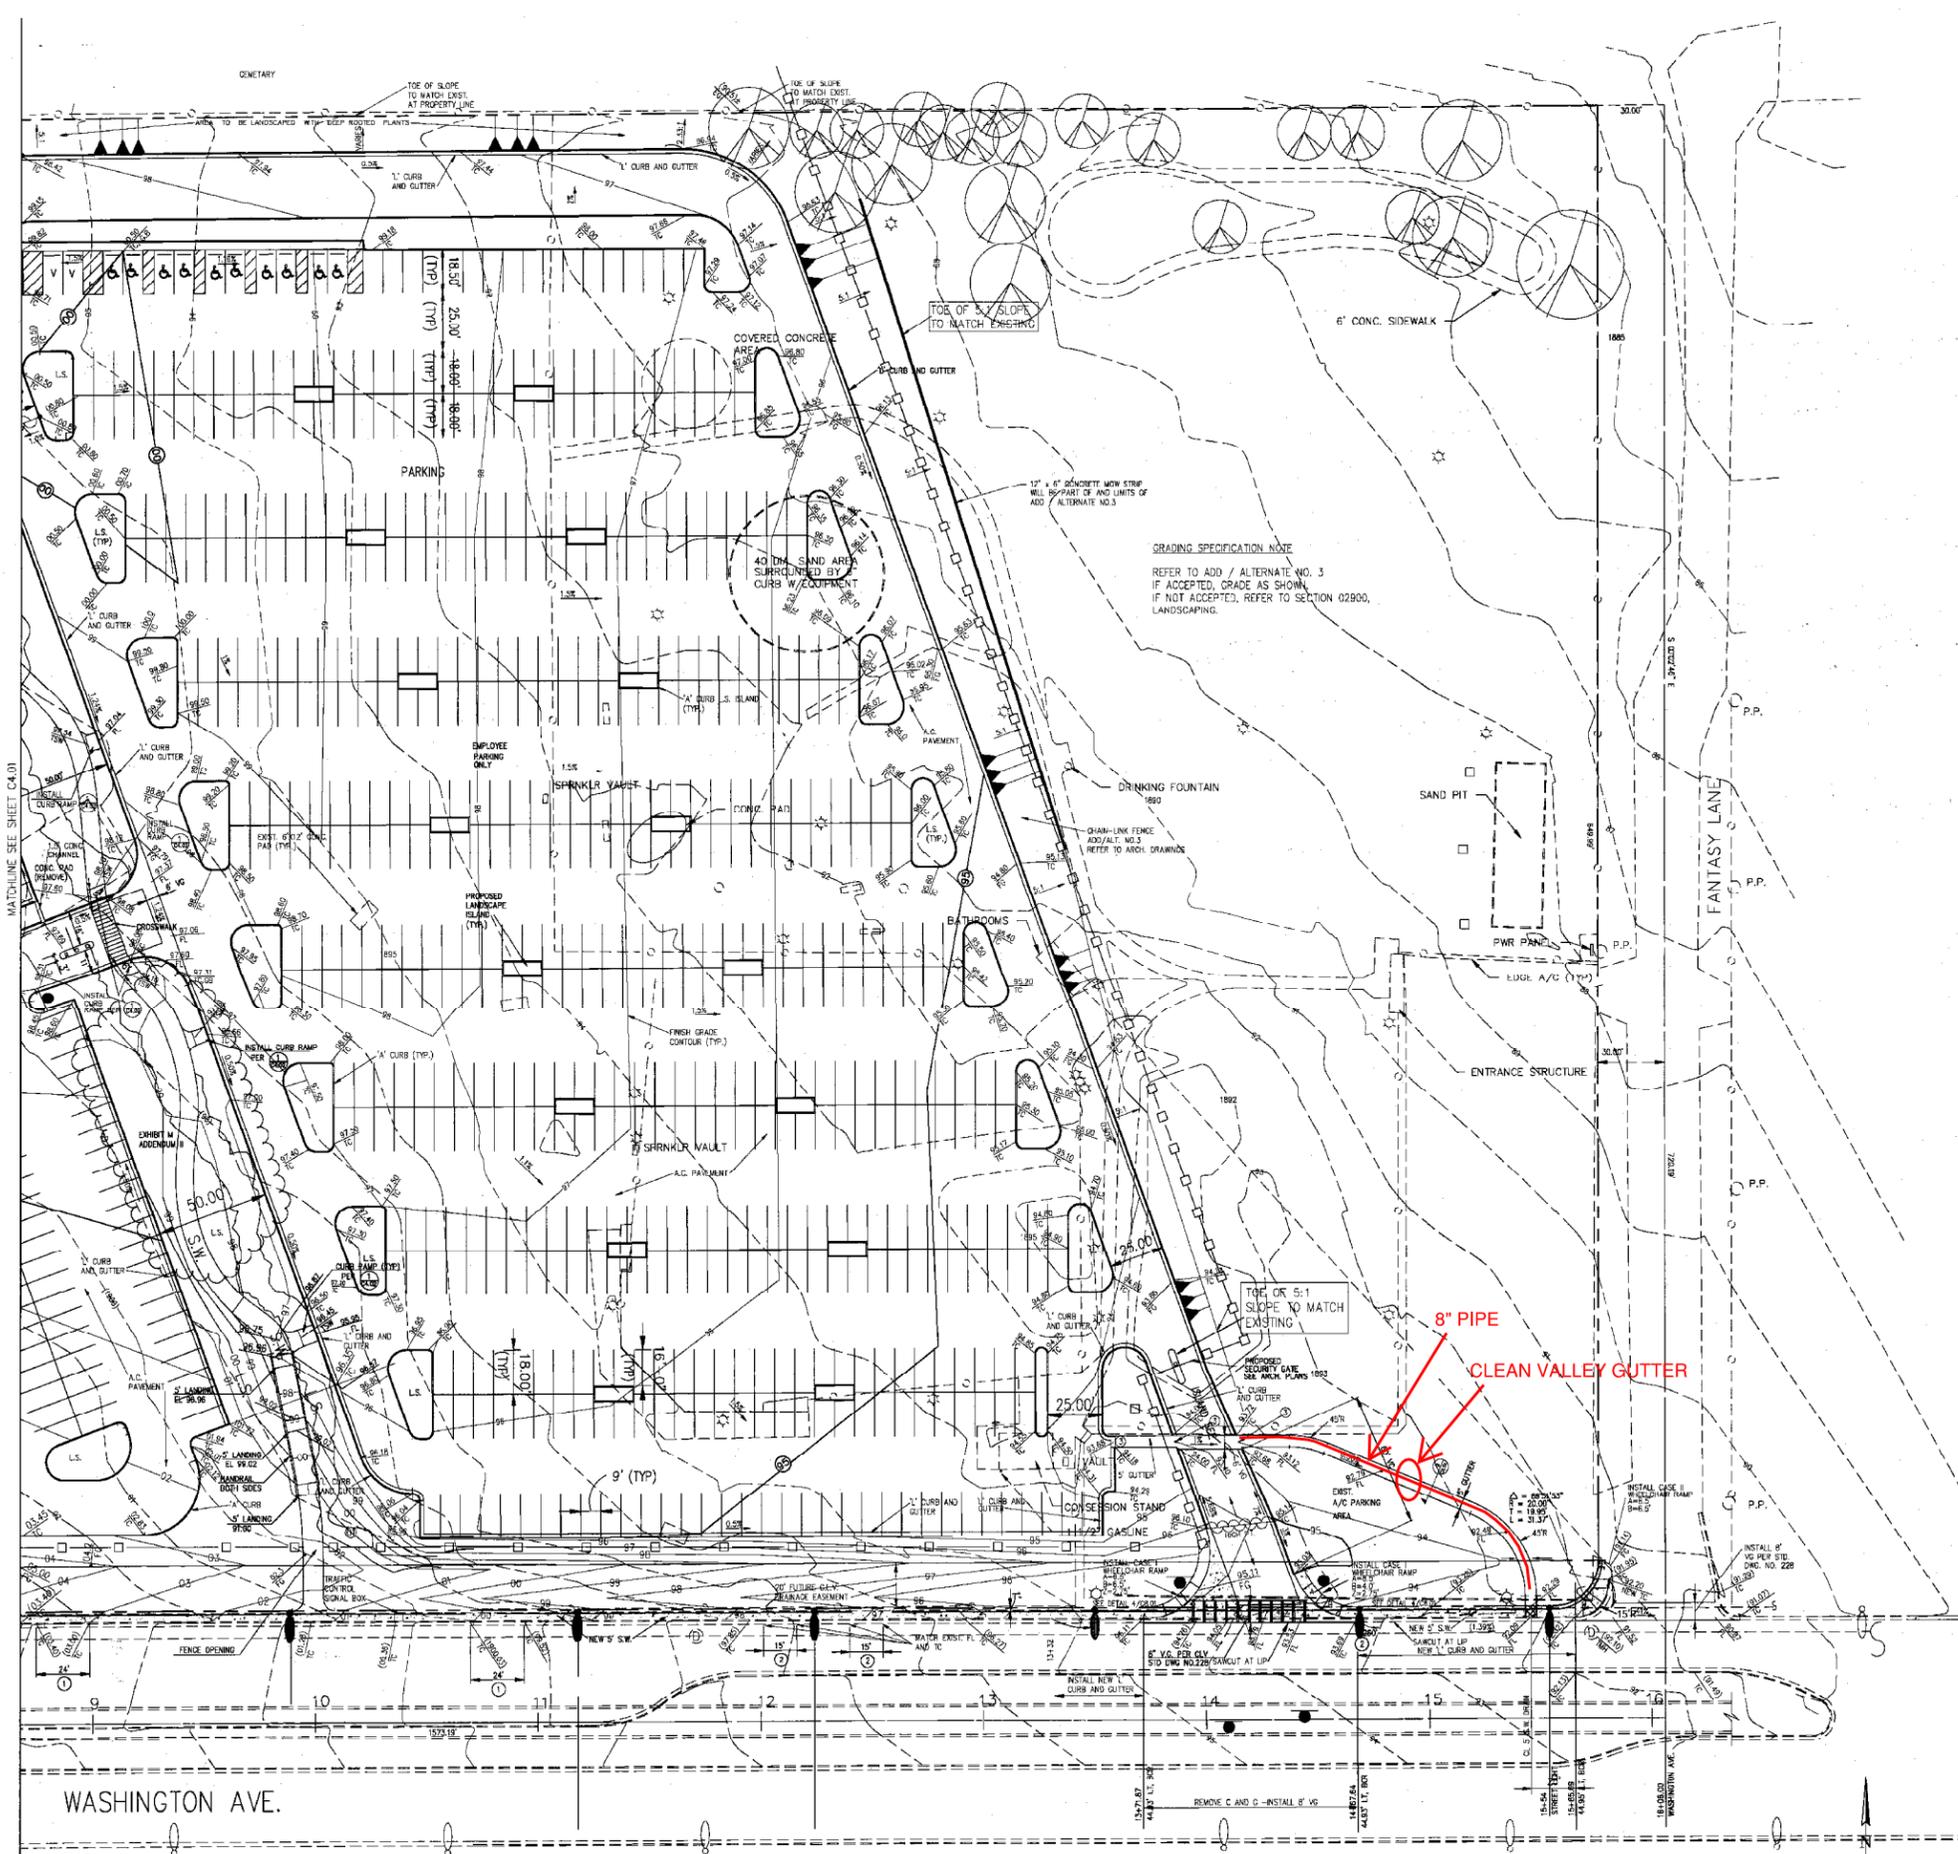

(IN FEET)
1 inch = 30 ft. 63.9 T-531



2770 SOUTH MARYLAND PARKWAY SUITE 510 LAS VEGAS, NEVADA 89109 (702) 733-7107




STATE OFFICE BUILDING DEPARTMENT OF GENERAL SERVICES

SPWB JOB # 91-C9

ELECTRIC CAR CHARGER

MARTIN & MARTIN CIVIL ENGINEERS 1701 W. CHARLESTON BLVD. SUITE 400 LAS VEGAS, NEVADA 89102 PHONE: (702) 388-8005

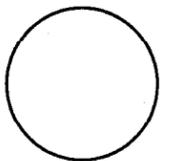

Check and verify all dimensions and report all errors to the Architect prior to commencing work. These drawings are not to be used for any other project without the written consent of the Architect. The Architect is not responsible for any errors or omissions in these drawings. The contractor is responsible for verifying all existing site conditions prior to construction. If a conflict exists between what is shown on these drawings and what exists in the field, the contractor is to notify the Architect or Engineer immediately.

Date: FEBRUARY 23, 1993 Project No.: 1096 Scale: 1"=30' Drawn By: R. YOUNG / C.H. Revisions:


2-23-95 RECORD DRAWINGS

Sheet Title:

ON-SITE UTILITY PLAN (WEST)

Sheet Number:

C5.01

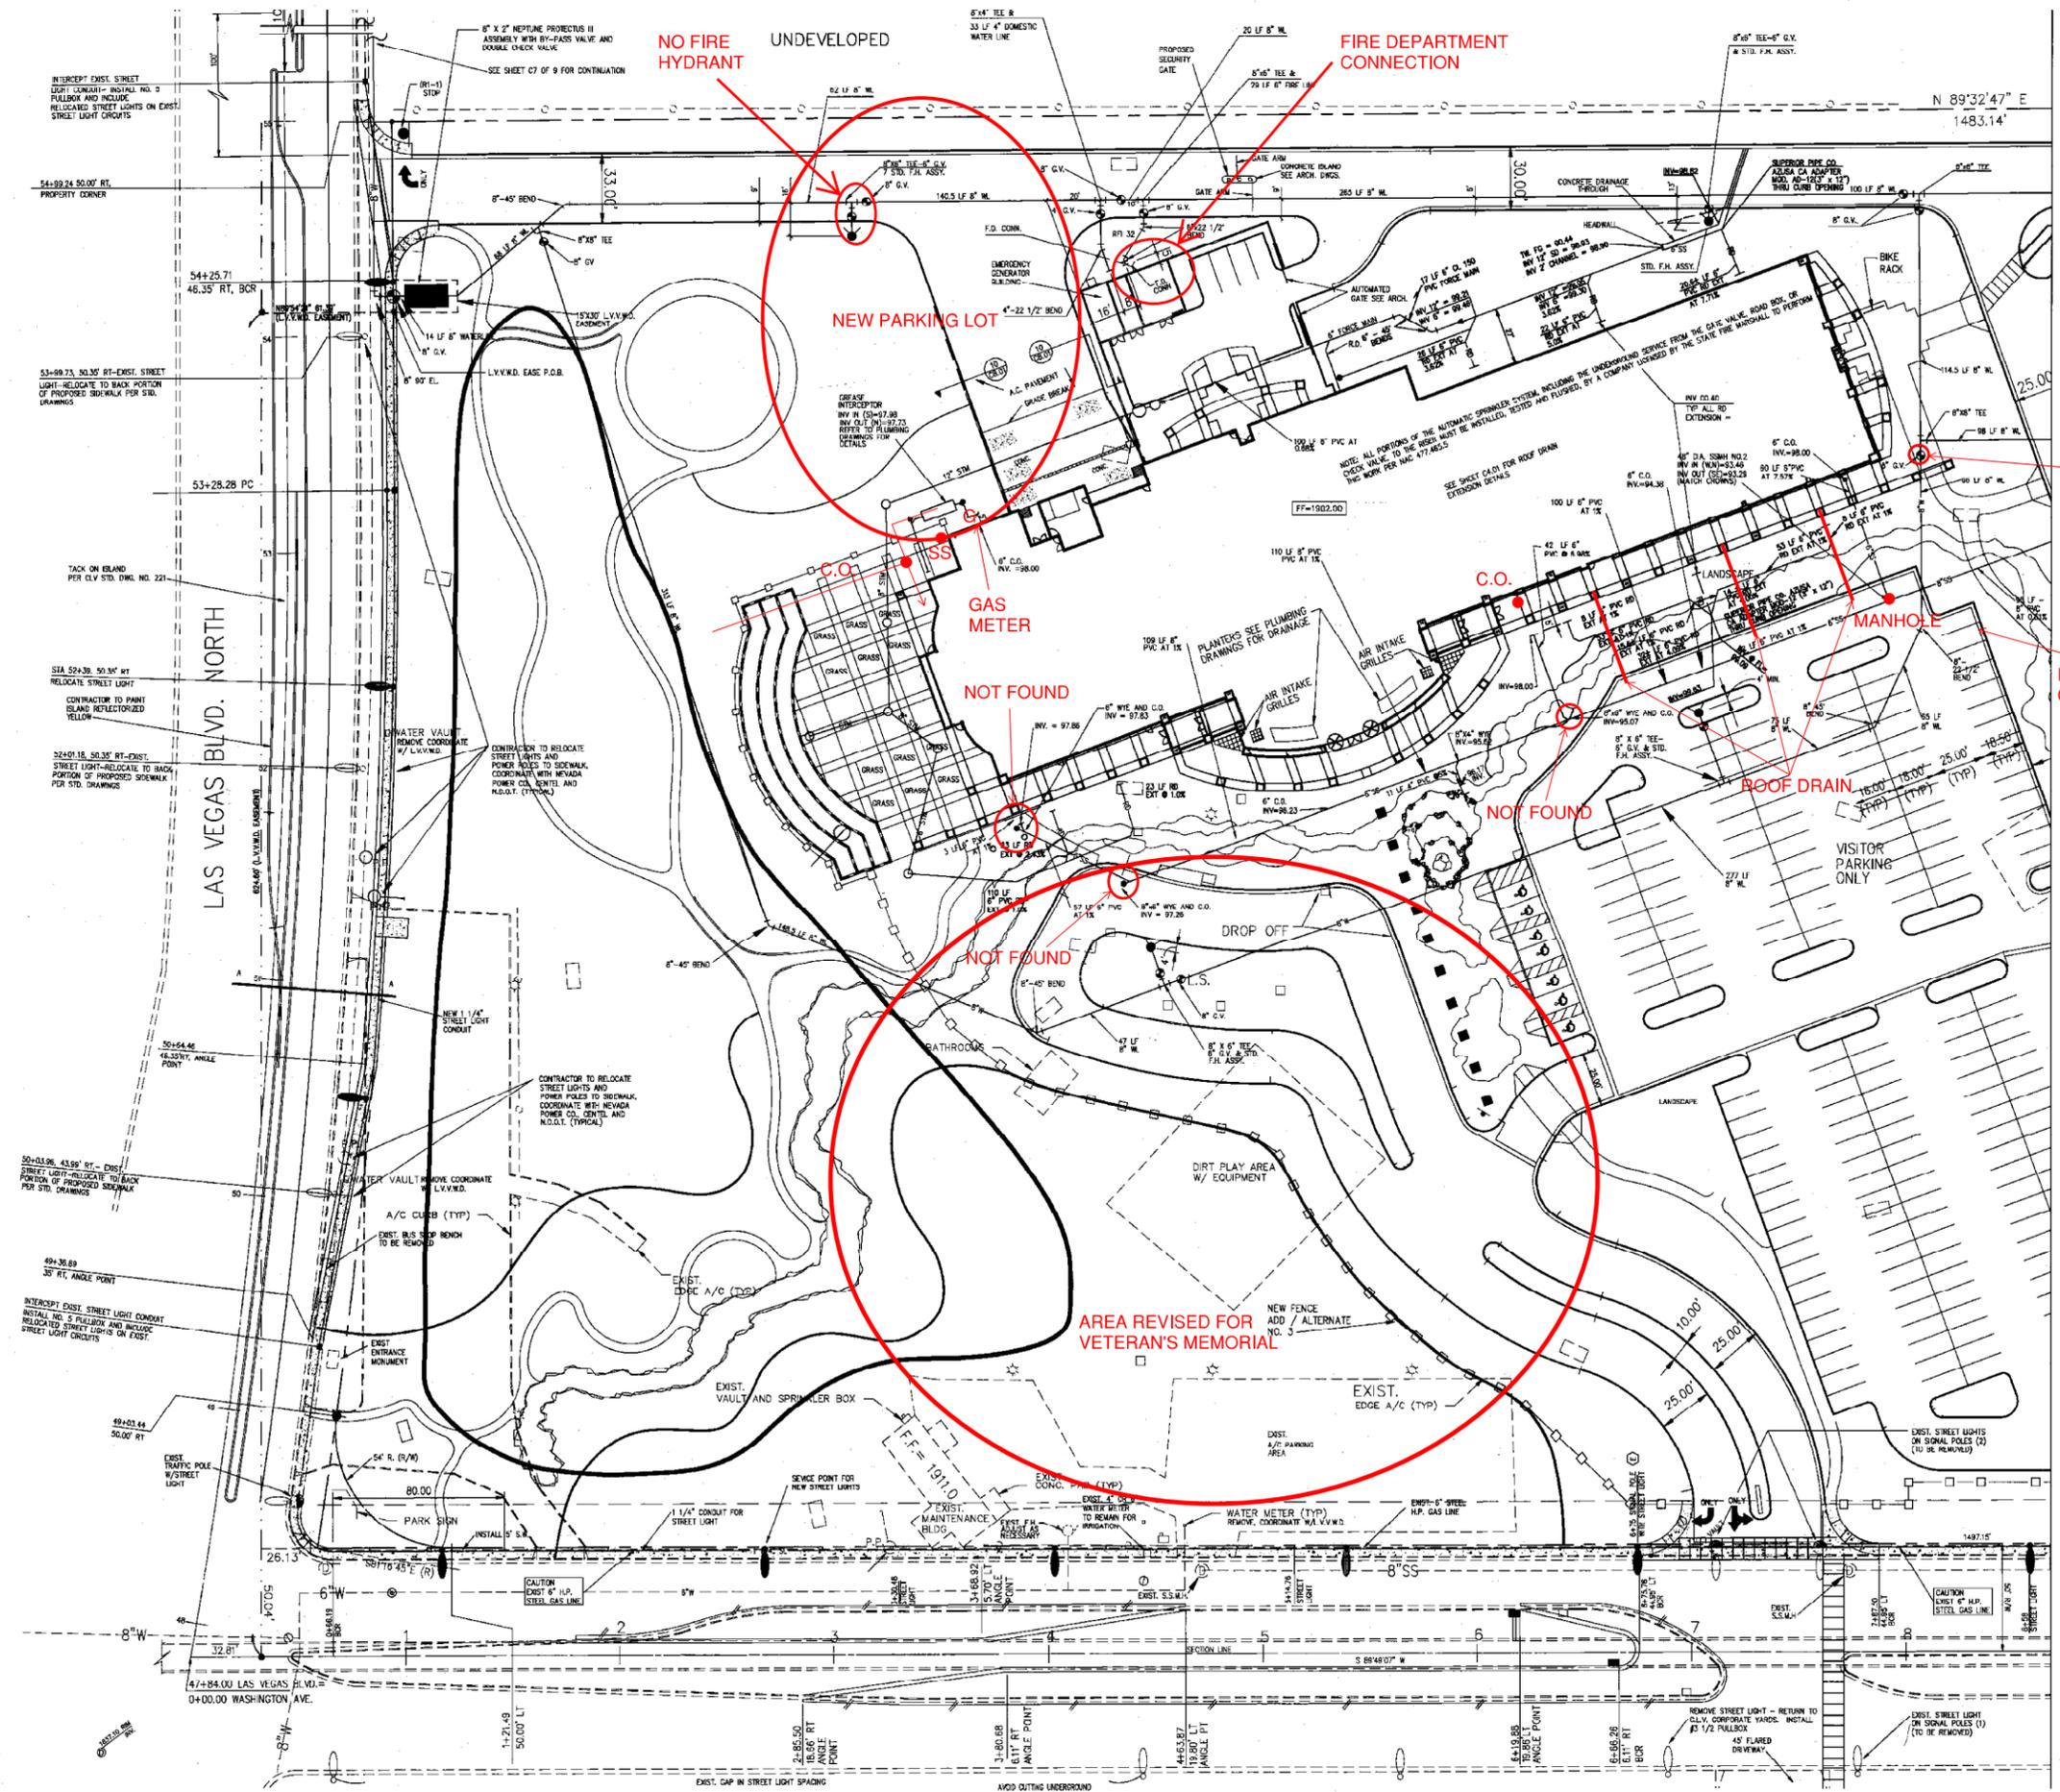

NO FIRE HYDRANT

FIRE DEPARTMENT CONNECTION

NEW PARKING LOT

GAS METER

NOT FOUND

NOT FOUND

AREA REVISED FOR VETERAN'S MEMORIAL

NOT FOUND

NOT FOUND

ROOF DRAIN

MANHOLE


EXISTING CASHMANS FIELD

BENCHMARK THE BENCHMARK FOR THIS PROJECT IS C.C.E.D. BENCHMARK NO. 70012355W6; BEING AN ALUMINUM PLATE AND RIVET ON THE CURB, NORTHEAST QUADRANT OWENS AND LAS VEGAS BLVD. NORTH. ELEVATION = 1897.81 ALL UTILITIES PRIOR TO THE COMMENCEMENT OF ANY CONSTRUCTION.

Call before you Dig 1-800-227-2600

MARTIN & MARTIN ASSUMES NO RESPONSIBILITY FOR EXISTING UTILITY LOCATIONS. THE UTILITIES SHOWN ON THIS DRAWING HAVE BEEN PLOTTED FROM THE BEST AVAILABLE INFORMATION. IT IS, HOWEVER, THE CONTRACTOR'S RESPONSIBILITY TO FIELD VERIFY THE LOCATION OF ALL UTILITIES PRIOR TO THE COMMENCEMENT OF ANY CONSTRUCTION. CONTRACTOR TO FIELD VERIFY ALL EXISTING SITE CONDITIONS PRIOR TO CONSTRUCTION. IF A CONFLICT EXISTS BETWEEN WHAT IS SHOWN ON THESE DRAWINGS AND WHAT EXISTS IN THE FIELD, CONTRACTOR IS TO NOTIFY THE ARCHITECT OR ENGINEER IMMEDIATELY.

GRAPHIC SCALE

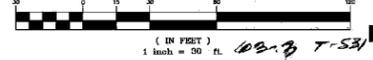



2770 SOUTH MARYLAND PARKWAY SUITE 510 LAS VEGAS, NEVADA 89109 (702) 733-7107




STATE OFFICE BUILDING

DEPARTMENT OF GENERAL SERVICES

SPWB JOB # 91-C9

MARTIN & MARTIN CIVIL ENGINEERS 1701 W. CHARLESTON BLVD. SUITE 400 LAS VEGAS, NEVADA 89102 PHONE (702) 396-4000

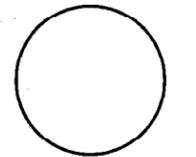

Check and verify all dimensions and report all errors to the architect prior to commencing work. These drawings are not to be used for any other project without the written consent of the architect...

Date: FEBRUARY 23, 1993 Project No.: 1096 Scale: AS SHOWN Drawn By: R. YOUNG / C.H. Revisions:


2-23-95 RECORD DRAWINGS

Sheet Title:

OFF-SITE WATER PLAN

Sheet Number:

C6.01

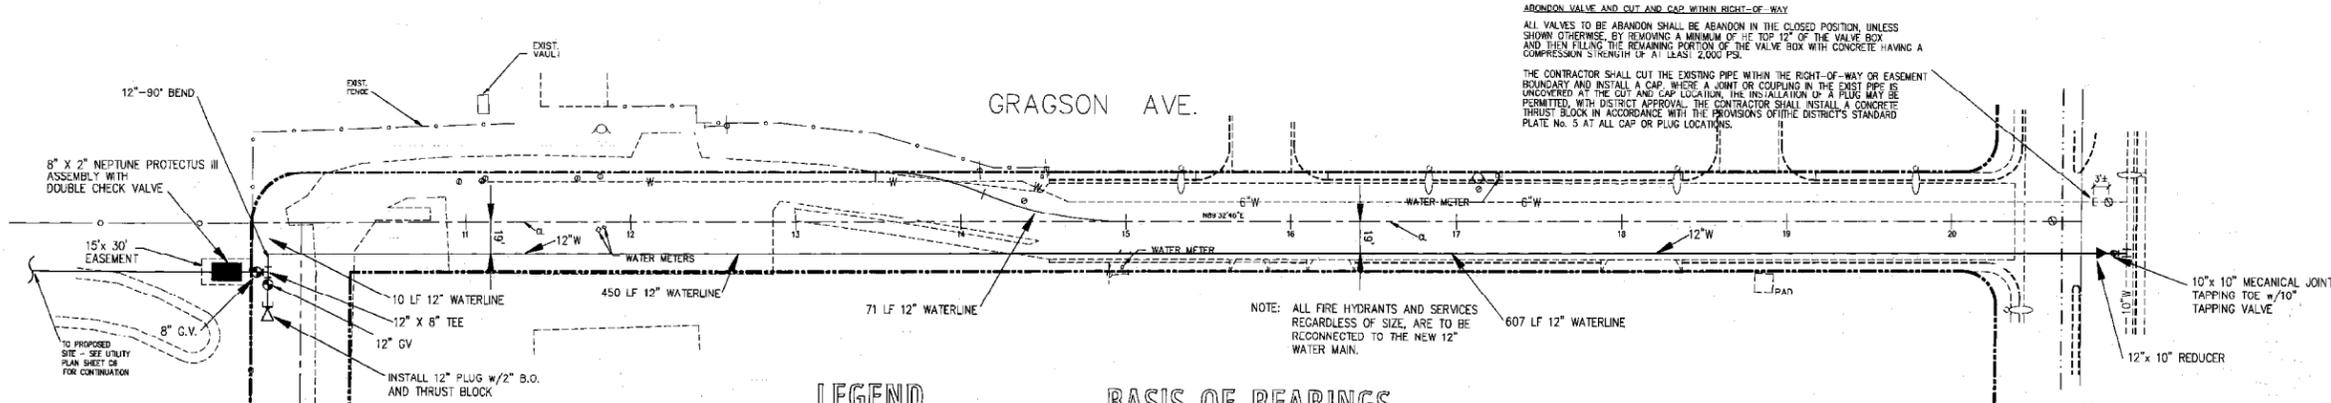

LEGEND

- SECTION LINE
CENTERLINE
BOUNDARY LINE
PROPERTY LINE
AREA LIGHT
STREET LIGHT (EXIST.)
FIRE HYDRANT (EXIST.)
EXIST. FENCE

BASIS OF BEARINGS

THE BASIS OF BEARINGS FOR THIS SURVEY IS THE EAST-WEST CENTER OF SECTIONLINE OF SECTION 26, TOWNSHIP 20 SOUTH, RANGE 61 EAST, M.D.M., AS SHOWN IN FILE 60, PAGE 51, OF RECORDED SURVEYS...

BENCHMARK

THE BENCHMARK FOR THIS SURVEY IS C.C.E.D. BENCHMARK # 7C0123SSW6, BEING AN ALUM. PLATE AND RIVET ON THE TOP OF CURB, NORTHEAST QUADRANT OWENS AND LAS VEGAS BLVD NORTH.

ELEVATION: 1897.81'

LAS VEGAS VALLEY WATER DISTRICT NOTES

- 1. NO WORK SHALL BEGIN ON THE WATER PLANS UNTIL THEY HAVE BEEN RELEASED FOR CONSTRUCTION BY THE LVVWD...
2. CALL BEFORE YOU DIG 1-800-227-2600.
3. ALL WORK SHALL CONFORM TO LVVWD LATEST STANDARD PLATES...
4. ALL WORK EXCEPT AS MODIFIED HEREON OR BY NOTE 3, SHALL BE DONE IN ACCORDANCE WITH THE MOST CURRENT DRAFT OR ADDITION OF THE UNIFORM STANDARD SPECIFICATIONS FOR PUBLIC WORKS CONSTRUCTION OFF-SITE IMPROVEMENTS, CLARK COUNTY AREA.
5. DISTRICT APPROVED SERVICE SADDLES OR TAPPED COLLARS SHALL BE REQUIRED ON ALL 3/4" AND 1" SERVICE LATERALS...
6. COPPER SERVICE LATERALS: ALL 3/4" TO 2" SERVICE LATERALS SHALL BE OF COPPER TUBING...
7. THE MAXIMUM ALLOWABLE JOINT DEFLECTION FOR ACP AND DUCTILE IRON PIPE SHALL BE AS FOLLOWS:

Table with columns: PIPE SIZES, ACP, DUCTILE IRON SLIP JOINT, DUCTILE IRON MECHANICAL JOINT. Rows for 6 inch, 8-12 inch, 14-16 inch, 18-24 inch.

ON PVC PIPE, THE MAXIMUM OFFSET FOR A 20' LENGTH OF FACTORY BELLED PIPE SHALL BE 16 INCHES FOR 6" PIPE, 12 INCHES FOR 8" PIPE, AND 9 INCHES FOR 10" AND 12" PIPE.


IF THESE OFFSETS CONFLICT WITH THE PIPE MANUFACTURERS RECOMMENDATION, THE MORE STRINGENT REQUIREMENT SHALL APPLY.

- 8. ALL WATER METER BOXES SHALL BE LOCATED OUTSIDE OF DRIVEWAY AREAS.
9. ALL VALVES SHALL BE LOCATED OUTSIDE OF DRIVEWAYS AND VALLEY GUTTERS.
10. DETECTOR TAPE SHALL BE REQUIRED IN ACCORDANCE WITH STANDARD PLATE NO. 27 WHERE INDICATED, AND AS FOLLOWS:
A) OVER ALL MAINS NOT INSTALLED 6 FEET FROM BACK OF CURB
B) OVER ALL SERVICE LATERALS NOT INSTALLED AT RIGHT ANGLES TO MAIN.
11. ALL WATER MAINS SHALL BE PRESSURE TESTED AT 200 PSI FOR A CONTINUOUS TWO HOUR PERIOD...
12. ALL WATER MAINS SHALL BE DISINFECTED, FLUSHED, AND AN ACCEPTABLE HEALTH SAMPLE OBTAINED...
13. CONTRACTOR TO OBTAIN ALL METERS 2" AND SMALLER FROM LVVWD CENTRAL STORES...

APPROVALS


Approval form with fields for FIRE FLOW = 2,500 GPM, C.C. FIRE DEPARTMENT, LAS VEGAS VALLEY WATER DISTRICT, and DATE.

ROAD WAY PATCHBACK-RFI 03

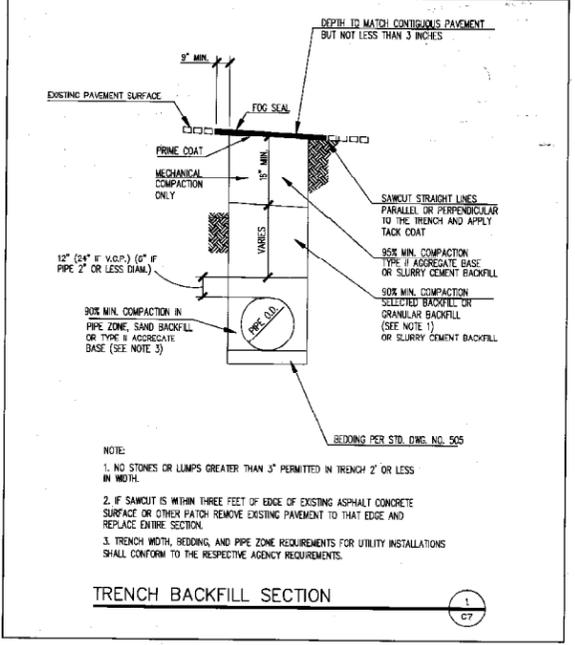

- 1. NO STONES OR LUMPS GREATER THAN 3" PERMITTED IN TRENCH 2' OR LESS IN WIDTH.
2. IF SAWCUT IS WITHIN THREE FEET OF EDGE OF EXISTING ASPHALT CONCRETE SURFACE OR OTHER PATCH REMOVE EXISTING PAVEMENT TO THAT EDGE AND REPLACE ENTIRE SECTION.
3. TRENCH WIDTH, BEDDING, AND PIPE ZONE REQUIREMENTS FOR UTILITY INSTALLATIONS SHALL CONFORM TO THE RESPECTIVE AGENCY REQUIREMENTS.

TRENCH BACKFILL SECTION

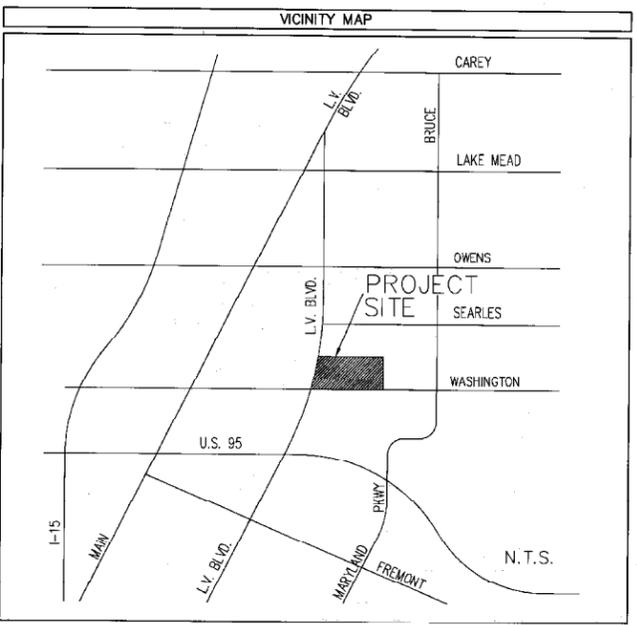

63-917-581

FANTASY LANE

- ALL SERVICE LATERALS 2" AND SMALLER MAY BE EXTENDED, PROVIDED THE FOLLOWING CRITERIA IS MET:
1. LATERAL CAN ONLY BE EXTENDED IF CONNECTING TO COPPER.
2. LATERAL MUST BE INSTALLED AT 90 DEGREES TO MAIN.
3. EXISTING SERVICE LATERAL THAT IS NOT COPPER AND IS TO BE ABANDONED FROM THE EXISTING WATER MAIN, SHALL HAVE THE CORPORATION STOP TURNED OFF AT THE MAIN...

SEARLES AVENUE

INSTALLATION OF METER AND VAULT

THE METER(S) AND VAULT(S) WITH NON-Traffic BEARING COVER(S) SHALL BE INSTALLED IN ACCORDANCE WITH THE ATTACHED DETAIL AND WITH STANDARD VAULT DRAWING C-475, LATEST REVISION.

ANY BLOCK WALL OR OTHER FENCE MATERIAL SHALL BE DESIGNED AND CONSTRUCTED AROUND THE OUTSIDE OF THE EASEMENT(S), SO AS TO ALLOW THE DISTRICT DIRECT ACCESS TO THE VAULT(S) FROM THE ADJACENT RIGHT-OF-WAY.




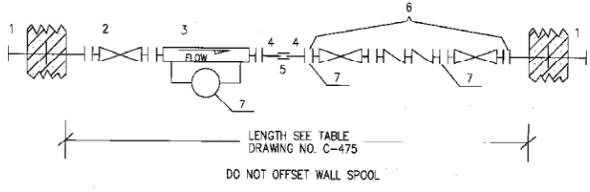


Table with columns: ITEM NO., DESCRIPTION, QTY. Lists items like FLANGED SCHED 40 FABRICATED STEEL EPOXY COATED AND LINED WALL SPOOL WITH THRUST RING, FLANGED GATE VALVE, etc.


NOTES: ALL PIPING, FITTINGS, AND APPURTENANCES SHALL CONFORM TO APPLICABLE DISTRICT SPECIFICATIONS.


THIS INSTALLATION IS FOR USE ONLY IN SYSTEMS HAVING ANOTHER SOURCE OF SUPPLY.

EXIST MORTUARY

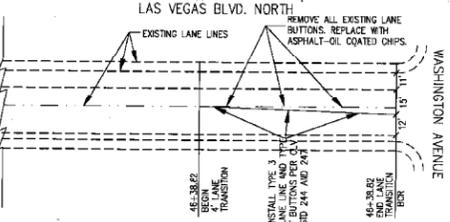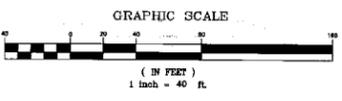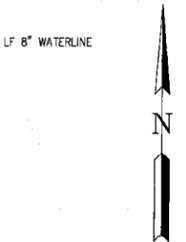

LAS VEGAS BLVD. NORTH

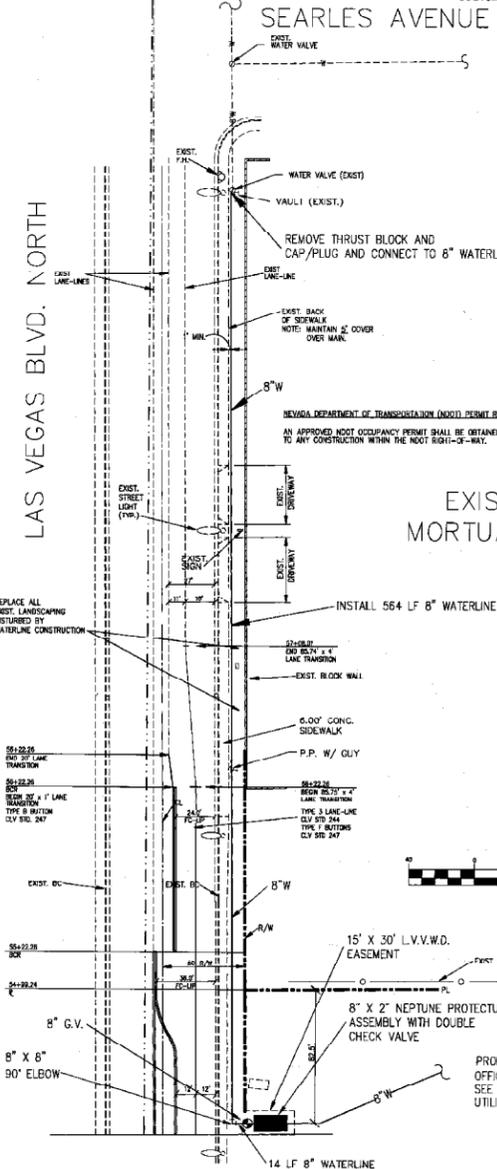

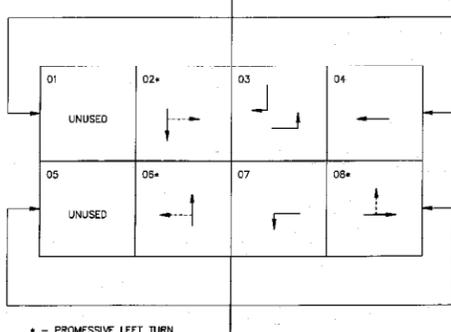

PROPOSED PHASE DIAGRAM

PROPOSED POLE SCHEDULE												
NO.	STATION	TYPE	SIGNALS (VEH)			SIGNALS (PED)			PED. PUSH BUTTON			
			QUAD.	ARM	LENGTH	QUAD.	ARM	LENGTH	QUAD.	ARM	LENGTH	
E	6+75.75	XX	3	45'	3	15'	MA	M-2(3)	1	W-OT	3	RT
F	7+72.31	XX	4	40'	4	15'	MA	M-2(2)	2	W-3T	4	RT
G	7+85.63	XX	1	34'	1	15'	MA	M-2(2), M-3	3	W-3T	1	RT
D	7+03.63	XX	2	20'	2	15'	MA	M-2(2), M-3	4	W-OT	1	RT

EXISTING POLE SCHEDULE												
NO.	STATION	TYPE	SIGNALS (VEH)			SIGNALS (PED)			PED. PUSH BUTTON			
			QUAD.	ARM	LENGTH	QUAD.	ARM	LENGTH	QUAD.	ARM	LENGTH	
A		XX	3	45'	3	15'	MA	M-2(1), M-3(2)	1	W-OT	4	RT
B		XX	4	20'	4	15'	MA	M-2(2)	2	W-3T	4	RT
C		XX	1	25'	1	15'	MA	M-2(2)	3	W-3T	1	RT
D		I-A					MA	M-2(2)	2	W-OT	1	RT


- LEGEND
- ① MULTIPLE LOOP CONNECTOR (STD. DWG. NO. 404-620)
 - ② INDUCTION LOOP (STD. DWG. NO. 404-620)
 - ③ TYPE "M" CONTROL CABINET (STD. DWG. NO. 404-304)
 - ④ PADMOUNT
 - ⑤ INSTALL R10-12
 - ⑥-⑧ PULLBOX (STD. DWG. NO. 404-120)
 - ⑨ INSTALL R3-5
 - ⑩ INSTALL R3-7
 - ⑪ SIGNAL POLE

- CONSTRUCTION NOTES
1. EXISTING SYSTEM IS TO REMAIN OPERABLE DURING INSTALLATION OF SIGNAL MODIFICATION.
 2. ALL PROPOSED P.U.I. ROADS TO BE (R) PULL BOX (STD. DWG. #404-120).
 3. ABANDON EXISTING CONDUIT RUN #2, #4, AFTER INSTALLATION OF MODIFIED SIGNAL IS COMPLETE, REPLACE EXISTING RUN #3 WITH PROPOSED RUN #2.
 4. REMOVE POLES B AND A AND PULL BOXES 6,7,11 AFTER INSTALLATION OF PROPOSED SYSTEM IS COMPLETE.
 5. ALL SIGNAL FOUNDATION TO BE "M" TYPE (STD. DWG. #404-209).
 6. REPLACE POLE D FROM TYPE I-A TO TYPE XX.
 7. OPTICON DETECTORS TO BE PLACED ON PHASE B AND PHASE 4.
 8. REMOVE AND REPLACE WEST ARM AND RELOCATE SIGNAL HEADS FOR POLE C AS INDICATED.
 9. ALL SIGNAL CONTROL SOFTWARE SHALL BE PER CITY OF LAS VEGAS SPECIFICATIONS.
 10. REPLACE EXISTING CONDUIT RUNS #12 AND #13 WITH PROPOSED RUN #21.
 11. REPLACE EXISTING CONDUIT RUN #10 WITH PROPOSED RUN #22.
 12. REMOVE AND REPLACE EAST LEG LEFT TURN LANE DETECTOR LOOPS (STD. DWG. NO. 404-622).
 13. REPLACE EXISTING CONTROL CABINET WITH TYPE "M" CONTROL CABINET (STD. DWG. NO. 404-304).
 14. EACH EXTENSION LOOP SHALL HAVE A HOMERUN TO THE CONTROLLER.


EXISTING SIGN SCHEDULE	
POLE	INTERNALLY ILLUMINATED STREET NAME SIGN (DOUBLE FACED)
A	CASHMAN FIELD
B	WASHINGTON AVENUE
C	CASHMAN FIELD
D	N.A.

PROPOSED SIGN AND BLOCK NUMBER SCHEDULE		
POLE	INTERNALLY ILLUMINATED STREET NAME SIGN (DOUBLE FACED)	BLOCK #
E	STATE OFFICE BUILDING	NA
F	WASHINGTON	E 1200
C	CASHMAN FIELD	NA
D	WASHINGTON	E 1200

NOTE: PER DRAWING 404-420 & 404-417, LETTERS SHALL BE UPPER CASE, SERIES E. SIGN SHALL BE DIAMOND GRADE TRANSLUCENT REFLECTIVE SHEETING, SHALL BE DOUBLE FACED.

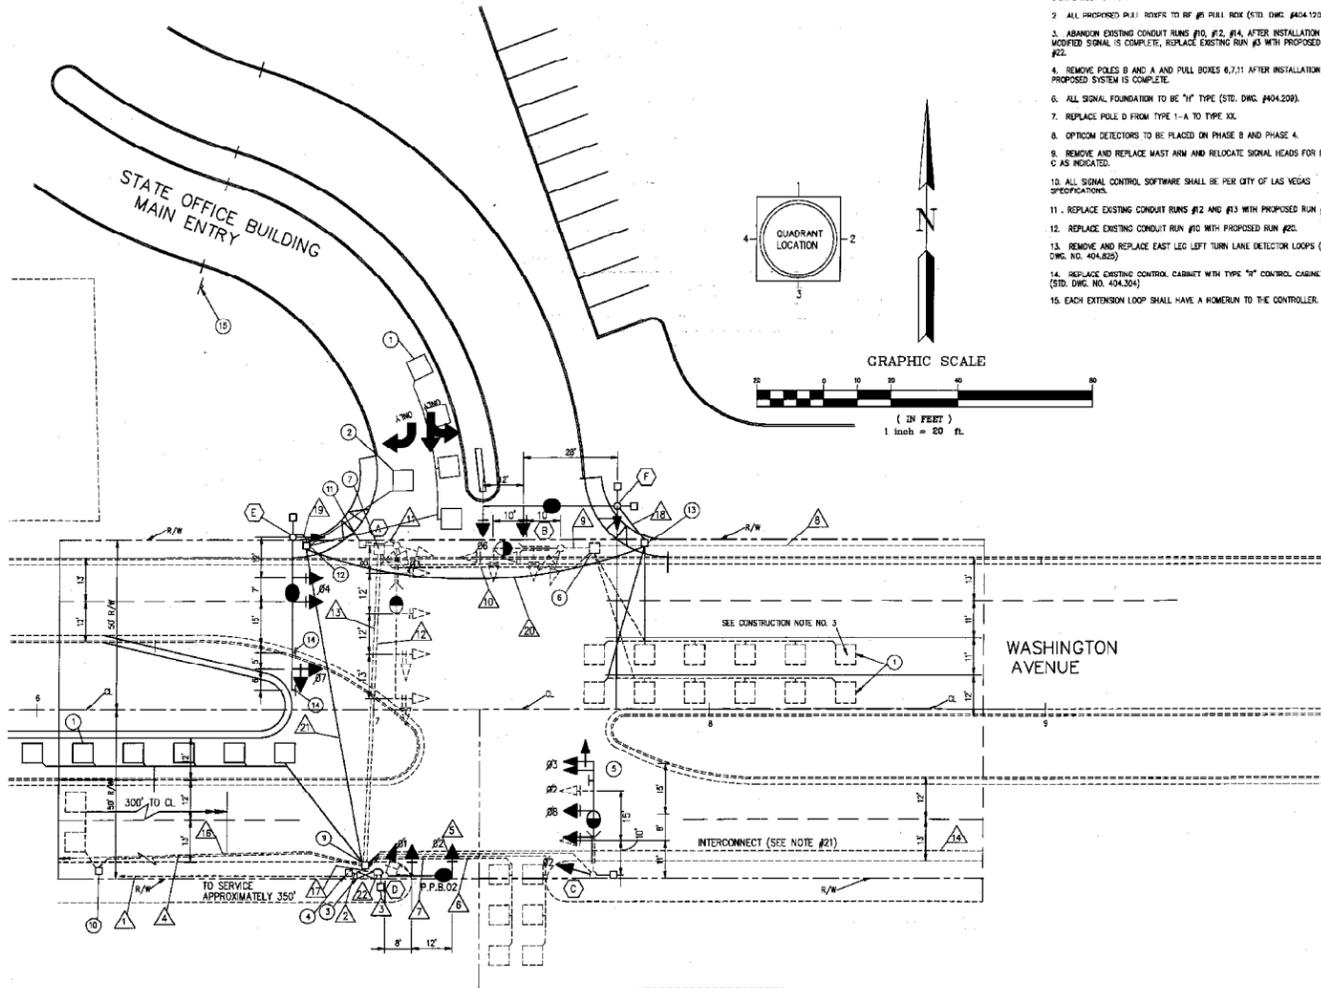

NOTE: FOR INTERSECTION CROSSWALKS SEE SHEET C3.01

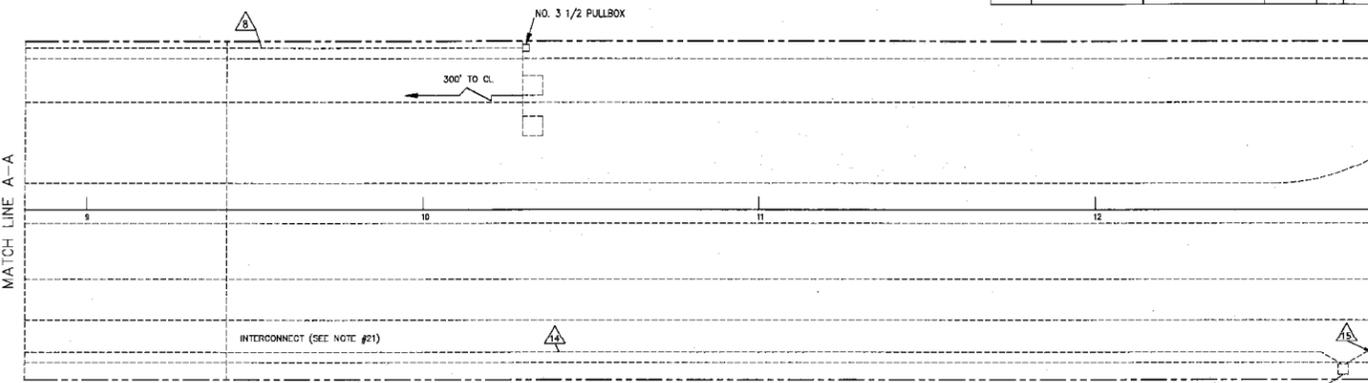

NOTE: THIS SHEET IS INCLUDED FOR INFORMATION ONLY

1. IT IS THE RESPONSIBILITY OF THE CONTRACTOR TO LOCATE ALL SUBSTRUCTURES, WHETHER SHOWN OR NOT, AND NOTIFY ALL UTILITY COMPANIES TO VERIFY IN THE FIELD THE LOCATIONS OF THEIR INSTALLATIONS 48 HOURS PRIOR TO CONSTRUCTION. THE CONTRACTOR SHALL PROTECT ALL SUBSTRUCTURES FROM DAMAGE. THE EXPENSE OF REPAIR OR REPLACEMENT OF SAID STRUCTURES SHALL BE BORNE BY THE CONTRACTOR.
2. ALL PULLBOXES, FOUNDATIONS, CABINETS, POLES AND POSTS, DRILLING STANDS AND DETECTOR SIGNAL UNITS AND HARDWARE EQUIPMENT, ORIENTATIONS, AND OTHER MISCELLANEOUS EQUIPMENT AND ITEMS OF WORK SHALL CONFORM TO THE R.T.C. TRAFFIC SIGNAL STANDARD DRAWINGS, LATEST REVISION.
3. ALL SIGNAL AND LUMINAIRE POLES SHALL BE TYPE XX.
4. SERVICE SHALL HAVE 1-50 AMP SINGLE POLE BREAKER FOR SIGNAL AND 2-40 AMP SINGLE POLE BREAKERS FOR STREET LIGHTS. SERVICE SHALL BE A 125 AMP PADMOUNT.
5. ALL LUMINAIRES SHALL BE 400 WATT HIGH PRESSURE SODIUM (HPS) (GE/MADA) WITH MC-111 DISTRIBUTION. EACH LUMINAIRE SHALL HAVE AN INDIVIDUAL 1000 WATT P.F. CONTROL AND BUILT IN BALLAST (120 VAC). EACH STREET LIGHT LUMINAIRE SHALL BE HOUSING IN THE CABINET USING INLINE FUSE HOLDERS. THE NORTHEAST AND SOUTHWEST LUMINAIRES SHALL BE WIRED TO ONE 40 AMP SINGLE POLE BREAKER, AND THE SOUTHWEST AND NORTHWEST LUMINAIRES SHALL BE WIRED TO THE SECOND 40 AMP SINGLE POLE BREAKER.
6. CONTROLLER AND CABINET SHALL BE AS SPECIFIED ON THE TRAFFIC SIGNAL PLAN. CABINET SHALL BE PAINTED WHITE INSIDE AND OUT.
7. THOSE POLES, AS SPECIFIED ON THE TRAFFIC SIGNAL PLANS, SHALL HAVE INTERNALLY ILLUMINATED STREET NAME SIGNS INSTALLED. THE SIGNS SHALL BE WIRED TO THE LUMINAIRE PHOTO CELL FOR CONTROL.
8. ALL SIGNAL LENSES SHALL BE 12" GLASS.
9. EACH LOOP DETECTOR LEAD-IN REPRESENTS A SEPARATE AMPLIFIER UNIT REQUIRED. SEE INDIVIDUAL SIGNAL PLANS FOR NUMBER REQUIRED. EACH LOOP SHALL BE 6" DET. DETECTOR LOOPS SHALL BE PLACED IN THE CENTER OF THEIR APPROPRIATE LANES.
10. THE ROUTING AND TERMINATION OF CONDUITS, DETECTOR LOOPS AND PLACING OF POLES AND CABINETS SHALL BE AS INDICATED ON THE PLANS. ALL CHANGES SHALL BE APPROVED BY THE TRAFFIC ENGINEER.
11. ALL NECESSARY AMPLIFIER UNITS, MODULES, LIGHT CONTROL UNITS, SWITCHES, FLASHERS, SIGNAL EQUIPMENT, ETC. SHALL BE WIRED IN THE CABINET TO ACTUATE THE PHASING OPERATION AS SHOWN ON THE INDIVIDUAL SIGNAL PLANS.
12. ALL CONDUCTORS AND THEIR TERMINATIONS SHALL BE CLEARLY MARKED.
13. UNLESS SHOWN OTHERWISE, NO. 5 PULLBOXES SHALL BE USED AT LOCATIONS WHERE CONDUIT RUNS CONTAIN TRAFFIC SIGNAL CONDUCTORS. NO. 3-1/2 PULLBOXES MAY BE USED AT OTHER LOCATIONS.
14. ALL EXISTING LIGHT POLES AS SHOWN ON PLANS, SHALL BE REMOVED AND ALONG WITH ANY MATERIALS SALVAGED FROM EXISTING LIGHTING SYSTEMS SHALL BE PROTECTED AND DELIVERED TO ELECTRICAL SERVICES AT MILWAUKEE AND DENVER DURING HOURS 7AM-2PM. EXISTING LIGHTING CIRCUIT SHALL REMAIN INTACT. (CALL AHEAD (702) 228-6446).
15. CHECK CONDUIT AND CABLE SCHEDULE FOR CONDUIT, CABLE AND WIRE SIZE.
16. LINE SIDE OF METER TO BE WIRED WITH THREE (3) A.W.G. LOAD SIDE SHALL BE WIRED WITH FOUR (4) A.W.G. (3 BLACK, 1 WHITE) AND ONE (1) A.W.G. (GREEN).
17. SIGNAL CABLE SHALL BE A 14 AND 28 CONDUCTOR #14 A.W.G. CABLE (M.S.A. SPEC. 20-1).
18. LOOP CABLE SHALL BE ONE TWISTED PAIR OF #12 A.W.G. CABLE (M.S.A. SPEC 19-2).

19. LOOP DETECTORS TO BE LOCATED BY C.L.V. IN THE FIELD.
20. LOOP LEAD-IN SHALL ONLY BE SPLICED IN PULL BOX ADJACENT TO ROADWAY LOOP.
21. ALL PEDESTRIAN PUSH BUTTON SIGNS SHALL BE 6"X12" WITH FULL MOUNTING BRACKET.
22. NEW INTERCONNECT SHALL BE 2" CONDUIT WITH NUMBER 5 PULL BOXES SPACED APPROXIMATELY 500' APART. CABLE SHALL BE 12 PAIR OF #22 A.W.G. SHIELD BSA SPECIFICATION P.E. 35.
23. POWER FOR SIGNAL CONTROLLER AND SIGNAL LAMP OPERATION IS PRESENTLY AVAILABLE AT THE SIGNAL LOCATION. THE CONTRACTOR SHALL CONTACT THE NEVADA POWER COMPANY FOR THE EXACT LOCATION. IT SHALL BE THE CONTRACTOR'S RESPONSIBILITY TO PROVIDE ADEQUATE POWER IN COOPERATION WITH THE NEVADA POWER COMPANY.
24. TRAFFIC SIGNAL AND CABLE WIRING SHALL BE INSTALLED TERMINAL TO TERMINAL. NO SPlicing ALLOWED. INTERCONNECT CABLE SHALL BE INSTALLED CABINET TO CABINET. ABOVE GROUND SPlicing WILL BE ALLOWED IN SPlice CABINETS. (EISCO 220000R TYPE 98, TERMINAL BLOCK FOR 22 AVERAGE GAUGE WIRE - 25 PAIR, OR EQUIVALENT).
25. ALL POLES AND CONTROLLERS MUST BE PLACED TO ALLOW A CLEAR PASSAGE OF AT LEAST 26" ON THE SIDEWALK.

PROPOSED CONDUIT AND CABLE SCHEDULE										
RUN NO.	FROM	TO	CONDUIT SIZE	SIGNAL CABLE		DET. LEADS		SERVICING OR INTERCONNECT		SERVICE
				14 AWG	12 AWG	LOOPS	LINE	TRASH	2 PAIR #2	
18	POLE "F"	PULLBOX	1-3"	X				X		
19	POLE "E"	PULLBOX	1-3"	X				X		
20	PULLBOX	PULLBOX	1-3"	X				XXXX	X	
21	PULLBOX	PULLBOX	2-3"	XX				XXXX	XX	
22	POLE "G"	CONTROLLER	1-3"	X				X		
17	PULLBOX	CONTROLLER	1-3", 3-2"	XXX				XXXX	XXX	X

EXISTING CONDUIT AND CABLE SCHEDULE										
RUN NO.	FROM	TO	CONDUIT SIZE	SIGNAL CABLE		DET. LEADS		SERVICING OR INTERCONNECT		SERVICE
				14 AWG	12 AWG	LOOPS	LINE	TRASH	2 PAIR #2	
1	SERVICE	PADMOUNT	2"							X
2	PADMOUNT	CONTROLLER	2"							X
3	CONTROLLER	POLE "D"	2"	X						
4	PULLBOX	PULLBOX	1"					X		
5	PULLBOX	POLE "C"	2"	X				X		
6	DETECTOR LOOPS	PULLBOX	1"					X		
7	DETECTOR LOOPS	PULLBOX	1"					X		
8	PULLBOX	PULLBOX	1"					X		
9	POLE "B"	PULLBOX	2"	X				X		
10	PULLBOX	PULLBOX	2"	X				XXX	X	
11	POLE "A"	PULLBOX	2"	X				X		
12	PULLBOX	PULLBOX	2"	X				X		
13	PULLBOX	PULLBOX	2"	X				XXX	X	
14	PULLBOX	PULLBOX	3"							X
15	PULLBOX	PULLBOX	3"	SAME AS RUN				#17	DRW 208-356 SHT.	
16	PULLBOX	PULLBOX	3"					XXX	XXX	X
17	PULLBOX	CONTROLLER	1-3", 3-2"	XXX				XXXX	XXX	XX




2770 SOUTH MARYLAND PARKWAY SUITE 510 LAS VEGAS, NEVADA 89109 (702) 733-7107



DEPARTMENT OF GENERAL SERVICES SPWB JOB # 91-C9



MARTIN & MARTIN CIVIL ENGINEERS 1701 W. CHARLESTON BLVD. SUITE 400 LAS VEGAS, NEVADA 89102 PHONE (702) 398-5000

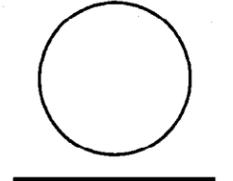

Check and verify all dimensions and report all errors to the architect prior to commencing work. These drawings are not to be scaled. All drawings, specifications and copies thereof furnished by the architect are to be used only with respect to the Project and are not to be used on any other Project without the express written consent of the architect. Such consent shall be in writing and shall be subject to the architect's approval of the proposed use. The architect's approval does not constitute a warranty of any kind, and the architect shall not be held responsible for any errors or omissions in these drawings or specifications or for any consequences arising from their use. The architect's liability is limited to the amount of the fee for the project. The architect's liability shall not be construed as a warranty of any kind, and the architect shall not be held responsible for any errors or omissions in these drawings or specifications or for any consequences arising from their use. Copyright Lucchesi Galati Architects, Inc. 1996

Date: FEBRUARY 23, 1993
Project No.: 1096
Scale: 1"=20'
Drawn By: R. YOUNG
Revisions:

2-23-95
RECORD DRAWINGS

Sheet Title:

SIGNAL MODIFICATION PLAN (BY OTHERS) N.I.C.

Sheet Number:

C7.01



LUCCHESI GALATI ARCHITECTS
2770 SOUTH MARYLAND PARKWAY
SUITE 510
LAS VEGAS, NEVADA 89109
(702) 733-7107




STATE OFFICE BUILDING

DEPARTMENT OF GENERAL SERVICES

SPWB JOB # 91-C9

MARTIN & MARTIN MARKING & MARTIN CIVIL ENGINEERS
1701 W. CHARLESTON BLVD. SUITE 402
LAS VEGAS, NEVADA 89102
PHONE (702) 288-8005

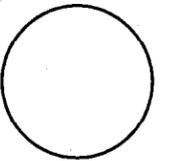

Check and verify all dimensions and report all errors to the Architect prior to commencing work. These drawings are not to be used for any other project without the written consent of the Architect. No part of these drawings shall be reproduced or transmitted in any form or by any means, electronic, mechanical, photocopying, recording, or by any information storage and retrieval system, without the prior written permission of the Architect. Copyright © 1992 Lucchesi Galati Architects, Inc. A Nevada Corporation. Copyright Lucchesi Galati Architects, Inc. 1992

Date: FEBRUARY 2-23-93
Project No: 1098
Scale:
Drawn By: R. YOUNG
Revisions:


2-23-95
RECORD DRAWINGS

Sheet Title:


SECTION AND DETAILS

Sheet Number:


C8.01

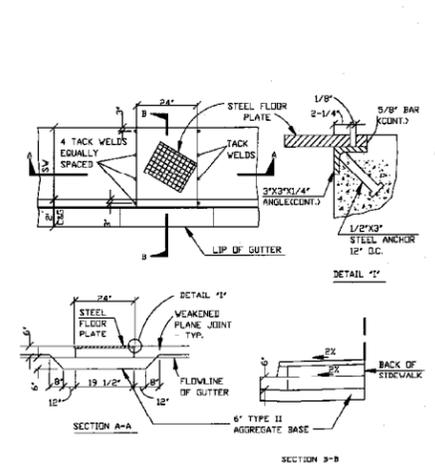


SIDEWALK DRAIN DETAIL
STD. DWG. NO. 236
CB.01

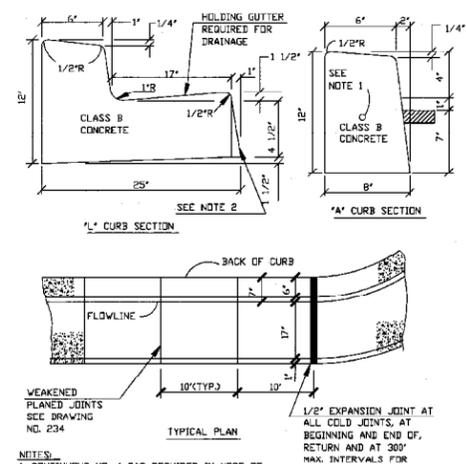


'L' & 'A' CURB DETAILS
STD. DWG. 216
CB.01

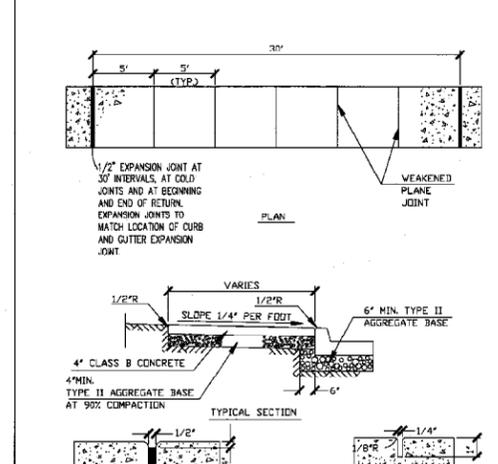


SIDEWALK
STD. DWG. NO. 234
CB.01

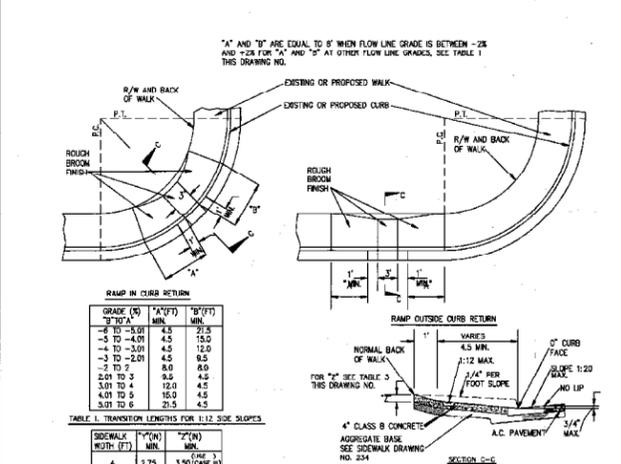


SIDEWALK RAMP - CASE I
STD. DWG. NO. 235
CB.01

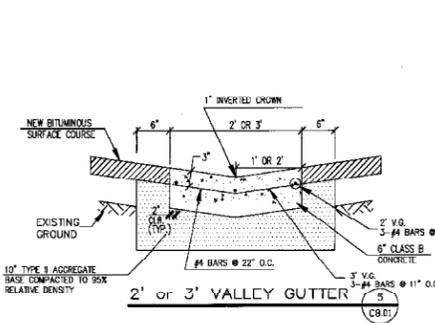


2' or 3' VALLEY GUTTER
CB.01

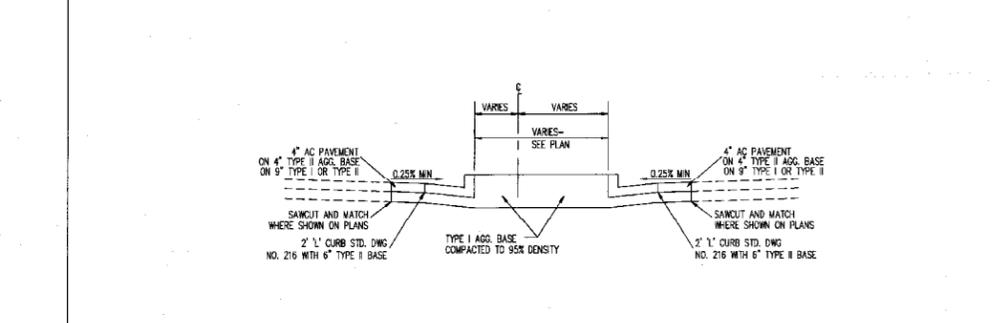


WASHINGTON AVENUE SECTION AT MEDIAN
CB.01

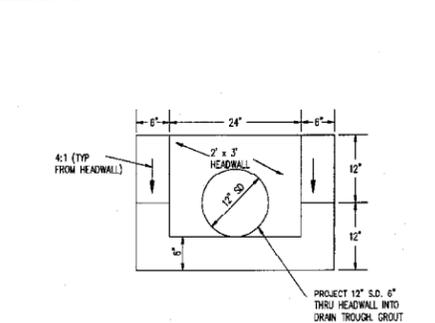


2' DRAIN TROUGH AND 2' BY 3' HEADWALL DETAIL
CB.01

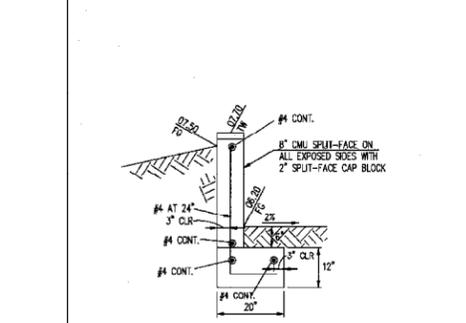


LANDSCAPE WALL DETAIL - N.T.S.
CB.01

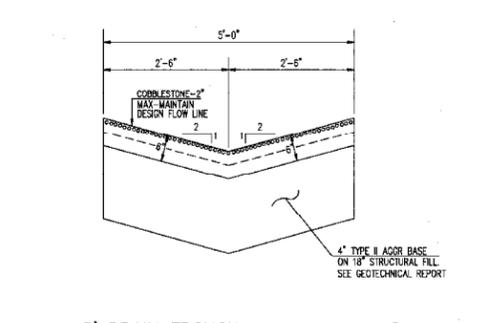

5' DRAIN TROUGH
SEE LANDSCAPE DRAWINGS FOR ADDITIONAL COBBLESTONE TREATMENT.
CB.01

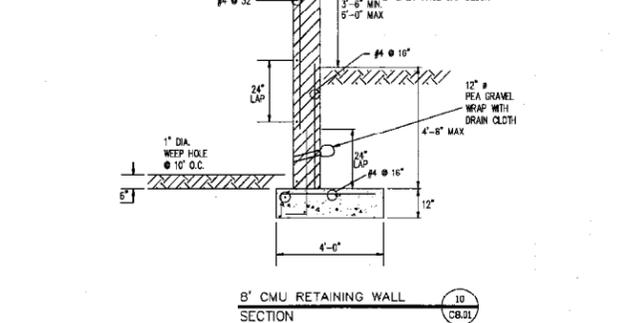

8' CMU RETAINING WALL SECTION
CB.01

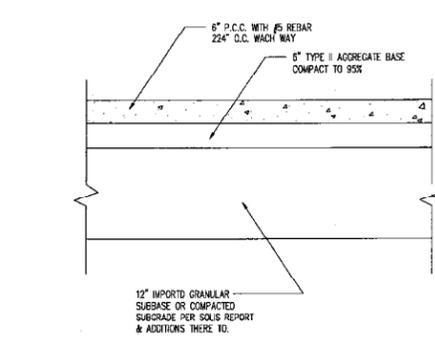

CONC. PAVEMENT SECTION
CB.01

1. MATERIALS AND INSTALLATION OF ITEMS DETAILED ON THIS SHEET SHALL COMPLY WITH "UNIFORM STANDARD SPECIFICATIONS FOR PUBLIC WORKS CONSTRUCTION OFF-SITE IMPROVEMENTS CLARK COUNTY, NEVADA" AND THE DESIGN LEVEL GEOTECHNICAL REPORT BY CONVERSE CONSULTANTS' SOUTHWEST, INC., DATED MAY 25, 1992 AND ALL ADDENDA AND CORRESPONDENCE RELATED THERETO.

PHOTOGRAPHS



FIRE HYDRANT AND A CONCRETE THROUGH DRAINAGE LOCATED AT THE NORTHEAST PORTION OF THE SITE



SIDEWALK AND PARKING AREA AT THE NORTHEAST PORTION OF THE SITE




LOOKING WEST FROM THE NORTHEAST PORTION OF THE SITE



STORM SEWER PUMP STATION EAST OF THE TRUCK DOCK



SECURED PARKING AREA TO THE NORTH

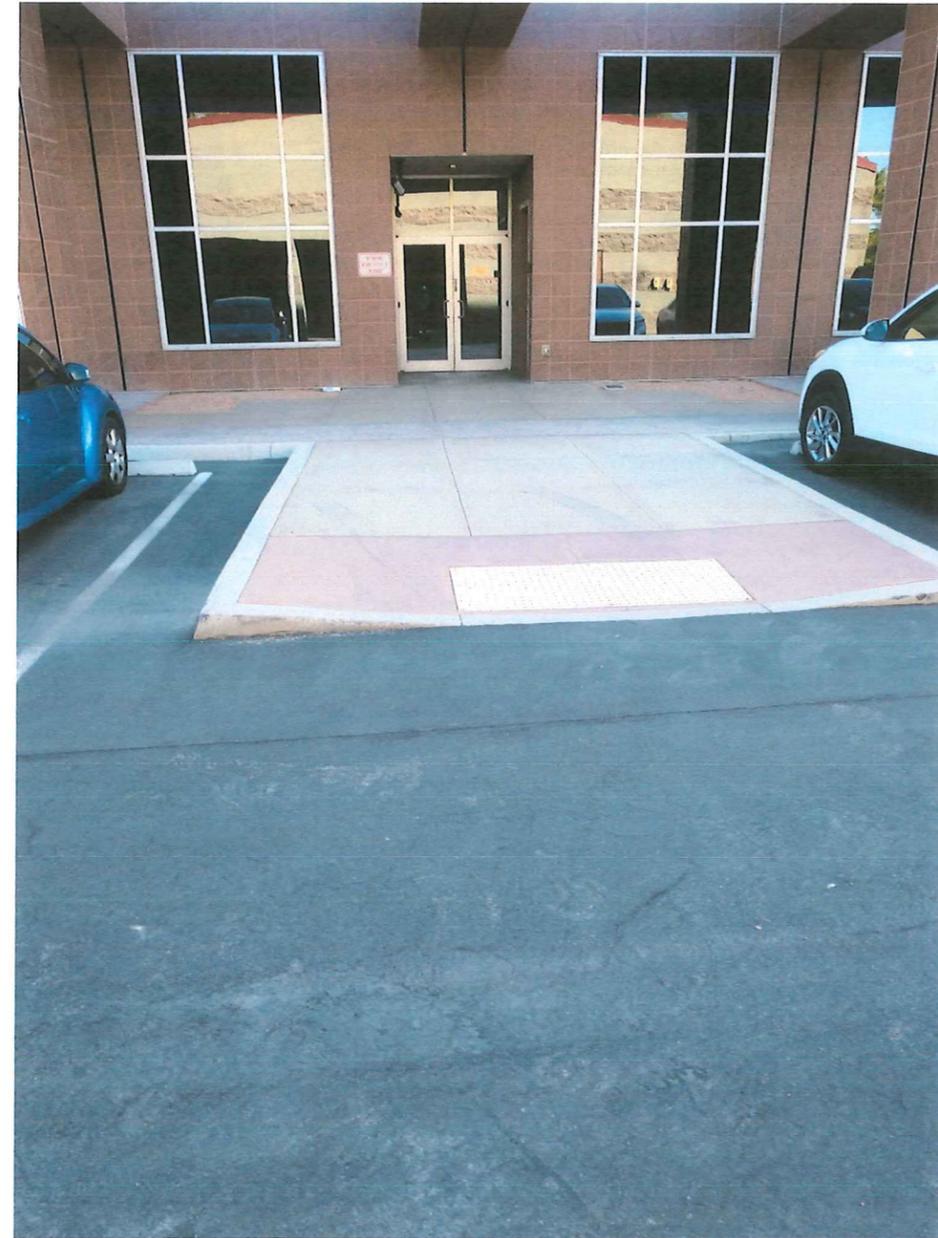

SIDEWALK LEADING TO DOOR LOCATED AT NORTH OF THE BUILDING




ROOF DRAIN EAST OF THE NORTH ENTRANCE



TRUCK DOCK AND TRASH AREA LOCATED NORTH OF THE SITE




A RAISED DOCK AND A DOCK TRENCH DRAIN LOCATED NORTH OF THE SITE

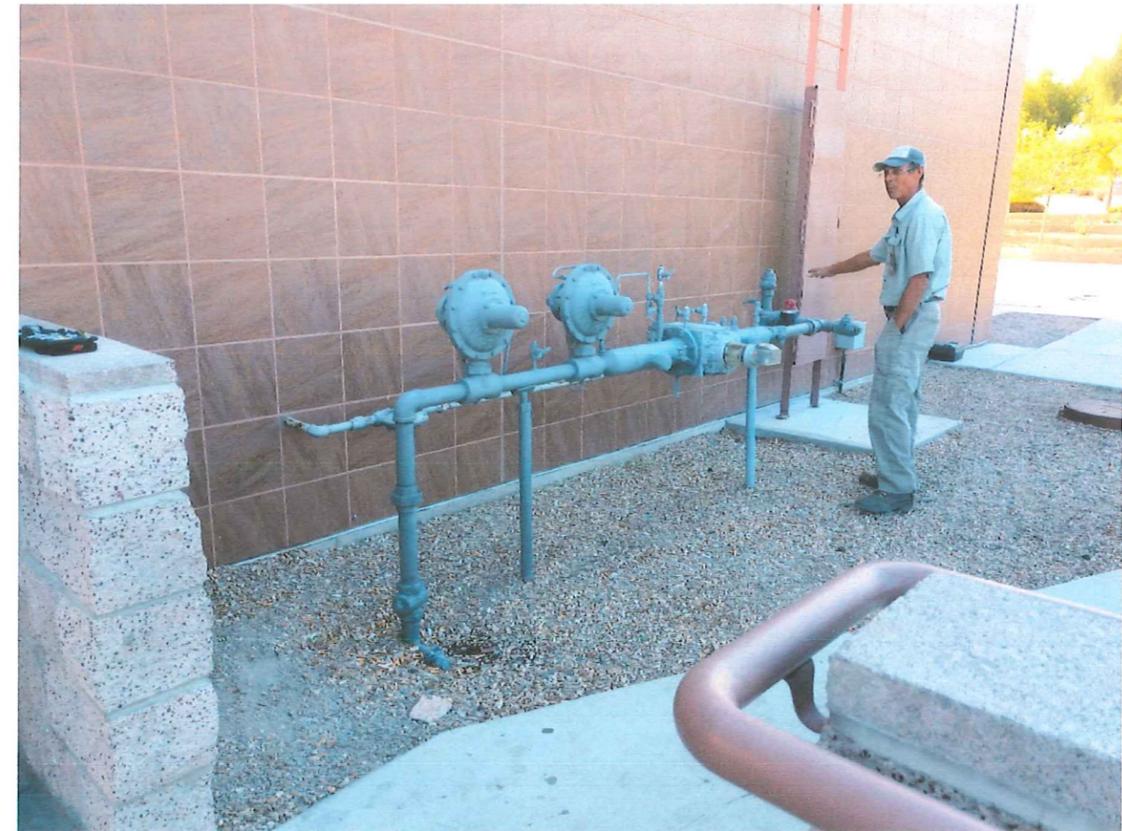

GAS METER AT THE NORTHWEST BUILDING CORNER, NOT THE ACCESS LADDER.



GREASE INTERCEPTOR NEAR THE NORTHWEST BUILDING CORNER

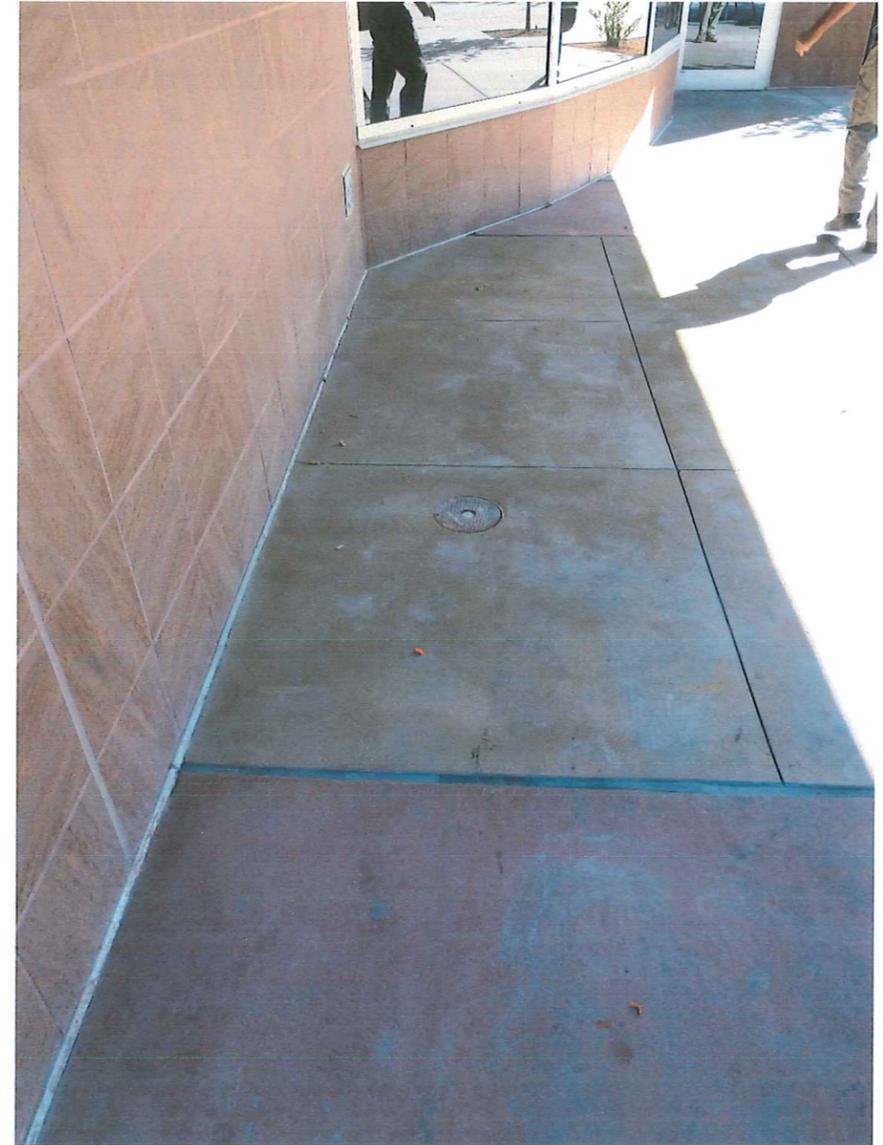

SEWER CLEANOUT SOUTH OF THE NORTHWEST BUILDING CORNER



WEST PLAZA AREA DRAINS NORTH



WEST PLAZA AREA DRAINS TO THE MIDDLE



WEST PLAZA LOOKING SOUTHEAST



WEST PLAZA AREA DRAINS SOUTH



WEST PLAZA LOOKING NORTH



SOUTHWEST COVERED WALK



WEST SIDE VETERAN'S MEMORIAL LOOKING SOUTH



POSSIBLE SEWER CLEANOUT UNDER PAVERS

MIDDLE OF VETERAN'S MEMORIAL LOOKING SOUTH



EASTERLY VIEW OF SOUTH PLAZA



SIDEWALK CRACK NEAR THE SOUTHWEST CORNER OF THE BUILDING



FIRE HYDRANT MAY BE INACCESSIBLE – LOCATED AT THE EAST PORTION OF THE SITE, AT THE VETERAN'S MEMORIAL AREA



NEAR THE SOUTHWEST BUILDING CORNER LOOKING WEST




WEST VIEW OF THE COVERED WALK LOCATED AT THE SOUTHEAST



EAST VIEW OF THE COVERED WALK LOCATED AT THE SOUTHEAST. NOTE THE SEWER CLEANOUT



WEST VIEW OF THE DRY WASH AREA LOCATED AT THE
SOUTHEAST BUILDING CORNER.

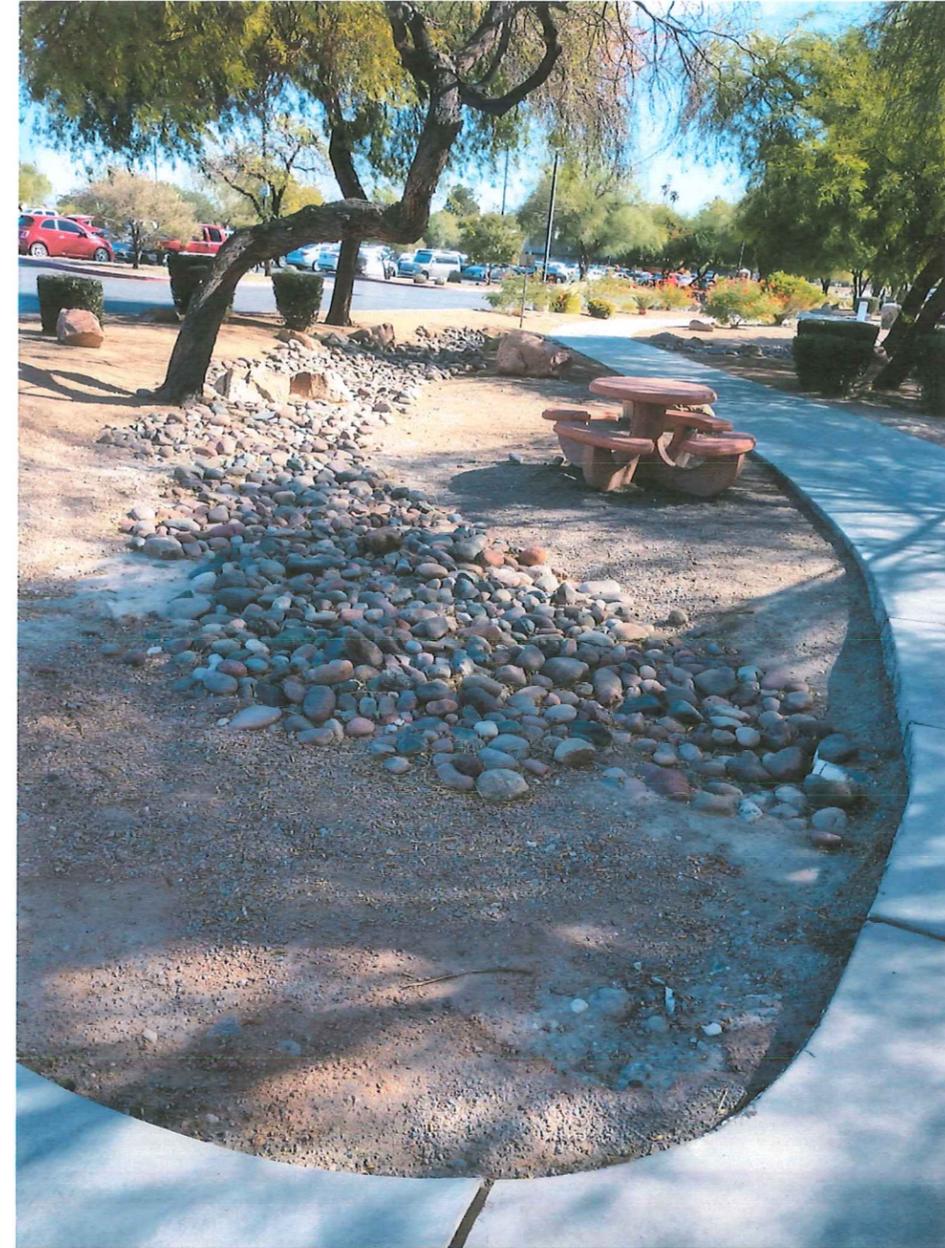

SOUTHEAST VIEW OF THE DRY WASH AREA LOCATED AT
THE SOUTHEAST BUILDING CORNER.



PONDING ON THE VALLEY GUTTER AT THE SOUTHEAST.
NOTE THE FILL OVER PIPE



VALLEY GUTTER AT THE SOUTHEAST, EXITING THE
PARKING LOT



SOUTHEAST CONTROLLED ENTRANCE DRIVEWAY LOOKING SOUTH



EAST PARKING LOT. SOME CRACKING BUT NOT APPARENT FAILURE



EAST PARKING LOT. SOME CRACKS AND SLOW DRAINING AREAS



8-INCH S.E. PIPE EXITING TO INLET AT BACK OF WASHINGTON AVENUE DROP INLET

Structural Engineering Assessment



Revised January 2, 2018
November 1, 2018



Scott A. Carter, Architect
KGA Architecture
9075 West Diablo Drive, Suite 300
Las Vegas, NV 89148

John A. Martin, Jr., S.E.

Steve Schiller, S.E.
Gregory L. Clapp, S.E.

Subject: Grant Sawyer State Office Building
Feasibility Studies and Programming
Structural Narrative
JAMA NV Job No. 7814

Tammy Carter, P.E.
Gordon Kuang, P.E.
Pete Padilla, P.E.

Dear Scott:

The following includes an assessment of the existing facility based on review of the existing structural drawings, calculations and site visit on October 15, 2018:

- The building appears to be in good condition structurally.
 - No settlement was observed; and
 - No cracks in exterior walls.
- The building was constructed per the 1991 UBC. Based upon the 2018 IBC, the current seismic factor would be 1.9 x higher than the original design code.
 - Future expansions would require separation joints between old and new expansions;
- Elevator addition and/or modification.
 - Changing the lateral system in any form may require upgrading all braces, columns, footings and drag/chord systems. Therefore, removing or changing the lateral system is not recommended
 - The current elevator pit is 5' deep. If new elevators can fit into the existing opening and with the current clearances, replacement should not be complicated;
 - The framing around the existing openings cannot be easily modified. There are adjacent mechanical openings next to the elevator openings.
 - If a portion of the atrium is filled in for a new elevator, the existing floor beams, columns and foundations may need to be reinforced.
- The existing roof was designed for a live load of 20 psf (reducible), not adequate for occupant loading.

Should you have any questions do not hesitate to contact this office.

Sincerely,

John A. Martin & Associates of Nevada

Greg Clapp, S.E.
Principal

Mechanical, Plumbing and Electrical Engineering Assessment



**GRANT SAWYER OFFICE BUILDING
555 E. WASHINGTON AVE., LAS VEGAS
INITIAL FINDINGS REPORT**

NV5 PROJECT NO. 018.0745.00

Prepared for:

KGA Architecture
9075 Diablo Dr.
Las Vegas, NV 89148

Prepared by:

NV5
5155 W. Patrick Lane
Las Vegas, NV 89118

Issue Date:

January 2, 2019

Revision No.	Issue Date	Prepared By	Reviewed By	Remarks
0	11/05/2018	Alex Jankovic Rob Jones Gary McClure Bill Sittman	KGA	Draft
1	1/02/2019	Alex Jankovic JJ Wisdom	KGA	Final

TABLE OF CONTENTS

EXECUTIVE SUMMARY

1. MECHANICAL SYSTEMS & DUCTWORK
2. SERVER/DATA ROOMS COOLING
3. HYDRONIC PIPING-EXTERIORS
4. HYDRONIC PIPING – INTERIORS
5. HYDRONIC PIPING-THROUGH THE WALL PENETRATIONS
6. HYDRONIC PIPING – WALL THICKNESS MEASUREMENTS
7. PLUMBING SYSTEMS – WASTE & VENT EXTERIORS
8. PLUMBING SYSTEMS – WASTE & VENT INTERIORS
9. PLUMBING SYSTEMS – ROOF/STORM DRAINS
10. PLUMBING SYSTEMS – DOMESTIC BOOSTER PUMPS
11. PLUMBING SYSTEMS -DOMESTIC HOT WATER DISTRIBUTION
12. FIRE PUMP ROOM
13. LIFE SAFETY – SMOKE REMOVAL SYSTEMS
14. ELECTRICAL SYSTEMS
15. FIRE ALARM SYSTEM

EXECUTIVE SUMMARY

NV5 Consulting Engineers and Bombard Mechanical Contractors have performed the field investigation at the Grant Sawyer Office Building to verify the existing conditions of mechanical HVAC systems, Plumbing systems and Electrical systems.

This report is a summary of initial investigations during our field visits on the following dates:

- October 11, 2018
- October 12, 2018
- October 13, 2018
- October 15, 2018
- October 17, 2018
- October 23, 2018
- December 6, 2018

When pursuing this investigation, we had in mind the three RRR =Repair, Remodel, Replace and the 20 years fix of the MEP systems as our final goal.

Based on our initial findings we are making the assessments towards the following conclusions:

- | | |
|---|--|
| 1. Mechanical Systems and Ductwork | * All exposed & lined ductwork to be removed & replaced. |
| 2. Server, Data Rooms Cooling | * Complete replacement |
| 3. Hydronic Piping Exteriors | * All hydronic piping to be removed & replaced |
| 4. Hydronic Piping Interiors | * All hydronic piping to be removed & replaced |
| 5. Hydronic Piping - Wall Penetrations | * To be verified and replaced |
| 6. CHS/CHR Piping Wall Thickness | * All hydronic piping to be removed & replaced. |
| 7. Plumbing Systems -Waste & Vent Exteriors | * To be replaced or epoxy lined (CIPP) |
| 8. Plumbing Systems-Waste & Vent Interiors | * 100% replacement of underground with PVC |
| 9. Plumbing Systems-Roof, Storm Drainage | * Not compromised, all clogged sections to be cleaned. |
| 10. Plumbing Systems-Domestic Booster Pumps | * To be replaced |
| 11. Plumbing Systems-CW, HW Distribution | * No action required |
| 12. Fire Protection -Fire Pump Room | * To be replaced with electric-drive fire pumps |
| 13. Life Safety – Smoke Removal Systems | * To be replaced in compliance with 2018 IBC |
| 14. Electrical Systems | * Good conditions |

As a look ahead in our next phase of this task we will make the final assessments and recommendations for the repair, remodel or replacements of MEP systems, based on the ASHRAE Life Expectancy Chart for HVAC equipment and components.

1. MECHANICAL SYSTEMS & DUCTWORK

- Verify the integrity of medium pressure ductwork for all systems.
- Verify the status of exterior ductwork on roof. Suggest the mitigation.
- There are 8 Air Handling Systems.
Based on the TAB results, dated July 2011 the capacities are as follows:

AH-1	23,700 CFM @ 3.0" ESP (7.0" TSP)
AH-2	26,400 CFM @ 3.0" ESP (7.0" TSP)
AH-3	30,000 CFM @ 3.0" ESP (7.0" TSP)
AH-4	23,300 CFM @ 3.0" ESP (7.0" TSP)
AH-5	33,800 CFM @ 3.0" ESP (7.0" TSP)
AH-6	29,400 CFM @ 3.0" ESP (7.0" TSP)
AH-7	32,200 CFM @ 3.0" ESP (7.0" TSP)
AH-8	27,200 CFM @ 3.0" ESP (7.0" TSP)
- Verify all vertical shafts for SA, RA ductwork leaks etc.
- Verify main horizontal SA, RA duct routing on each floor and status.
- Verify the return air path and transfer openings on all floors.
- Possible Re-Zoning of HVAC systems
- AHU Replacement – scheduled improvements.
- Central Plant and DDC control system – recently renovated.
- Mechanical Updates: VAV terminal units – New Alerton Controls + hose kits & isolation valves.

Conclusion: All exposed and lined medium pressure ductwork to be replaced. Exterior ductwork on roof shows the signs of corrosion and may have been compromised during the initial operation with evaporative cooling sections. Per field investigation on Level 5, multiple segments of ductwork have friable fiberglass material in the airstream as part of the original acoustical treatment of ductwork. Level 5 ductwork shall be completely removed and replaced with new ductwork.

Interior medium pressure ductwork compromised with openings & flex duct connections for additional cooling of server rooms shall be repaired by disconnecting of flex ductwork and properly sealing the system.

2. SERVER/ DATA ROOMS COOLING

- Identify the compromised medium pressure ductwork with holes intended to cool the server, data, TR rooms.
- Identify all server/ TR rooms and current cooling problems.
- Verify the possible routing of the new CHS/CHR risers to serve the Data/TR rooms throughout the facility
- Future Cooling system with CHW fan-coil units + DX back-up split systems where mandated.
- DX units dumping the heat into plenum.

Conclusion: Server/Data rooms cooling system shall be completely disconnected from the medium pressure ductwork. A dedicated chilled water - cooling system will be provided for server/data rooms utilizing the cooling only fan-coil units with emergency DX cooling units as a back-up where required. The new chilled water risers will be installed from chiller room down to the first floor to serve these cooling only fan-coil units. The existing plate/frame heat exchanger will be upsized to be capable of providing the cooling for all fan-coil units during the water economizer mode of operation.

• Server, Data Rooms Cooling

1st Floor

Gaming Server Room (300 SF)	3 tons
EITS South Wing (100 SF)	1.5 tons
South-East (150F)	1.5 tons

2nd Floor

Gaming West Server (92 SF)	3.5 tons
Gamin Salon Viewing Room (122 SF)	2 tons

3rd Floor

AG Server Room (150 SF)	3.5 tons
-------------------------	----------

4th Floor

LCB Server Room (150SF)	2.5 tons
LCB AV/TR room	3.5 tons

5th Floor

Secretary of State Server Room (15 SF)	1 ton
Criminal Investigation Server (60 SF)	1 ton

6th Floor

EITS Servers (150 SF)	3 tons
-----------------------	--------

Total Cooling Capacity = 26 tons (312 MBH)

Proposed solution: Add a dedicate 3" CHS/CHR riser to serve the server/data rooms on all floors.

New cooling only fan-coil units will be selected with DX back-up cooling where required.

3. HYDRONIC PIPING – EXTERIORS

- Chilled Water piping – external corrosion due to gap w/insulation. Verify all mains on all floors and identify the sections of corroded piping.
- Verify the status of insulation throughout
- Heating hot water piping – failing gasketed joints. Identify the issues and original piping material and joints used.
- It was discovered that all 2” and smaller hot water piping was installed utilizing the galvanized piping. This has to be corrected throughout.

Conclusions: Chilled water hydronic piping shows considerable exterior corrosion at the multiple fittings, take-offs and elbows, due to incorrect insulation type and compromised vapor barrier or damaged service jacket. To mitigate this issue, complete chilled water piping system shall be replaced and 100% of the insulation shall be replaced with rigid polyisocyanurate insulation with correct vapor barrier and provision of dams at each pipe fitting to prevent any condensation. The heating hot water hydronic piping shall be completely removed and replaced with new piping per current standards.

4. HYDRONIC PIPING – INTERIORS

- Chilled water interior investigation to determine the status of the hydronic piping interior. It was determined that the interior of chilled water piping was not compromised.
- Insert the camera in the chilled water line through strainer at section near AH-8.

Conclusions:

Based on the findings of the condition of the piping exterior above Item 3, the whole hydronic piping system shall be replaced.

5. HYDRONIC PIPING – THROUGH THE WALL PENETRATIONS

- Investigation of the hydronic piping through-the-wall penetrations and applied insulation.

Conclusions: Based on our initial findings through-the-wall penetrations are compromised, indicating the missing insulation and presence of exterior corrosion.

6. HYDRONIC PIPING – WALL THICKNESS MEASUREMENTS

- Thorough investigation of hydronic piping wall thickness in various locations throughout the facility.

Conclusions: The ultrasonic wall thickness measurements of chilled water piping indicate that the wall thickness is not compromised.

7. PLUMBING SYSTEMS – WASTE & VENT EXTERIORS

- Cast Iron waste piping above ground - verify the status of risers.
- Grease Interceptor problems. Replace the Grease Interceptor.
- First floor waste line slopes and need to replace the whole underground waste lines.
- Site waste lines routing to future lift station? Sketch from SPWD.
- Civil engineer proposed to run the waste deeper at the building? Approx. 4 ft can be gained.
- Verify the invert elevations for exiting waste lines.

Conclusions: Complete above ground waste & vent piping to be replaced or epoxy lined utilizing the “NU Flow” non-pressurized epoxy linin (CIPP) – the cured in-place pipe restoration process.

8. PLUMBING SYSTEMS – WASTE & VENT INTERIORS

- Investigate the status of waste & vent interior, throughout the facility.
- Cast iron waste piping underground routing – camera scoping.
- Cast iron vent piping status. Identify the compromised vent lines.
- Kitchen area grease waste piping issues.

Conclusions: Complete underground cast iron piping to be removed and replaced with PVC properly sloped system with 2% slope.

9. PLUMBING SYSTEMS – ROOF, STORM DRAINS

- Investigate the status of existing roof /overflow drains. Investigate the status of storm water piping risers.
- Verify the status of storm water lift station at back of house in dock area.

Conclusions: Not compromised but needs to be further investigated for possible clogged sections of roof drains and overflow drains.

10. PLUMBING SYSTEMS – DOMESTIC BOOSTER PUMPS

- Investigate the status of domestic booster pumps.

Conclusion: The booster pump set shall be replaced, since at the end of its useful life per ASHRAE life expectancy table.

11. PLUMBING SYSTEMS – COLD & HOT WATER DISTRIBUTION

- There is no RPBP – reduced pressure backflow preventer at the property. There will be a need to install a new RPBP.
- Domestic cold water – street pressure.
- Kitchen area domestic hot water piping issues.

Conclusion: Not compromised - in good working condition.

12. FIRE PROTECTION – FIRE PUMP ROOM

- Investigate the status of fire pumps. This is a part of the separate study by NV5 Fire Protection department.

Conclusion: The fire pumps shall be replaced with electrically driven fire pumps per 2018 IBC.

13. LIFE SAFETY – SMOKE REMOVAL SYSTEMS

- Life Safety Systems modified from 1991 UBC to 2012 IBC.

Conclusion: Life Safety System shall be upgraded per 2018 IBC, UMC codes.

EQUIPMENT/MATERIALS LIFE EXPECTANCY

Critical Item	Description	HVAC Equipment			Age	ASHRAE Life Expectancy	Life Remaining
		Type	Recommendation	Location			
Air Handling Units	AH-1 to AH-8 236,000 cfm	VAV	To be replaced	Roof	23	30	+7
Hydronic Chilled Water Piping	Sch 40	Black steel	To be replaced.	Roof	23	30-50	7-27
Hydronic Heating Hot Water Piping	Sch 40	Black steel	To be replaced	Roof	23	30-50	7-27
		Galvanized steel		Indoor	23	30-50	7-27
MP Ductwork Interior ductwork	Exposed on roof Level 5	Sheetmetal with internal lining	Complete replacement	Roof	23	40+	17+
Waste & Vent Piping	Risers above ground	Cast Iron	Clogged vents	Indoor	23	50	27
Waste & Vent Piping	Horizontal below grade	Cast Iron	Complete replacement with PVC	Underground	23	--	--
Domestic CW, HW Piping		Copper	Good	Interior	23	40-50	17-27
Domestic Booster Pumps	Base mounted Duplex		To be replaced	Pump room	23	20	-3
Fire Pumps	Diesel pumps		To be replaced with electric-drive fire pumps	Fire pump room	23	25	2
Smoke Removal System			To be updated to 2018 IBC		23	25	+2

14. ELECTRICAL

Electrical distribution

Electrical distribution was reviewed against the as-built drawings furnished. Generally, the installation matches the as-built drawings with a few exceptions.

1. Minor branch circuiting updates noted in panelboard directories as circuits were added for receptacles, copiers, small rack mounted UPS units, etc.
2. The equipment name labels for unit-substations 'USW' and 'USR' are swapped. These labels should be corrected to match the as-built drawings.
3. The equipment rating and main device on unit-substation 'USE' was specified to be 1000A, but actual equipment installed is rated 1200A. We do not see any issue with this discrepancy.
4. We observed the nameplate ratings on four distribution boards that do not match the plans. We suspect during the original installation; these four boards were inadvertently mixed-up as they are all single section distribution board sections and look identical. The under-rated equipment should be addressed as soon as possible as they are not protected with the appropriate over-current device per NEC.
 - a. Distribution board 'EDP2' is connected to a 600A feeder and specified to be rated 600A. The actual equipment installed is rated 250A.
 - b. Distribution board 'EDP3' is connected to a 600A feeder and specified to be rated 600A. The actual equipment installed is rated 250A.
 - c. Distribution board 'EH3' is connected to a 100A feeder and specified to be rated 100A. The actual equipment installed is rated 600A.
 - d. Distribution board 'DPH1' is connected to a 200A feeder and specified to be rated 225A. The actual equipment installed is rated 600A.
5. When the central plant on Level 6 was upgraded, the third chiller was eliminated. This circuit breaker is currently locked out. We suggest confirming the conductors have been properly pulled back to a junction box and capped.
6. Review of the panelboard directories for emergency branch panels indicate loads have been added that are not compliant with code. Only those loads as identified in NEC 700 are permitted.

Electrical Capacity

There are (3) three unit-substations providing step-down of the medium voltage utility service to 277/480V, 3-phase, 4-wire for building distribution. The ratings of this equipment are as follows:

Unit-substation 'USW' (misabeled USR)	= 1,500 kVA 12.47kV-277/480V, 3-phase, 4-wire
Unit-substation 'USE'	= 750 kVA 12.47kV-277/480V, 3-phase, 4-wire
Unit-substation 'USR' (misabeled USW)	= 2,500 kVA 12.47kV-277/480V, 3-phase, 4-wire

We observed the following instantaneous loads on each unit-substation at the time of our site visit. We walked the building between 4pm to 8pm on October 15, 2018. These loads appear to be much less than the building NVE service capacity from a medium voltage service. We would like to request utility bills for a 12-month period.

Unit-substation 'USW' (misabeled USR)	= 168 kVA
Unit-substation 'USE'	= 91 kVA

Unit-substation 'USR' (misabeled USW) = 158 kVA

Due to the extremely low utilization of the unit-substation capacity, we observed the voltage readings to be slightly high, but less than 5% over-voltage.

Unit-substation 'USW' (misabeled USR) = 287/500 V
 Unit-substation 'USE' = 291/506 V
 Unit-substation 'USR' (misabeled USW) = 286/497 V

Condition

Distribution Equipment

Generally, the electrical distribution equipment is in good condition and appears original to the building. Switchboards, panelboards, transformers and other electrical distribution equipment do not have an expected lifespan. If the equipment is kept clean and regular testing/maintenance performed the equipment can generally last through the life of the building.

The bolted pressure switches (or Pringle Switches) utilized for the main device at the unit-substations can be problematic. They are basically a spring assisted knife switch. If these devices do not receive regular maintenance, they may fail to open or close. NETA recommends annual visual/mechanical inspections and testing performed every (3) three years.

Generator was completely rebuilt and reinstalled in 2015. It appears to be well maintained based on dates observed on the batteries and oil filters. A well-maintained standby generator can be expected to last 10,000 to 30,000 hours of use. We would request the generator and ATS testing reports in order to determine the approximate generator runtime to date.

Lighting

Lighting appears to be original to the building. General overhead lighting sources are fluorescent. We recommend consideration of LED replacement fixtures to update the lighting in the building for both energy savings and visual quality.

15. FIRE ALARM SYSTEM

- Fire alarm system review was not part of NV5 scope for this effort.

Conclusion: Based on required code upgrades and the estimated age of the existing fire alarm system, the fire alarm system shall be replaced in its entirety.

APPENDIX

- A. Mechanical System and Ductwork Photos
Level 5 Interior Ductwork
- B. Servers, Data Rooms Cooling Photos
- C. Hydronic Piping, Interior Photos
- D. Hydronic Piping, Exterior Photos
- E. Hydronic Piping, Wall Penetration Photos
- F. Plumbing Systems, Waste and Vent, Exterior Photos
- G. Plumbing Systems, Waste and Vent, Interior Photos
- H. Plumbing Systems - Hot Water Distribution Photos
- I. Plumbing Systems - Domestic Booster Pumps Photos
- J. Plumbing Systems - Fire Pump Room Photos
- K. Plumbing Systems - Roof Drain Photos
- L. Electrical Systems
- M. Chilled Water Piping - Wall thickness Measurements Table

A. Mechanical Systems and Ductwork



1 - HVAC Ductwork on Roof



2 - HVAC Ductwork & Mechanical Equipment



3 - HVAC Mechanical Equipment



4 - HVAC Ductwork on Roof



5 - HVAC Ductwork on Roof



6 - HVAC Ductwork on Roof



1 - HVAC Ductwork on Roof




2 - HVAC Ductwork



3 - Loose Tape



4 - HVAC Flexible Ductwork

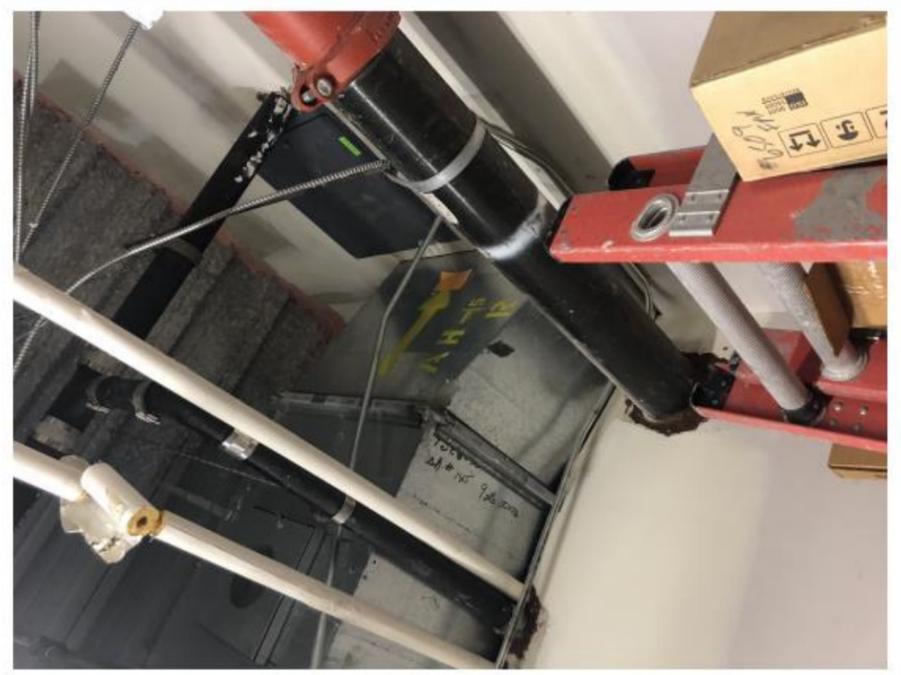

5 - HVAC Ductwork



 
 

6 - HVAC Ductwork



1 - HVAC Ductwork



2 - HVAC Ductwork

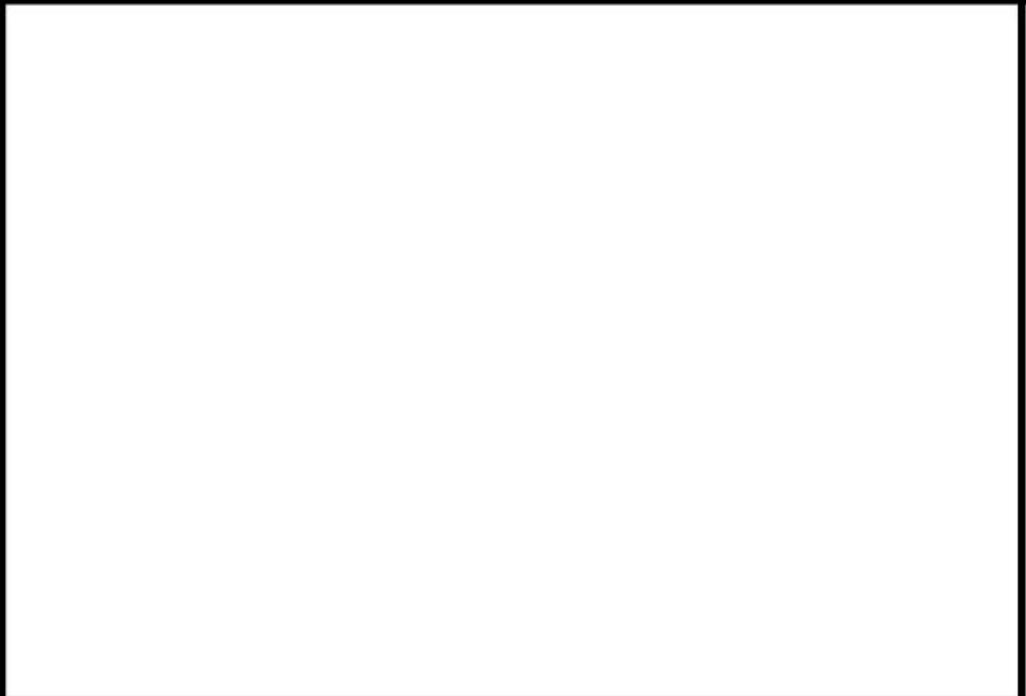

LEVEL 5 - HVAC DUCTWORK



1 - Duct Reducing Fitting with Mastic Sealant



2 - Duct Reducing Fitting with Mastic Sealant




3 - Duct Reducing - Exposed Fiberglass and Poor Insulation



4 - Exposed Fiberglass




5 - Duct Section

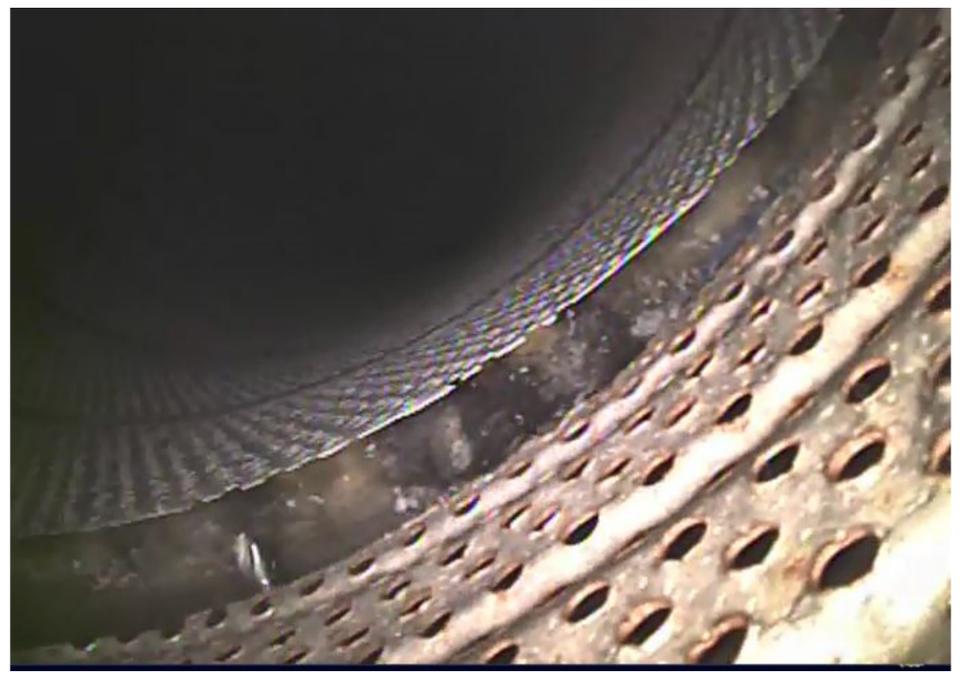

1 - Duct section - Segments not aligned



2 - Branch Fitting Penetration - Rust and Exposed Insulation

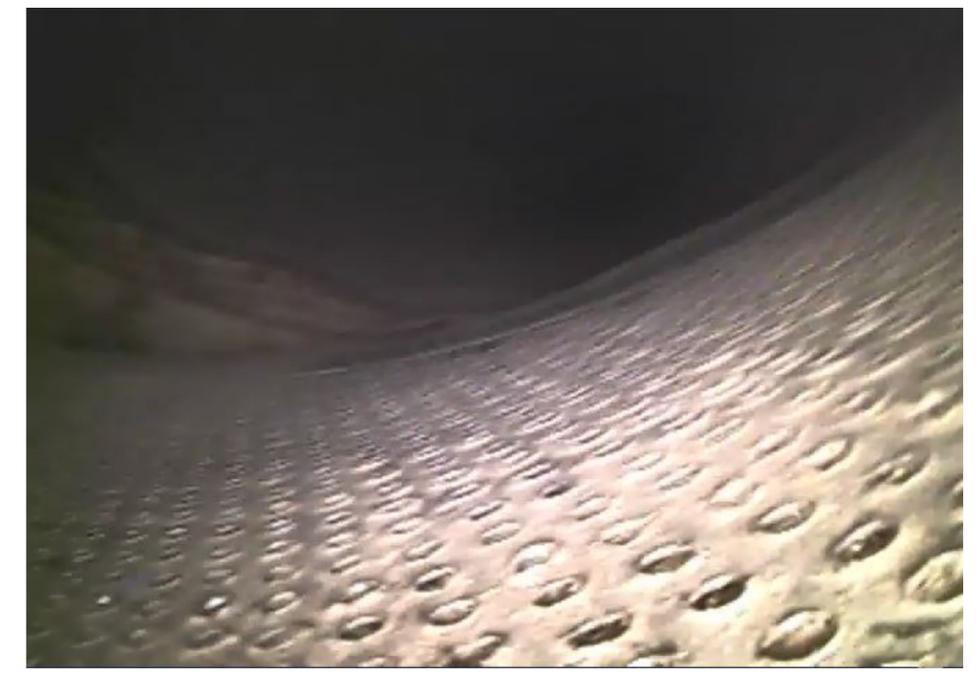

3 - Straight Duct Section



4 - Duct section




1 - Exposed Fiberglass - Missing Inner core



2 - Duct Sections - Branch Penetration - Exposed Insulation



3 - Duct Section - Fitting Penetration - Exposed Fiberglass

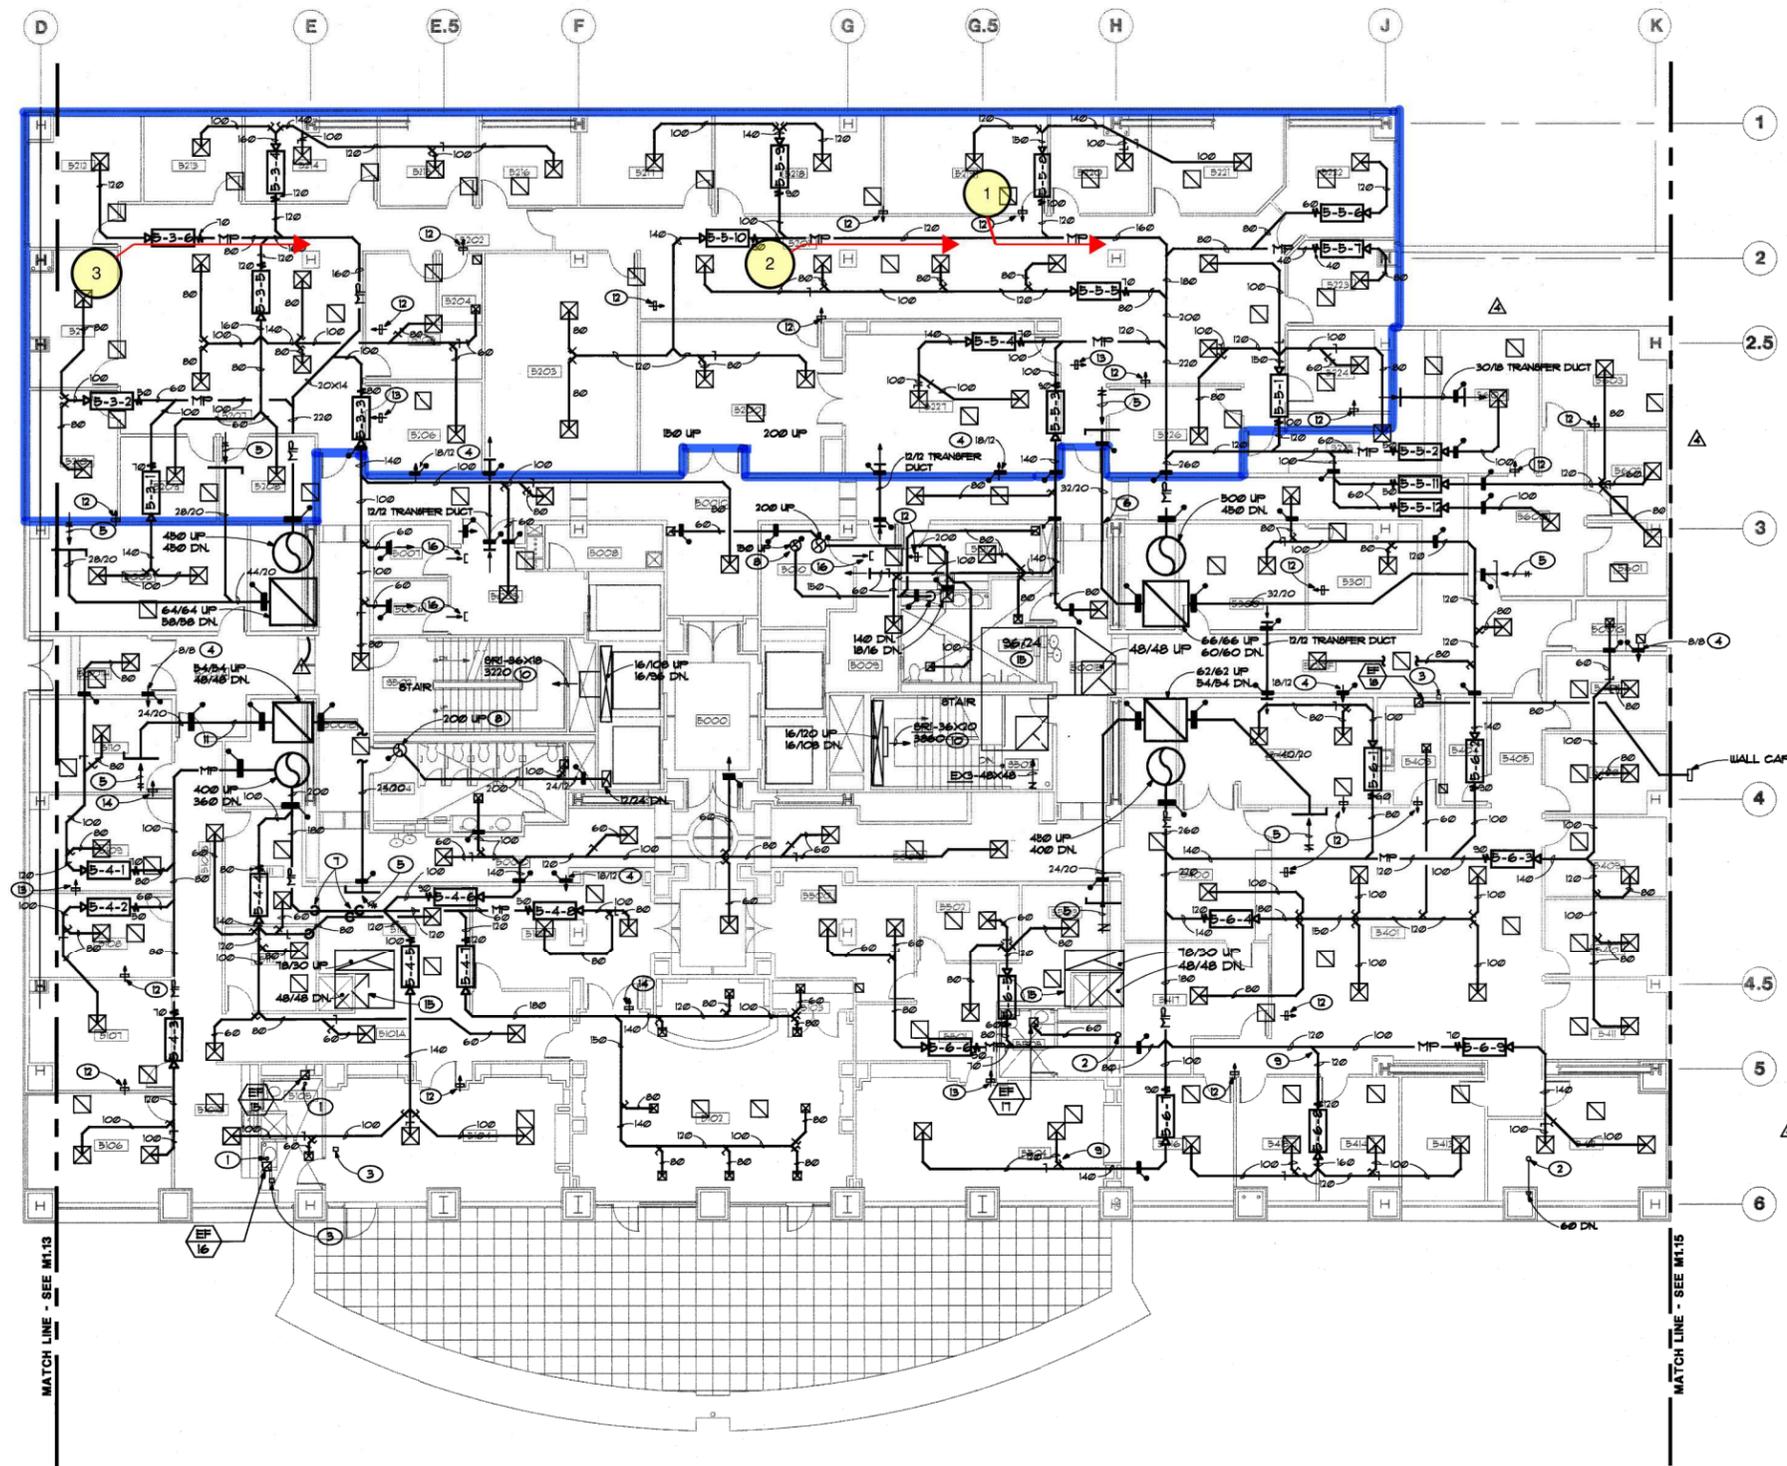

FIFTH FLOOR DUCTWORK PLAN - CENTER

SCALE: 1/8" = 1' - 0"

GENERAL NOTES

- A. PRIOR TO PURCHASE / FABRICATION, VERIFY "FIT" OF PROPOSED WORK.
- B. ROUND & RECTANGULAR DUCTWORK MAY BE USED INTERCHANGEABLY. USE "DUCTULATOR" FOR EQUIVALENT SIZES.
- C. DUCT DIMENSIONS SHOWN ARE INSIDE CLEAR DIMENSIONS. SEE SPECIFICATIONS FOR INTERNAL DUCT LINER REQUIREMENTS & INCREASE SHEET METAL SIZES ACCORDINGLY.
- D. DUCTWORK CONSTRUCTION REQUIREMENTS:
 - a) LOW PRESSURE: 1" WG POSITIVE OR NEGATIVE STATIC PRESSURE.
 - b) MEDIUM PRESSURE (MP): 4" WG POSITIVE STATIC PRESSURE.

SHEET NOTES

- ① 8'0" UP TO ROOF CAP.
- ② 6'0" UP TO ROOF CAP.
- ③ WALL MOUNTED SPEED CONTROL SWITCH.
- ④ COMBINATION FIRE / SMOKE DAMPER IN WALL, ABOVE CEILING. SIZE AS NOTED (TO MAINTAIN RA PATH).
- ⑤ MANUAL BALANCING DAMPER
- ⑥ FLATTEN TO 60/12 BELOW BEAM.
- ⑦ DROP & RISE AT BEAM.
- ⑧ G.C. WILL PROVIDE RATED DUCT ENCLOSURE AT BASE (ABOVE 5TH FLOOR CEILING) OF DUCT RISERS. HVAC C. SHALL PROVIDE COMBINATION SMOKE / FIRE DAMPERS AT ENCLOSURE PENETRATIONS.
- ⑨ TYPICAL: 45° WYE FITTING.
- ⑩ MOUNT W/ BOTTOM AT 12" ABOVE LIGHT FIXTURE.
- ⑪ SEE ARCHITECTURAL DRAWINGS FOR RATED WALL OFFSET AROUND DUCT.
- ⑫ 12X12 OPENING, IN WALL, ABOVE CEILING; (TO MAINTAIN RA PATH).
- ⑬ 18X12 OPENING, IN WALL, ABOVE CEILING; (TO MAINTAIN RA PATH).
- ⑭ 24X12 OPENING, IN WALL, ABOVE CEILING; (TO MAINTAIN RA PATH).
- ⑮ SEE ARCHITECTURAL DRAWINGS FOR RATED ENCLOSURE FOR THIS DUCT.
- ⑯ R3 - 12X12, ABOVE ADJACENT ROOM CEILING; (TO MAINTAIN RA PATH).

AIR DISTRIBUTION SCHEDULE													
ROOM NO.	TERMINAL NUMBER	AIR DEVICE TAG			QUANTITY			NECK SIZE			CFM (EACH)		
		S	R	E	S	R	E	S	R	E	S	R	E
B003	B-3-1	D1	RI	---	2	1	---	120	22X22	---	285	280	---
B210	B-3-2	D1	RI	---	1	1	---	80	22X22	---	150	150	---
B211	B-3-2	D1	RI	---	1	1	---	80	22X22	---	150	150	---
B008	B-3-3	D1	RI	---	1	1	---	100	22X22	---	205	205	---
B00C	B-3-3	D1	RI	---	2	1	---	80	22X22	---	150	150	---
B00E	B-3-3	D1	RI	---	1	1	---	80	22X22	---	150	150	---
B00F	B-3-3	DR	RE	(2)	---	---	(2)	6X4 (2)	---	---	50	50	---
B00T	B-3-3	DR	RE	(2)	---	---	(2)	6X4 (2)	---	---	50	50	---
B213	B-3-4	D1	RI	---	1	1	---	100	22X22	---	205	205	---
B214	B-3-4	D1	RI	---	1	1	---	100	22X22	---	205	205	---
B215	B-3-4	D1	RI	---	1	1	---	100	22X22	---	205	205	---
B216	B-3-4	D1	RI	---	1	1	---	100	22X22	---	205	205	---
B204	B-3-5	D3	RS	---	1	1	---	6X6	6X6	---	50	50	---
B205	B-3-5	D1	RI	---	1	1	---	80	22X22	---	140	140	---
B206	B-3-5	D1	RI	---	1	1	---	60	22X22	---	80	80	---
B207	B-3-5	D1	RI	---	4	1	---	60	22X22	---	165	660	---
B208	B-3-5	D1	RI	---	1	1	---	60	22X22	---	100	100	---
B209	B-3-5	D1	RI	---	1	1	---	60	22X22	---	100	100	---
B212	B-3-6	D1	RI	---	1	1	---	140	22X22	---	505	505	---
B00H	B-4-1	D1	RI	---	1	1	---	80	22X22	---	155	155	---
B108	B-4-1	D1	RI	---	1	1	---	80	22X22	---	140	140	---
B110	B-4-1	D1	RI	---	1	1	---	80	22X22	---	145	145	---
B107	B-4-2	D1	RI	---	1	1	---	80	22X22	---	165	165	---
B108	B-4-2	D1	RI	---	1	1	---	80	22X22	---	150	150	---
B10A	B-4-3	D1	RI	---	2	1	---	100	22X22	---	260	520	---
B10A	B-4-4	D1	RI	---	2	1	---	100	22X22	---	95	520	---
B10B	B-4-4	D1	RI	---	1	1	---	60	22X22	---	70	70	---
B111	B-4-4	D1	RI	---	1	1	---	60	22X22	---	60	60	---
B112	B-4-4	D1	RI	---	1	1	---	80	22X22	---	120	120	---
B113	B-4-4	D1	RI	---	1	1	---	80	22X22	---	15	15	---
B10C	B-4-5	D1	RI	---	1	1	---	100	---	---	225	---	---
B104	B-4-5	D1	RI	---	2	1	---	100	22X22	---	280	560	---
B105	B-4-5	D3	RS	---	1	1	---	6X6	---	---	10	---	---
B000	B-4-6	DR	RE	---	---	---	---	6X6	---	---	80	---	---
B00D	B-4-6	D1	RI	---	5	1	---	60	22X22	---	10	350	---
B004	B-4-6	D3	RS	---	---	---	---	9X9	---	12X12	250	---	350
B102	B-4-7	D3	RS	---	8	2	---	9X9	---	---	165	660	---
B103	B-4-7	D3	RS	---	1	1	---	6X6	8X8	---	80	80	---
B100	B-4-8	D1	RI	---	2	1	---	80	22X22	---	120	240	---
B201	B-5-1	D1	RI	---	2	1	---	120	22X22	---	280	580	---
B224	B-5-1	D1	RI	---	1	1	---	60	22X22	---	100	100	---
B225	B-5-1	D1	RI	---	1	1	---	80	22X22	---	120	120	---
B226	B-5-1	D1	RI	---	1	1	---	80	22X22	---	155	155	---
B604	B-5-2	D1	RI	---	1	1	---	100	22X22	---	200	200	---
B00E	B-5-3	D1	RI	---	1	1	---	80	22X22	---	15	230	---
B00E	B-5-3	D1	RI	---	1	1	---	80	22X22	---	15	75	---
B009	B-5-3	D1	RI	---	1	1	---	60	22X22	---	15	75	---
B010	B-5-3	DR	RE	(2)	---	---	(2)	6X4 (2)	---	---	70	70	---
B012	B-5-3	D1	RI	---	---	---	---	---	---	---	---	---	---
B013	B-5-3	D3	RS	---	---	---	---	---	---	---	---	---	---
B221	B-5-4	D1	RI	---	2	1	---	120	22X22	---	300	600	---
B201	B-5-5	D1	RI	---	4	1	---	80	22X22	---	150	320	---
B222	B-5-6	D1	RI	---	1	1	---	120	22X22	---	390	390	---
B223	B-5-7	D1	RI	---	1	1	---	80	22X22	---	120	120	---
B218	B-5-8	D1	RI	---	1	1	---	140	22X22	---	430	430	---
B220	B-5-8	D1	RI	---	1	1	---	100	22X22	---	265	265	---
B221	B-5-8	D1	RI	---	1	1	---	120	22X22	---	340	340	---
B217	B-5-9	D1	RI	---	1	1	---	120	22X22	---	335	335	---
B218	B-5-9	D1	RI	---	1	1	---	140	22X22	---	430	430	---
B200	B-5-10	D1	RI	---	2	1	---	100	22X22	---	155	390	---
B203	B-5-10	D1	RI	---	2	1	---	80	22X22	---	180	360	---
B601	B-5-11	D1	RI	---	1	1	---	80	22X22	---	120	120	---
B602	B-5-11	D1	RI	---	1	1	---	60	22X22	---	55	55	---
B603	B-5-11	D1	RI	---	1	1	---	80	22X22	---	165	165	---
B600	B-5-12	D1	RI	---	1	1	---	100	22X22	---	150	150	---
B402	B-6-1	D1	RI	---	2	1	---	80	22X22	---	170	340	---
B00C	B-6-2	D1	RI	---	1	1	---	80	---	---	125	---	---
B00F	B-6-2	D1	RI	---	1	1	---	80	22X22	---	125	375	---
B300	B-6-2	D1	RI	---	1	1	---	80	22X22	---	155	155	---
B301	B-6-2	D1	RI	---	1	1	---	80	22X22	---	140	140	---
B302	B-6-2	D1	RI	---	1	1	---	80	---	---	125	---	---
B00G	B-6-3	D3	RS	---	1	1	---	6X6	8X8	---	75	75	---
B401	B-6-3	D1	RI	---	1	1	---	80	22X22	---	155	155	---
B408	B-6-3	D1	RI	---	1	1	---	80	22X22	---	155	155	---
B409	B-6-3	D1	RI	---	1	1	---	80	22X22	---	155	155	---
B410	B-6-3	D1	RI	---	1	1	---	80	22X22	---	155	155	---
B411	B-6-3	D1	RI	---	1	1	---	80	22X22	---	155	155	---
B400	B-6-4	D1	RI	---	1	1	---	100	22X22	---	275	275	---
B401	B-6-4	D1	RI	---	4	2	---	100	22X22	---	230	460	---
B403	B-6-4	D3	RS	---	---	---	---	6X6	8X8	---	90	90	---
B411	B-6-4	D1	RI	---	1	1	---	100	22X22	---	185	185	---
B601	B-6-5	D1	RI	---	1	1	---	80	22X22	---	140	140	---
B602	B-6-5	D1	RI	---	1	1	---	60	22X22	---	100	100	---
B603	B-6-5	D1	RI	---	1	1	---	100	22X22	---	160	160	---
B600	B-6-6	D1	RI	---	2	1	---	60	22X22	---	100	200	---
B604	B-6-7	D1	RI	---	2	1	---	120	22X22	---	385	770	---
B413	B-6-8	D1	RI	---	1	1	---	120	22X22	---	285	285	---
B414	B-6-8	D1	RI	---	1	1	---	100	22X22	---	220	220	---
B415	B-6-8	D1	RI	---	1	1	---	100	22X22	---	220	220	---
B416	B-6-8	D1	RI	---	1	1	---	120	22X22	---	350	350	---
B412	B-6-9	D1	RI	---	2	1	---	120	22X22	---	285	570	---
B008	---	---	---	---	---	---	---	---	---	---	---	---	---
B505	---	---	---	---	---	---	---	---	---	---	---	---	---

- NOTES:
- (1) HVAC CONTRACTOR SHALL BE RESPONSIBLE FOR DETERMINING THE EXACT CEILING TYPE PROPOSED TO BE INSTALLED PRIOR TO PURCHASE OF AIR DEVICES.
 - (2) AIR RELIEF/RETURN WITH OR WITHOUT FIRE OR FIRE/SMOKE DAMPER SHALL BE AS NOTED ON PLAN.
 - (3) UNLESS NOTED OTHERWISE IN THE MARGIN, DIFFUSERS SHALL BE 4 WAY THROW.
 - (4) SEE ARCHITECTURAL REFLECTED CEILING PLANS FOR AIR DEVICE LOCATIONS.




LUCCHESI GALATI ARCHITECTS
 2770 SOUTH MARYLAND PARKWAY
 SUITE 510
 LAS VEGAS, NEVADA 89109
 (702) 733-7107



STATE OFFICE BUILDING
 DEPARTMENT OF GENERAL SERVICES
 SPWB JOB # 91-C9

HARRIS ENGINEERS, INC.
 MECHANICAL/ELECTRICAL CONSULTANTS
 2785 East Desert Inn Road, Suite 200
 Las Vegas, Nevada 89121
 702/798-0224

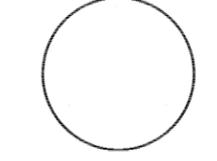


Check and verify all dimensions and report all errors to the architect prior to commencing work. These drawings are not to be used for any other project without the written consent of the architect. All drawings, specifications and copies thereof furnished by the architect are to be used only with respect to this project and are not to be used on any other project without the written consent of the architect. Such documents are to be returned or destroyed upon completion of the project. Submission or distribution to any other party without the written consent of the architect is prohibited. Copyright © 1992 Harris Engineers, Inc. A Nevada Corporation. Copyright Lucchese & Associates, Inc. 1992.

Date: FEBRUARY 23, 1993.
 Project No.: 91-010
 Scale: 1/8" = 1' - 0"
 Drawn By: RJ
 Revisions:
 2-23-93 RECORD DRAWINGS

Sheet Title:
FIFTH FLOOR DUCTWORK PLAN - CENTER

Sheet Number:

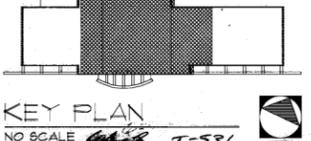

M1.14


B. Servers/Data Rooms Cooling



1 - Server Room Equipment



2 - Server Room HVAC Equipment

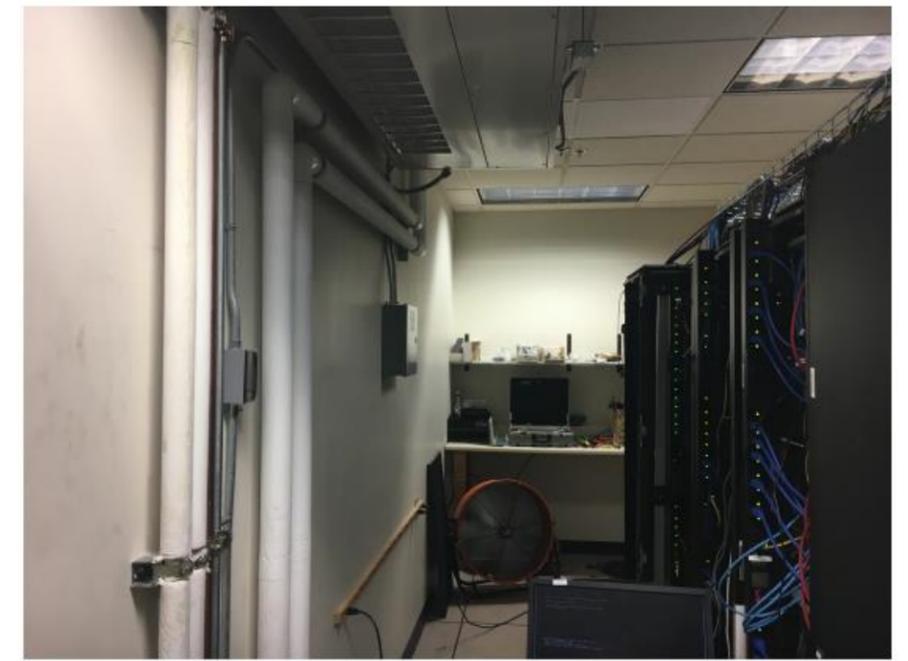


3 - Server Room Equipment




4 - Server Room Equipment



5 - Server Room Equipment

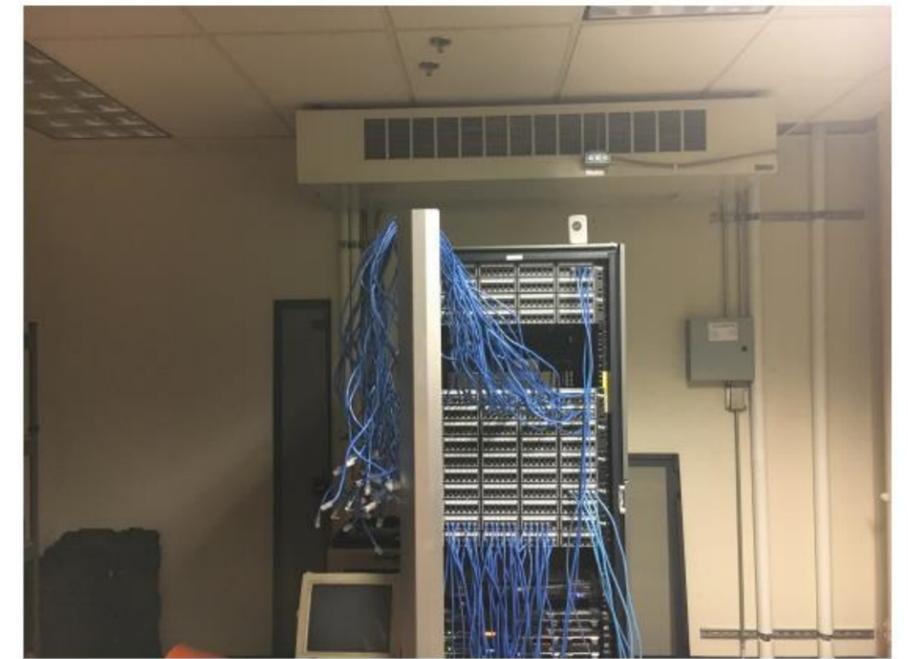

6 - Server Room Equipment

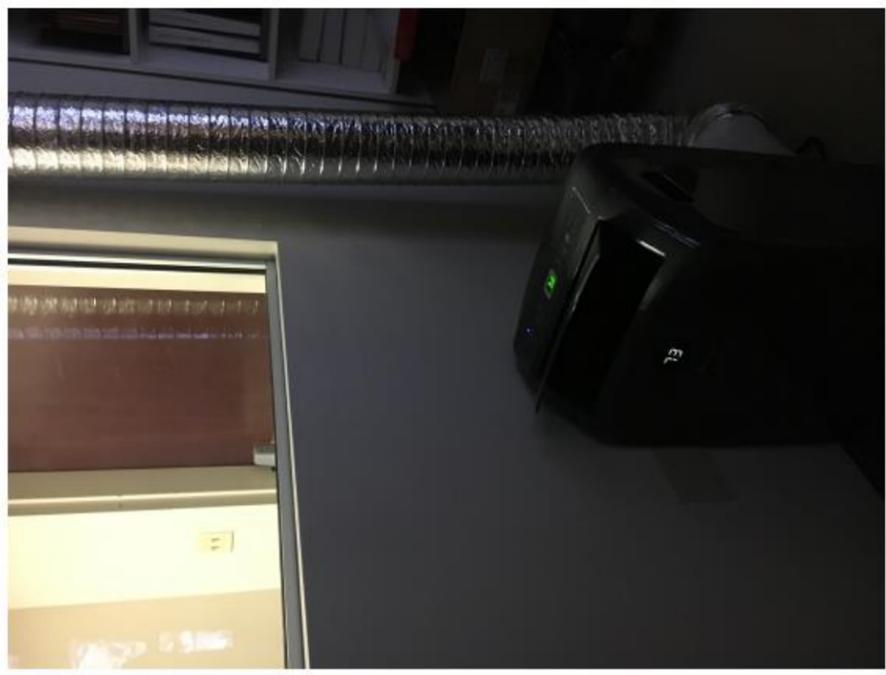

1 - Server Room - HVAC Equipment & Ductwork



2 - Server Room - HVAC Equipment & Ductwork



3 - Server Room - HVAC Equipment & Ductwork



4 - Server Room - HVAC Equipment & Ductwork



5 - Server Room - HVAC Equipment & Ductwork



6 - Server Room - HVAC Equipment & Ductwork



1 - Server Room Equipment




2 - Server Room - HVAC Equipment & Ductwork

C. Hydronic Piping - Interiors



1 - Hydronic Piping - Interior Condition

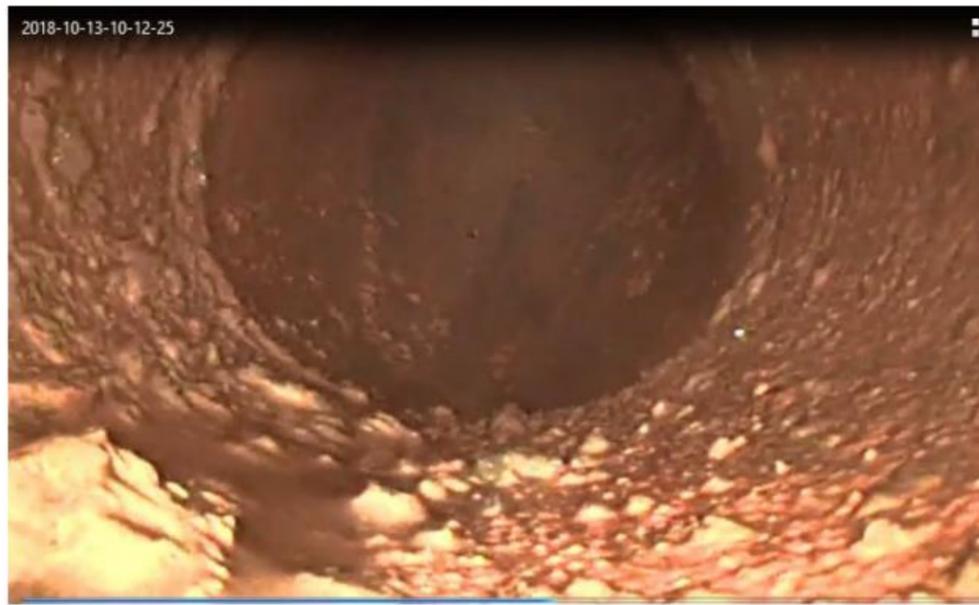


2 - Hydronic Piping - Interior Condition



3 - Hydronic Piping - Interior Condition



4 - Hydronic Piping - Interior Condition

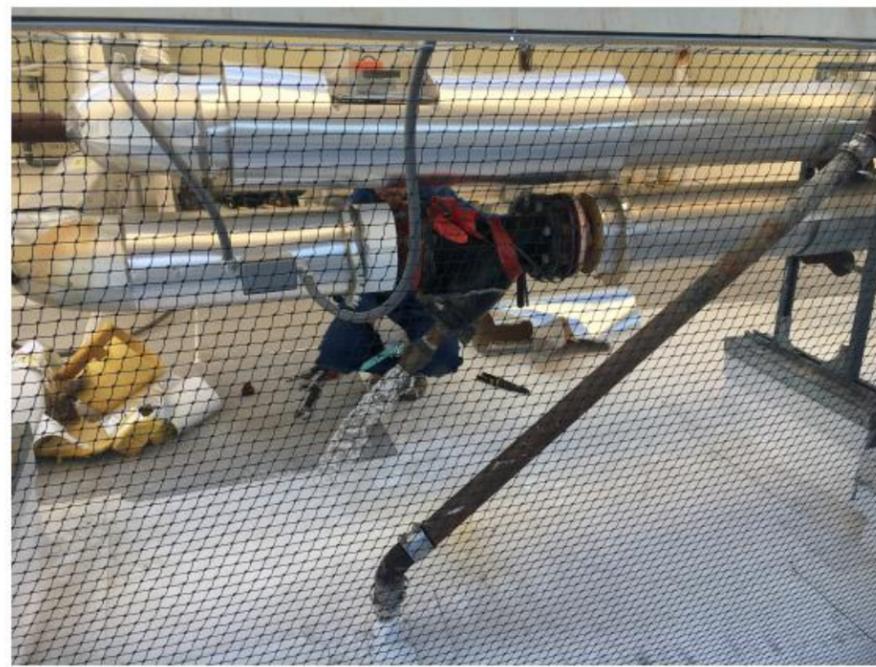

5 - Hydronic Piping - Camera Insertion Point



6 - Hydronic Piping - Camera Insertion Point

D. Hydronic Piping - Exteriors



1 - Hydronic Piping - Exterior Corrosion & Insulation



2 - Hydronic Piping - Exterior Corrosion & Insulation



3 - Hydronic Piping - Heating Hot Water



4 - Hydronic Piping - Exterior Corrosion & Insulation



5 - Hydronic Piping - Exterior Corrosion & Insulation



6 - Hydronic Piping - Exterior Condition & Insulation



1 - Hydronic Piping - Exterior Corrosion & Insulation



2 - Hydronic Piping - Exterior Insulation



3 - Hydronic Piping - Exterior Corrosion & Insulation



4 - Hydronic Piping - AHU Connection



5 - Hydronic Piping - AHU Connection



6 - Hydronic Piping - Exterior Condition & Insulation



1 - Hydronic Piping - Exterior Corrosion & Insulation



2 - Hydronic Piping - Heating Hot Water



3 - Hydronic Piping - Exterior Corrosion & Insulation



4 - Hydronic Piping - Exterior Condition & Insulation



5 - Hydronic Piping - Exterior Condition & Insulation



6 - Hydronic Piping - Exterior Corrosion & Insulation



1 - Hydronic Piping - Exterior Condition & Insulation



2 - Hydronic Piping - Exterior Condition & Insulation



3 - Hydronic Piping - Exterior Corrosion & Insulation



4 - Hydronic Piping - Exterior Corrosion & Insulation



5 - Hydronic Piping - Exterior Corrosion & Insulation



E. Hydronic Piping - Wall Penetrations



1 - Hydronic Piping - Floor Penetration



2 - Hydronic Piping - Floor Penetration



3 - Hydronic Piping - Floor Penetration



4 - Hydronic Piping - Floor Penetration



5 - Hydronic Piping - Wall Penetration



6 - Hydronic Piping - Wall Penetration



1 - Hydronic Piping - Wall Penetration



2 - Hydronic Piping - Wall Penetration




3 - Hydronic Piping - Wall Penetration



4 - Hydronic Piping - Wall Penetration



5 - Hydronic Piping - Wall Penetration

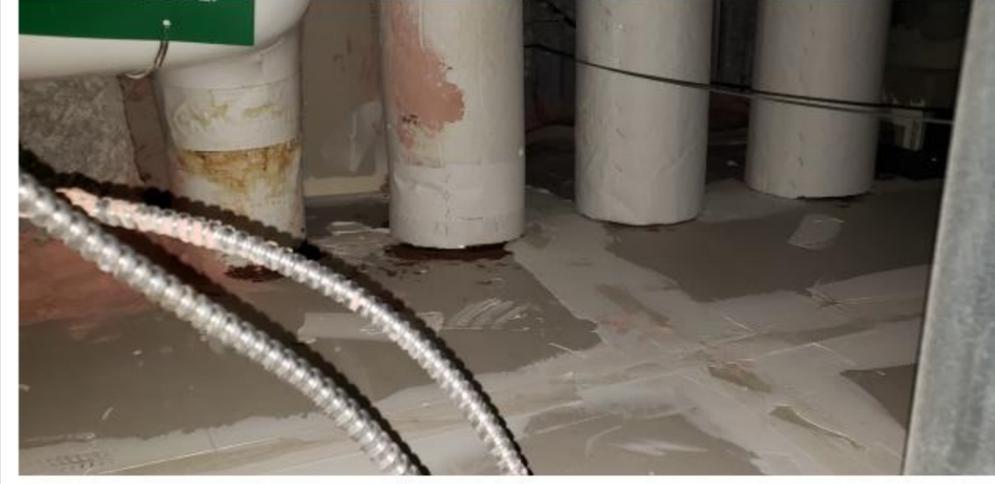

6 - Hydronic Piping - Wall Penetration

F. Plumbing Systems - Waste and Vent - Exteriors



1 - Plumbing Systems - Waste and Vent



2 - Plumbing Systems - Waste and Vent



3 - Plumbing Systems - Waste and Vent



4 - Plumbing Systems - Waste and Vent

G. Plumbing Systems - Waste and Vent - Interiors



1 - Plumbing Systems - Waste and Vent - Interiors



2 - Plumbing Systems - Waste and Vent - Interiors



3 - Plumbing Systems - Waste and Vent - Interiors



4 - Plumbing Systems - Water Pressure Flushed Debris




5 - Plumbing Systems - Collapsed Cast Iron



6 - Plumbing Systems - Waste and Vent - Interiors



1 - Plumbing Systems - Underground - Collapsed Cast Iron

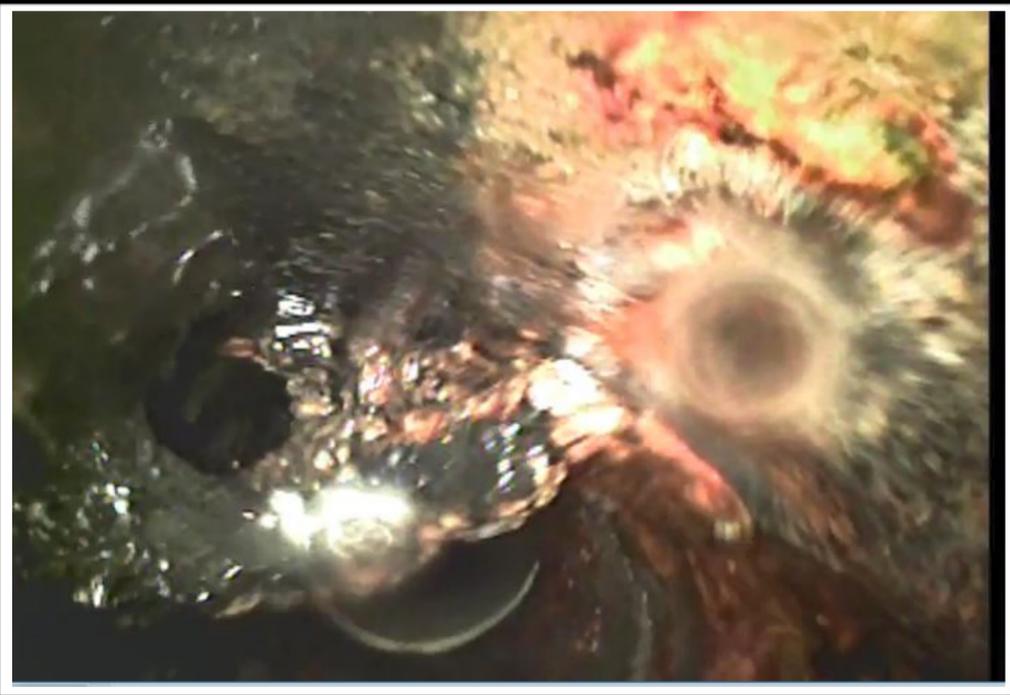

2 - Plumbing Systems - Underground - Collapsed Cast Iron



3 - Plumbing Systems - Underground - Collapsed Cast Iron

H. Plumbing Systems - Hot Water Distribution



1 - Plumbing Systems - Water Heaters



2 - Plumbing Systems - Tempering Station



3 - Plumbing Systems - Tempering Station



4 - Plumbing Systems - Tempering Station



5 - Plumbing Systems - Tempering Station



6 - Plumbing Systems - Gas Meter

I. Plumbing Systems - Domestic Booster Pumps



1 - Plumbing Systems - Domestic Booster Pump



2 - Plumbing Systems - Domestic Booster Pump



3 - Plumbing Systems - Domestic Booster Pump



4 - Plumbing Systems - Domestic Booster Pump



5 - Plumbing Systems - Storm Water Sump Pumps

J. Plumbing Systems - Fire Pump Room



1 - Fire Pump Room



2 - Fire Pump Room



3 - Fire Pump Room



4 - Fire Pump Room

K. Plumbing Systems - Roof Drains




1 - Primary Roof Drain NE



2 - Primary Roof Drain NE



3 - Overflow Roof Drain NE

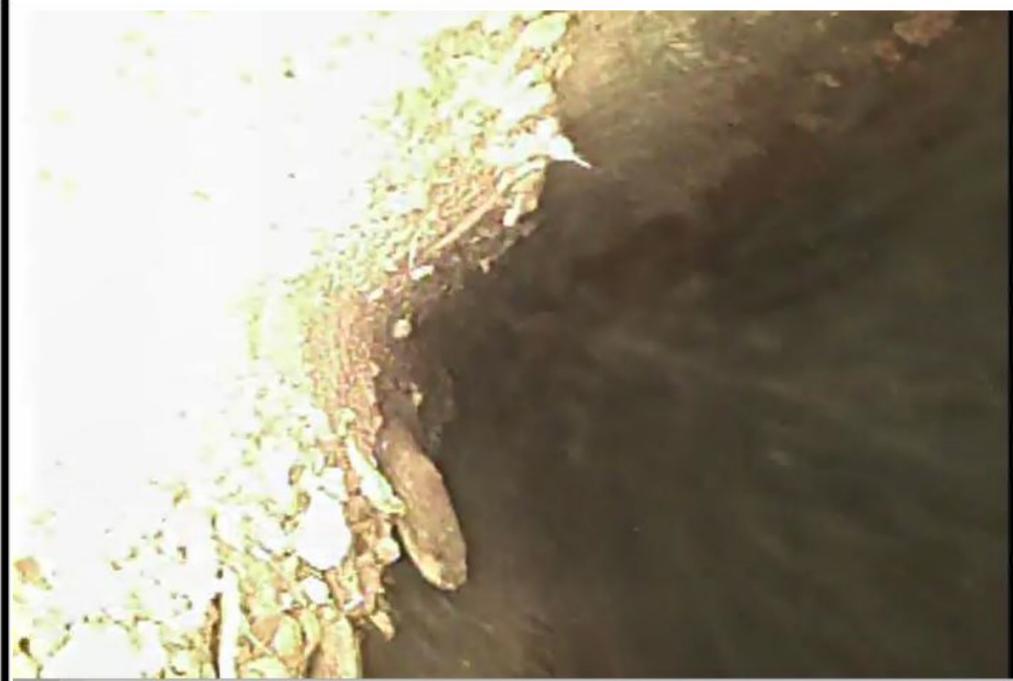

4 - Overflow Roof Drain NE



L. Electrical Systems



1 - Meters located at north end of building near loading dock. NVE meter is on the right. The PV system REC meter is on the left.



2 - Main service switchgear 'MVS1' 600A, 12.47KV, 3-phase, 3-wire.




3 - PV system inverter located in same room as main service switchgear. Inverter is tied into service at 480V Unit-substation 'USW'.



4 - Unit-substation 'USW' located on west half of Level 1. (1500kVA) Equipment is mis-labeled as 'USR'.



5 - Electrical room on west half of Level 1 adjacent to Cafe. Electrical rooms should not be used for storage.

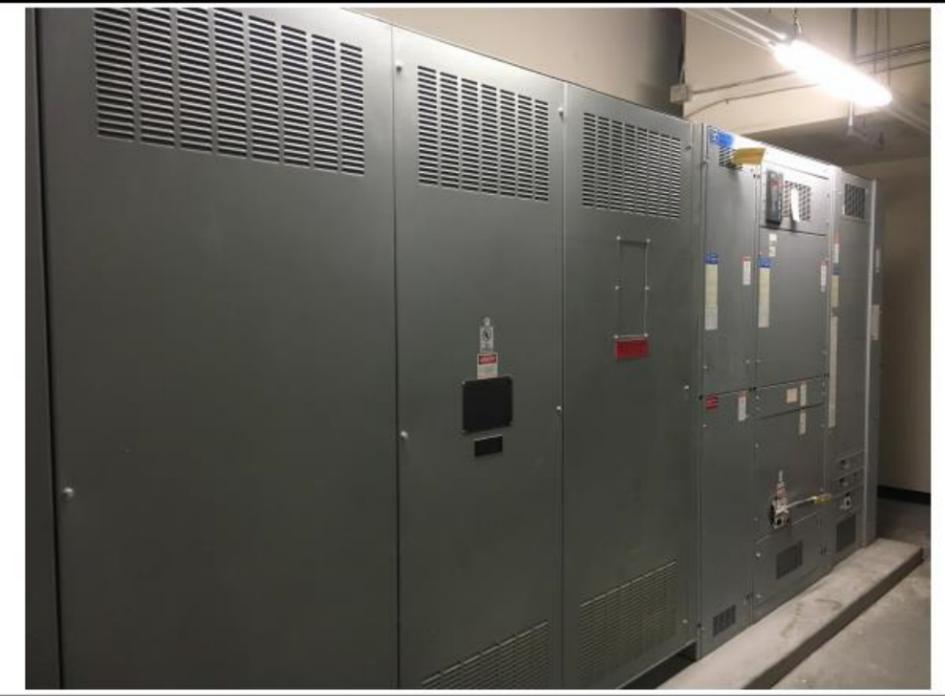


6 - Unit-substation 'USE' located on east half of Level 1. (750kVA)



1 - Generator. 800kW, 277/480V, 3-phase, 4-wire with 500 gallon sub-base fuel tank.



2 - Generator distribution panel not indicated on single line diagrams. 1200A, 277/480V, 3-phase, 4-wire.

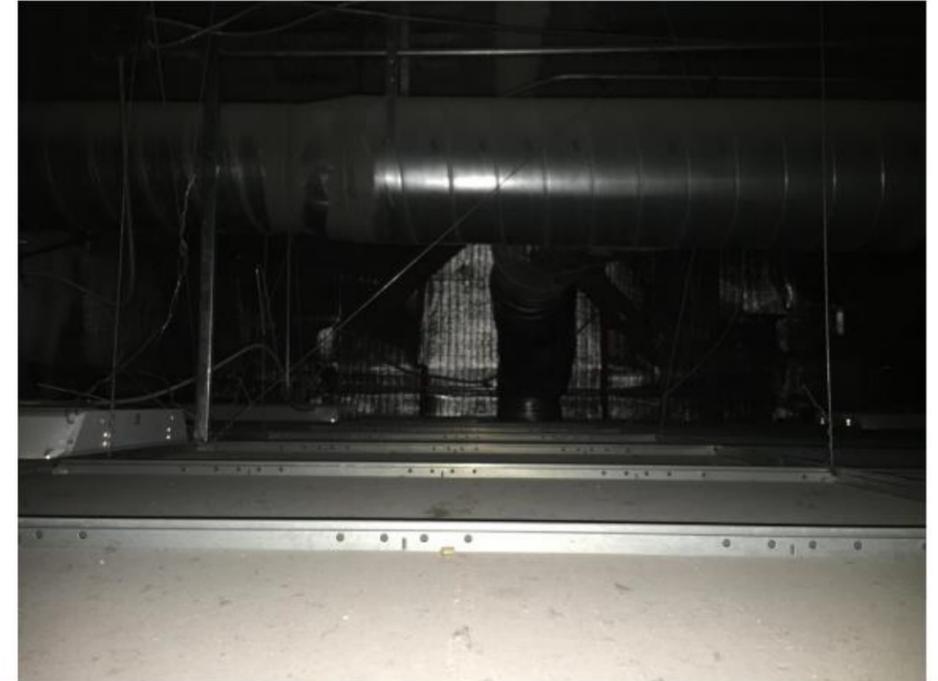

3 - Ceiling space above a typical office. Conduit and cable installation is mostly in neat condition.



4 - Hole observed in rated wall of emergency electrical room on level 2.



5 - Receptacles in wet locations exposed to sky are left open. Suggest replacing with "while-in-use" covers.



6 - Unit-substation 'USR' located on Level 6. (2500kVA) Equipment is mis-labeled as 'USW'.




1 - String of VRLA batteries located in the Level 6 electrical room.



2 - Emergency dist. boards 'EDP2' (left) and 'EDP3' (center) are installed with incorrect rating. 250A equipment connected to 600A feeders.

M. Chilled Water Piping - Wall Thickness Measurements

Test Point	Field Measurement		Pipe Size	Schedule 40 Wall Thickness
	CHS	CHR		
1	5.5	5.4	3"	5.5
2	6.4	6.5	5"	6.5
3	5.6	5.6	4"	6.0
4	6.4	6.4	5"	6.5
5	5.6	5.7	4"	6.0
6	6.0	5.5	4"	6.0
7	6.6		5"	6.5
8		6.1	5"	6.5
9	5.5	5.6	4"	6.0
10	5.0	5.0	3"	5.5
11	6.4	6.5	5"	6.5
12	5.4	5.6	4"	6.0
13	5.7		4"	6.0
14	5.6	6.4	4"	6.0
15	5.0	5.1	3"	5.5

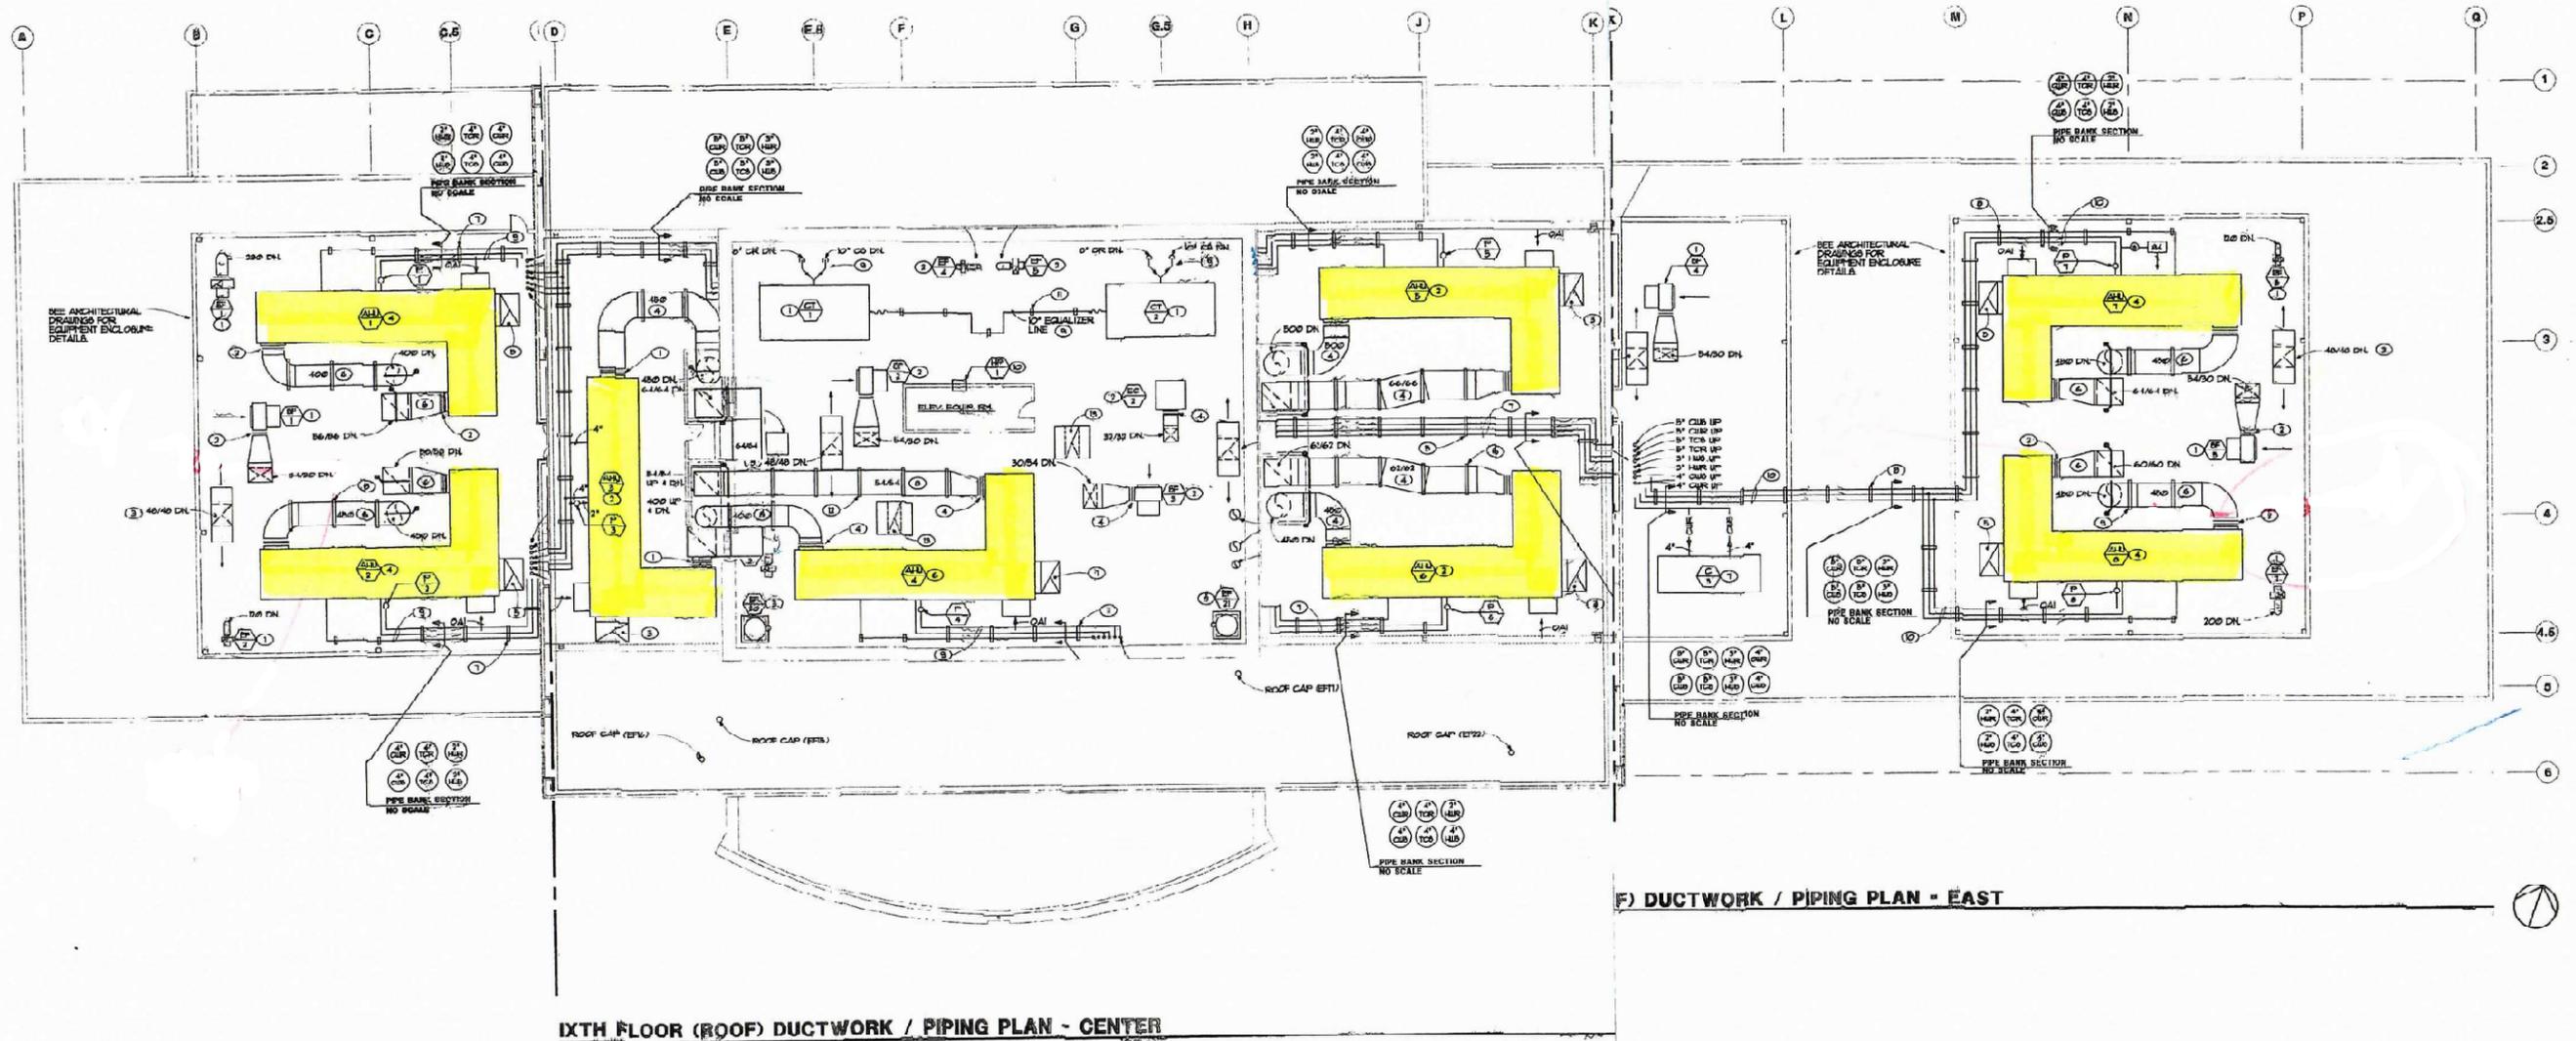

5TH FLOOR (ROOF) DUCTWORK / PIPING PLAN - CENTER

FIFTH FLOOR (ROOF) DUCTWORK / PIPING PLAN - 1



F) DUCTWORK / PIPING PLAN - EAST

GENERAL

- A. SEE ARCHIT. DRAWINGS FOR EQUIPMENT ENCL. DETAILS
- B. DUCTWORK SHALL BE INSTALLED IN ACCORDANCE WITH THE FOLLOWING:
 - 1. POINT ON ELEVATION
 - 2. TYPICAL IN
 - 3. EXTEND UP TO
 - 4. POINT ON ELEVATION
 - 5. SEE SCHEDULE
 - 6. SEE SCHEDULE
 - 7. TYPICAL IN ARCHITECTURAL DRAWINGS
 - 8. TYPICAL IN ARCHITECTURAL DRAWINGS
 - 9. SEE PIPE SCHEDULE
- C. GENERAL CONTRACTOR SHALL BE RESPONSIBLE FOR OBTAINING ALL NECESSARY PERMITS AND APPROVALS FROM THE LOCAL AUTHORITIES.
- D. CONTRACTOR SHALL BE RESPONSIBLE FOR OBTAINING ALL NECESSARY PERMITS AND APPROVALS FROM THE LOCAL AUTHORITIES.
- E. SEE SPEC. FOR PIPELINE.

SHEET NO.

- 1. POINT ON ELEVATION
- 2. TYPICAL IN
- 3. EXTEND UP TO
- 4. POINT ON ELEVATION
- 5. SEE SCHEDULE
- 6. SEE SCHEDULE
- 7. TYPICAL IN ARCHITECTURAL DRAWINGS
- 8. TYPICAL IN ARCHITECTURAL DRAWINGS
- 9. SEE PIPE SCHEDULE

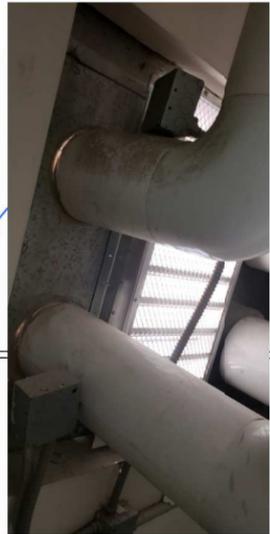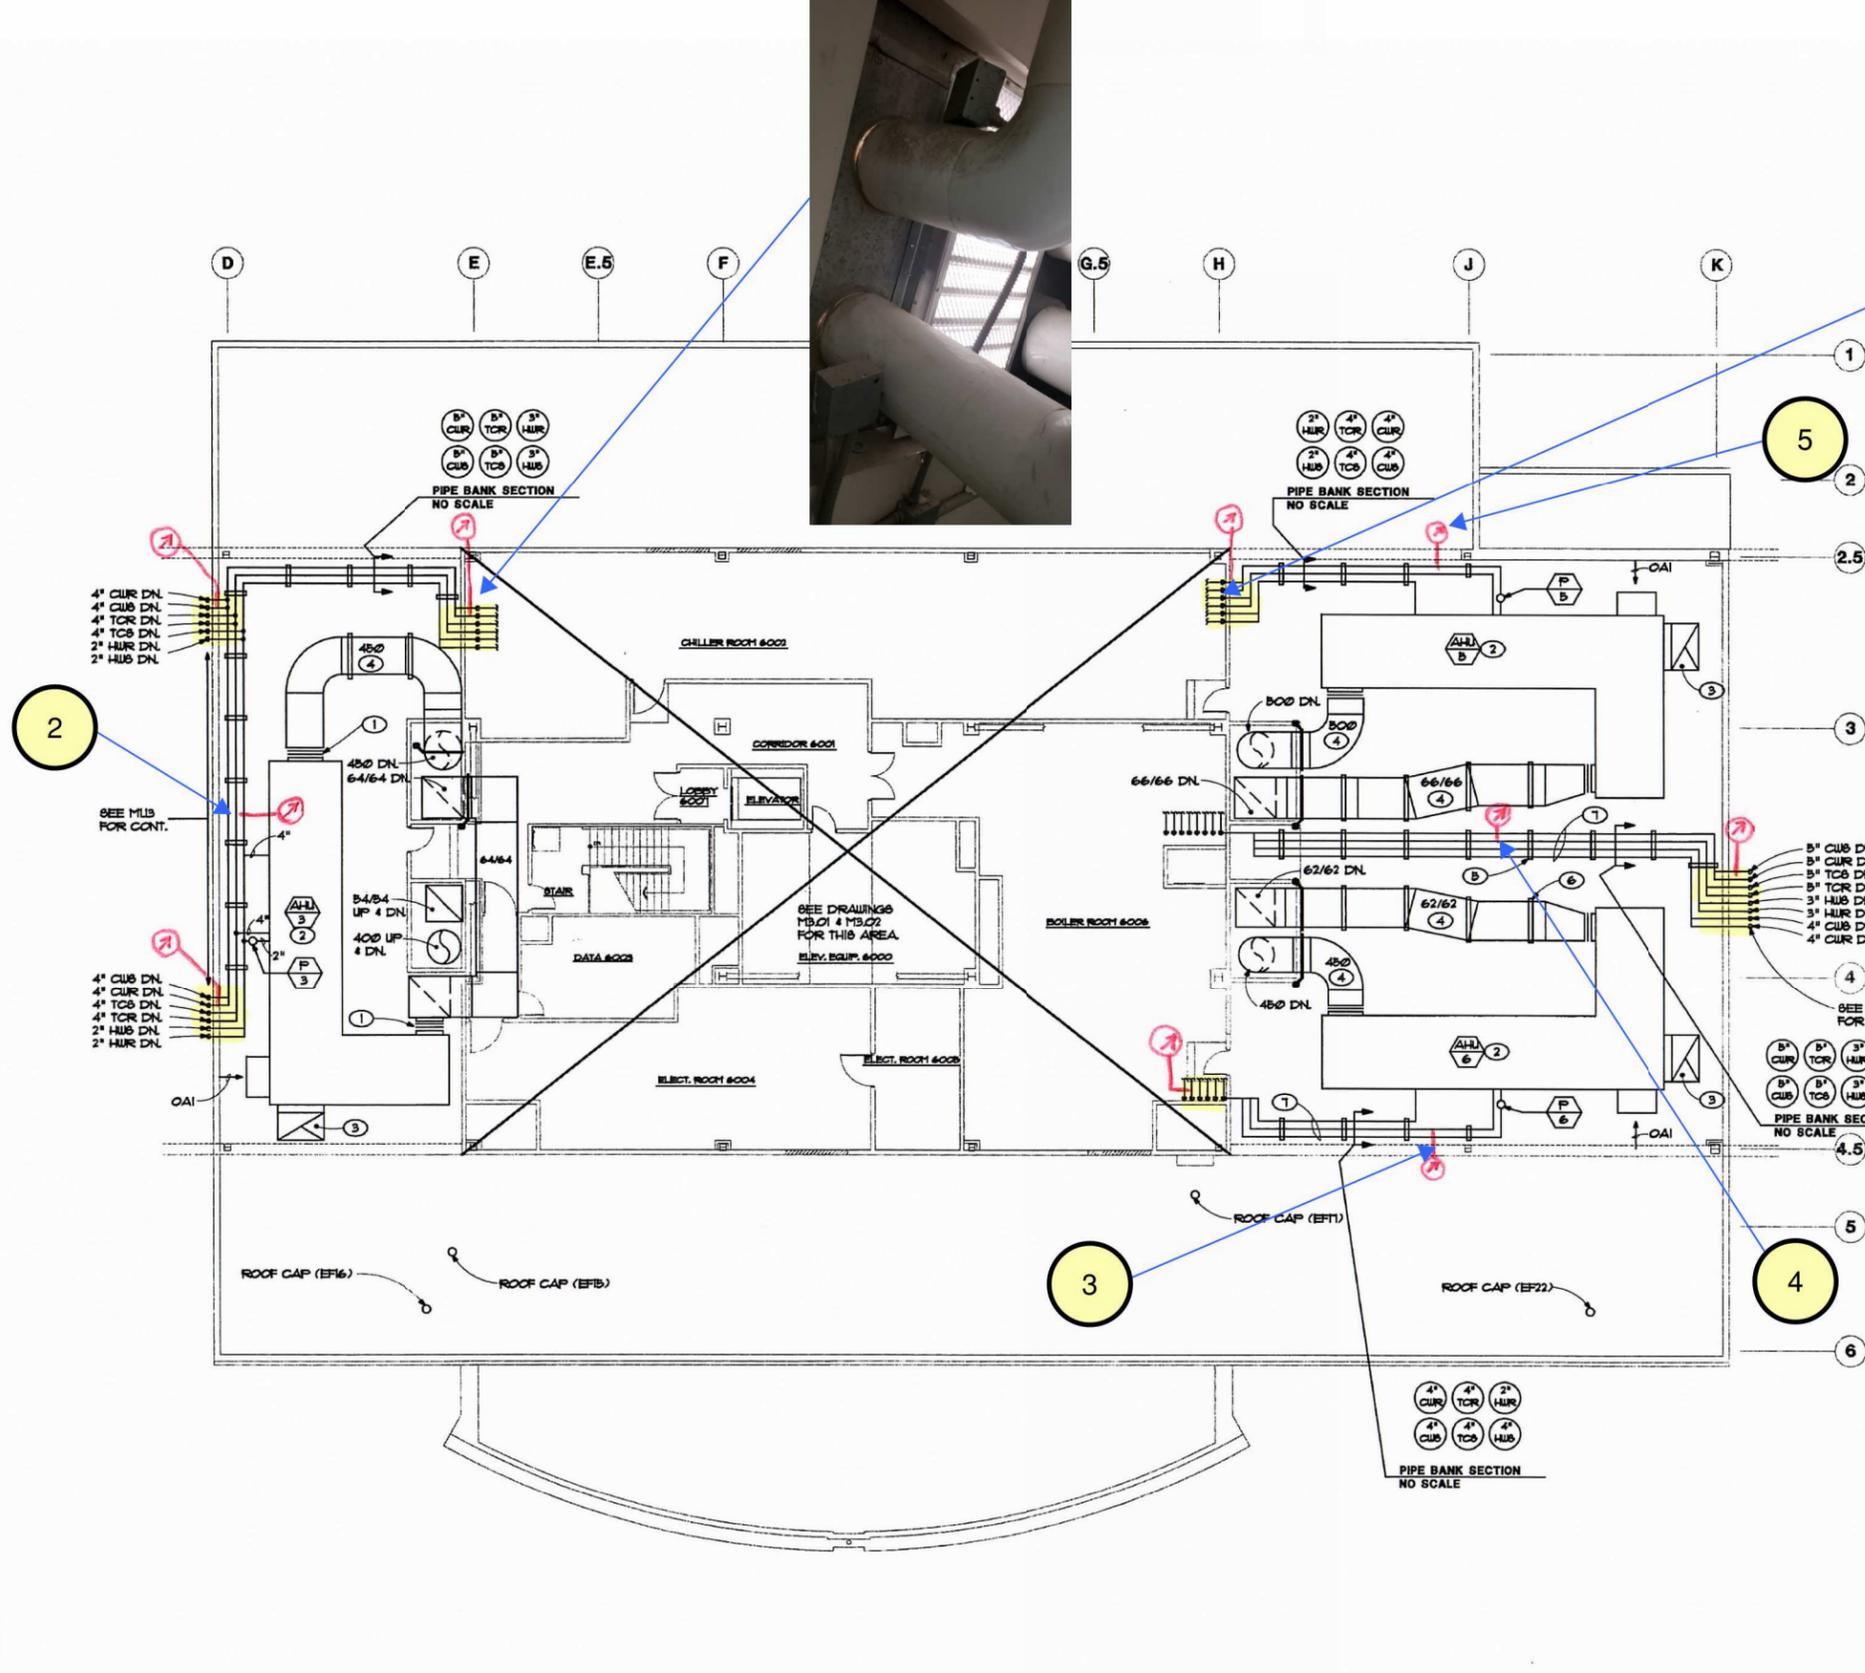


GENERAL NOTES

- A. SEE ARCHITECTURAL AND / OR STRUCTURAL DRAWINGS FOR APPLICABLE ROOF PENETRATION DETAILS & METHODS.
- B. DUCT DIMENSIONS SHOWN ARE INSIDE CLEAR DIMENSIONS. SEE SPECIFICATIONS FOR INTERNAL DUCT LINE & INCREASE SHEET METAL SIZES ACCORDINGLY.
- C. GENERAL CONTRACTOR SHALL ARRANGE FOR MEMBRANE APPLICATOR TO BE PRESENT DURING INSTALLATION OF ANY MECHANICAL EQUIPMENT OCCURRING AFTER INSTALLATION OF ROOF MEMBRANE. REFER TO SECTION 0730 FOR ADDITIONAL INFORMATION. INSTALLATION OF MECHANICAL EQUIPMENT / PIPING BEFORE ROOF MEMBRANE IS INSTALLED IS NOT TO BE PERMITTED.
- D. DUCTWORK CONSTRUCTION REQUIREMENTS:
 - a) LOW PRESSURE: 1" WG POSITIVE OR NEGATIVE PRESSURE.
 - b) MEDIUM PRESSURE (MP): 4" WG POSITIVE PRESSURE.
- E. SEE SPEC. SECTION 0816 FOR HEAT TAPE TREATMENT OF PIPELINES.

SHEET NOTES

- 1 TYPICAL: NEOPRENE FLEX CONNECTION.
- 2 MOUNT ON STRUCTURAL STEEL FRAME, SEE ARCHITECTURAL & STRUCTURAL DRAWINGS.
- 3 42/12 EXHAUST DUCT UP TO JUST BELOW TREL EXHAUST SCREEN AT TOP & DRAIN AT BOTTOM.
- 4 SEE DUCT SUPPORT DETAILS ON ARCHITECTURAL DRAWINGS.
- 5 TYPICAL PIPING SUPPORT; LOCATE AT BEAM LINES; SEE ARCHITECTURAL & STRUCTURAL DRAWINGS FOR ADDITIONAL SUPPORTS NOT SHOWN. IN FACT, BE REQUIRED FOR PROPER INSTALLATION & SHALL BE PROVIDED.
- 6 TYPICAL DUCTWORK SUPPORT; LOCATE AT BEAM LINES; SEE ARCHITECTURAL & STRUCTURAL DRAWINGS FOR DETAILS. ADDITIONAL SUPPORTS NOT SHOWN MAY, IN FACT, BE REQUIRED FOR PROPER INSTALLATION & SHALL BE PROVIDED.
- 7 SEE PIPE SUPPORT DETAILS ON ARCHITECTURAL DRAWINGS.

HARRIS ENGINEERS, INC.
MECHANICAL/ELECTRICAL CONSULTANTS
2760 Carl Street, Suite 200
Las Vegas, Nevada 89121
702/735-0204

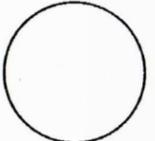

Check and verify all dimensions and report all errors to the Architect prior to commencing work. These drawings are not to be used for any other project without the written consent of the Architect. No part of these drawings shall be reproduced or transmitted in any form or by any means, electronic, mechanical, photocopying, recording, or by any information storage and retrieval system, without the prior written permission of Harris Engineers, Inc. A limited liability company. Copyright © Harris Engineers, Inc. 1993.

Date: FEBRUARY 23, 1993.
Project No: 91-010
Scale: AS NOTED
Drawn By: R.J.
Revisions:
2-23-93 RECORD DRAWINGS


Sheet Title:
SIXTH FLOOR (ROOF) DUCTWORK/PIPING PLAN - CENTER


Sheet Number:

M1.16

SIXTH FLOOR (ROOF) DUCTWORK / PIPING PLAN - CENTER

SCALE: 1/8" = 1' - 0"

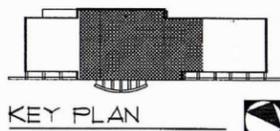

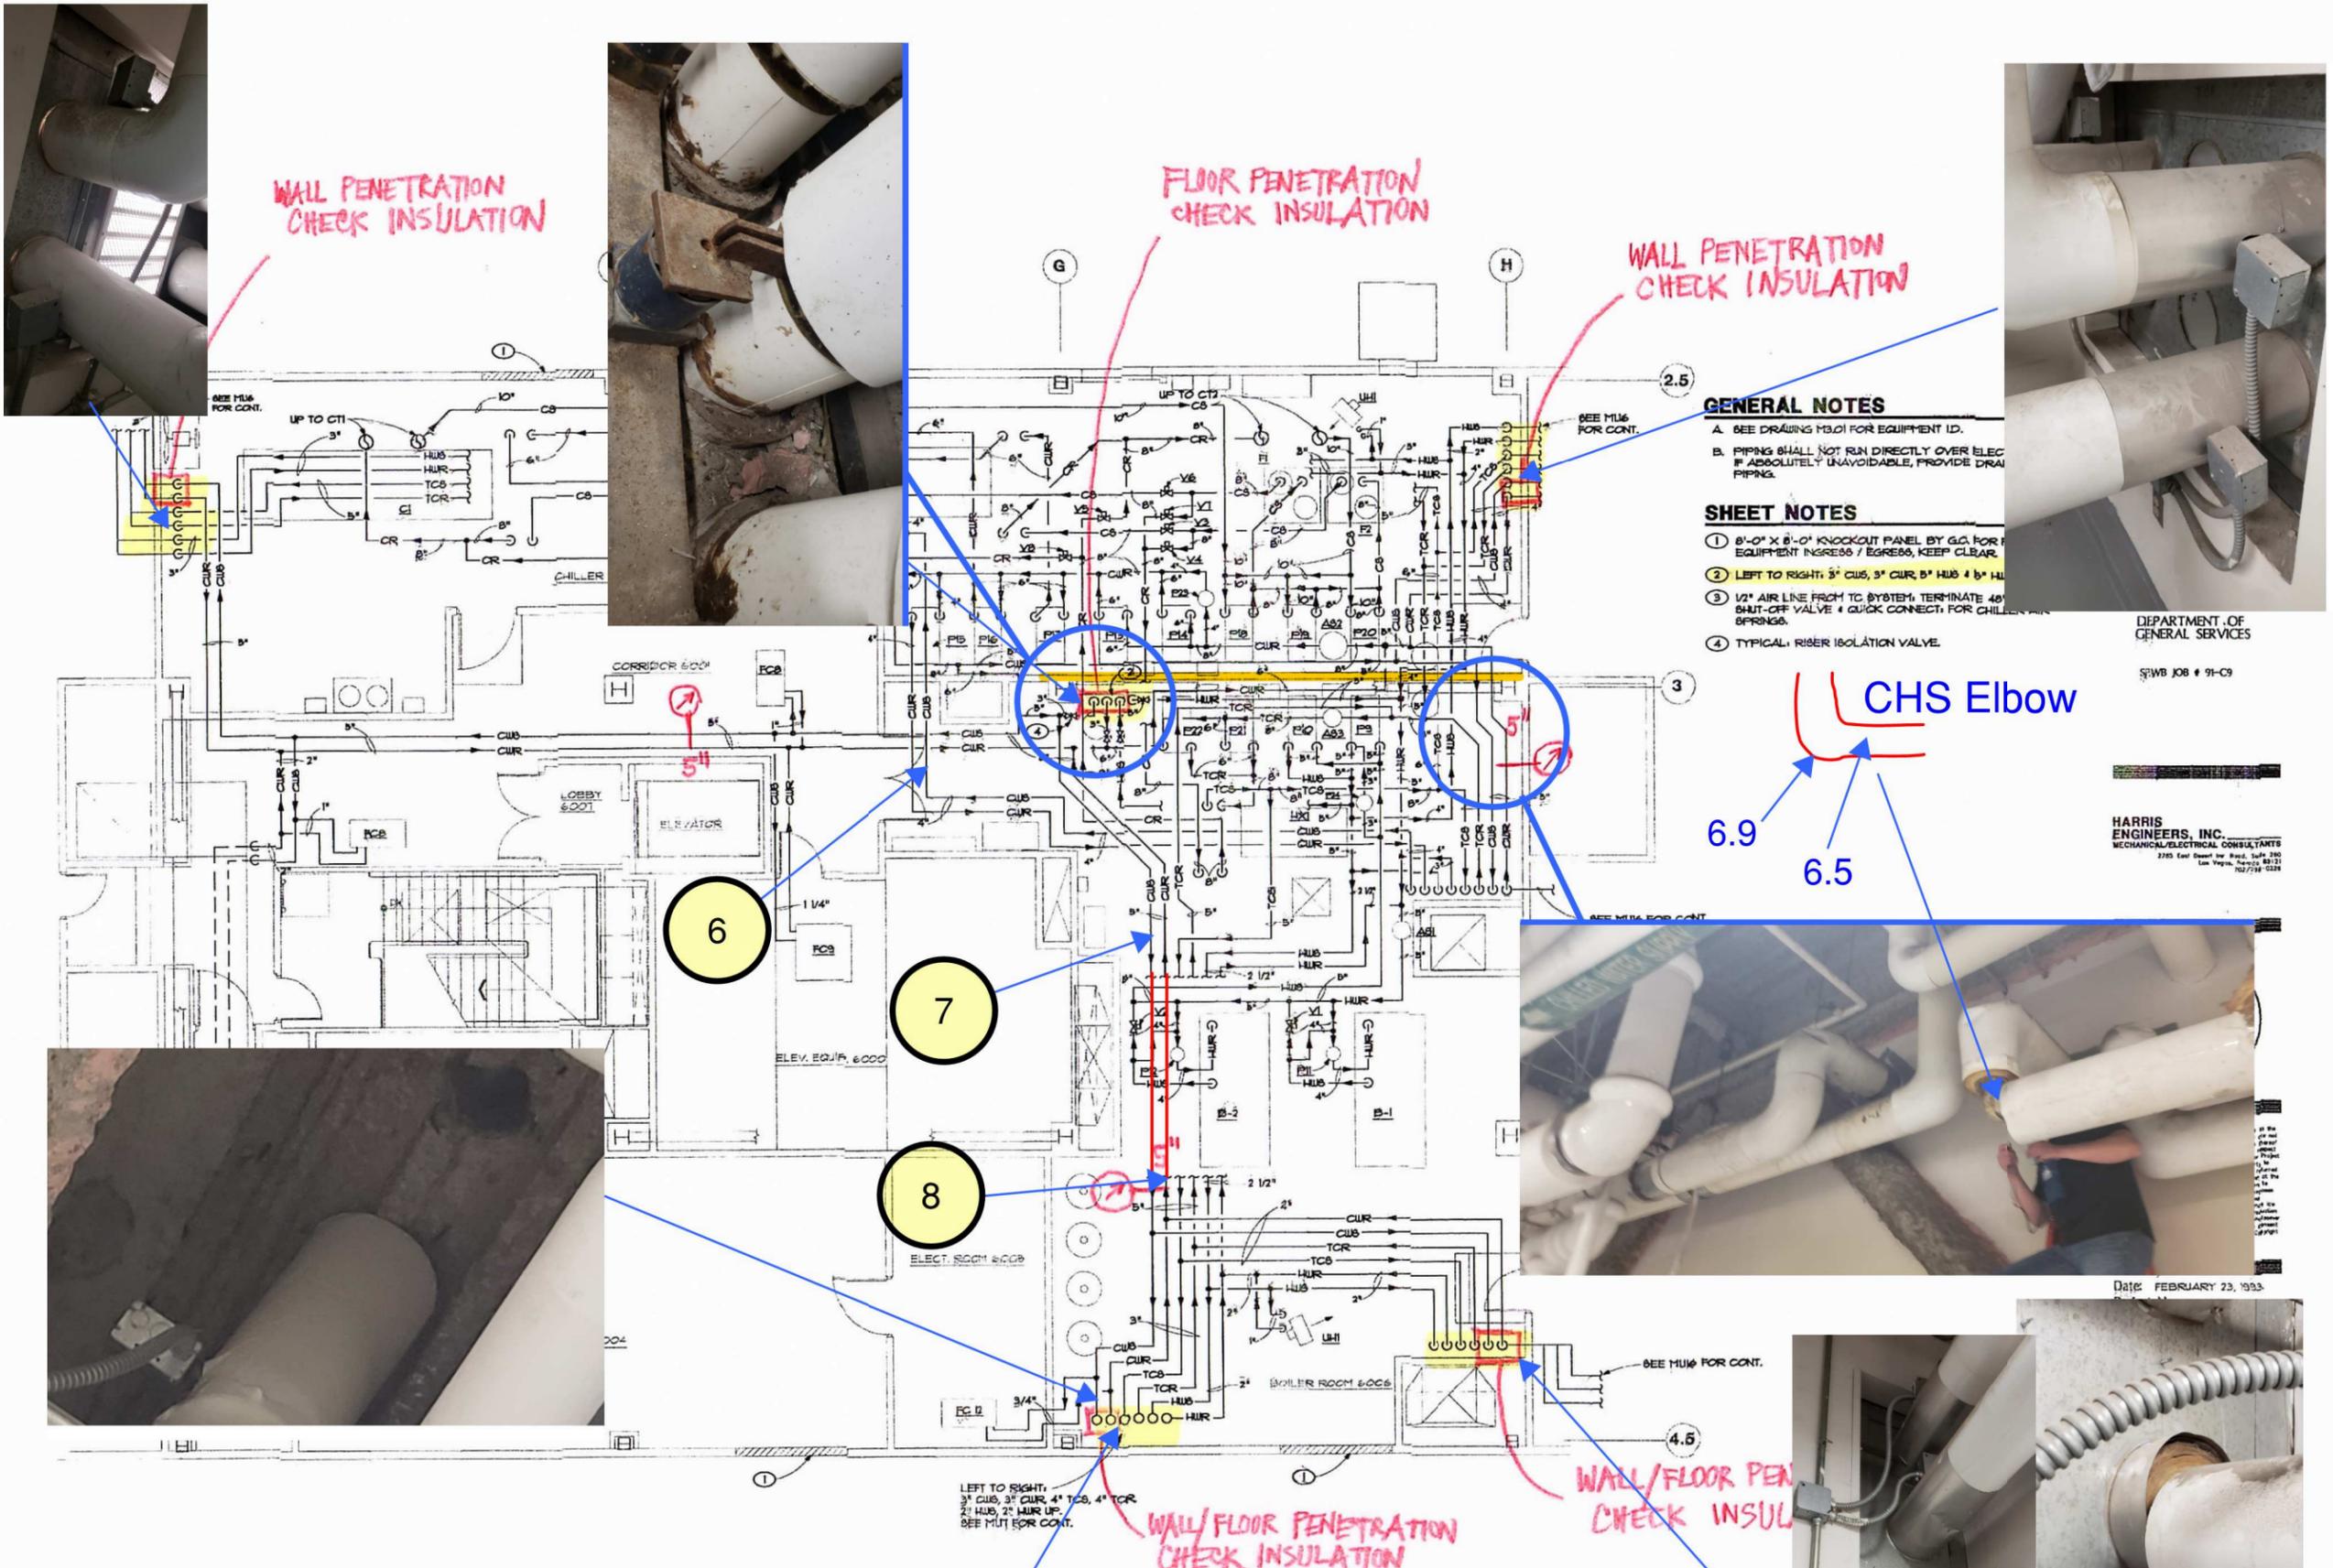

WALL PENETRATION CHECK INSULATION

FLOOR PENETRATION CHECK INSULATION

WALL PENETRATION CHECK INSULATION

GENERAL NOTES

- A. SEE DRAWING M3.01 FOR EQUIPMENT I.D.
- B. PIPING SHALL NOT RUN DIRECTLY OVER ELEC. IF ABSOLUTELY UNAVOIDABLE, PROVIDE DRAIN PIPING.

SHEET NOTES

- 1. 8'-0" X 8'-0" KNOCKOUT PANEL BY G.C. FOR EQUIPMENT INGRESS / EGRESS, KEEP CLEAR.
- 2. LEFT TO RIGHT: 3" CUR, 3" CUR, 5" HUB & 4" HUB.
- 3. 1/2" AIR LINE FROM TC SYSTEM, TERMINATE AT SHUT-OFF VALVE & QUICK CONNECT FOR CHILLER SPRINGS.
- 4. TYPICAL RISER ISOLATION VALVE.

CHS Elbow

6.9

6.5

6

7

8

BOILER / CHILLER ROOMS HYAC PIPING PLAN

SCALE: 1/4" = 1'-0"

No insulation on penetration

DEPARTMENT OF GENERAL SERVICES
SMB JOB # 91-C9

HARRIS ENGINEERS, INC.
MECHANICAL/ELECTRICAL CONSULTANTS
2205 East Street, Suite 2100
Los Angeles, California 90012
Tel: 213-778-0228

Date: FEBRUARY 23, 1993


41/

Abandoned Pipes,
& New copper

15

FIRE RATED WALL PENETRATION
CHECK INSULATION

Abandoned Pipes,
& New copper

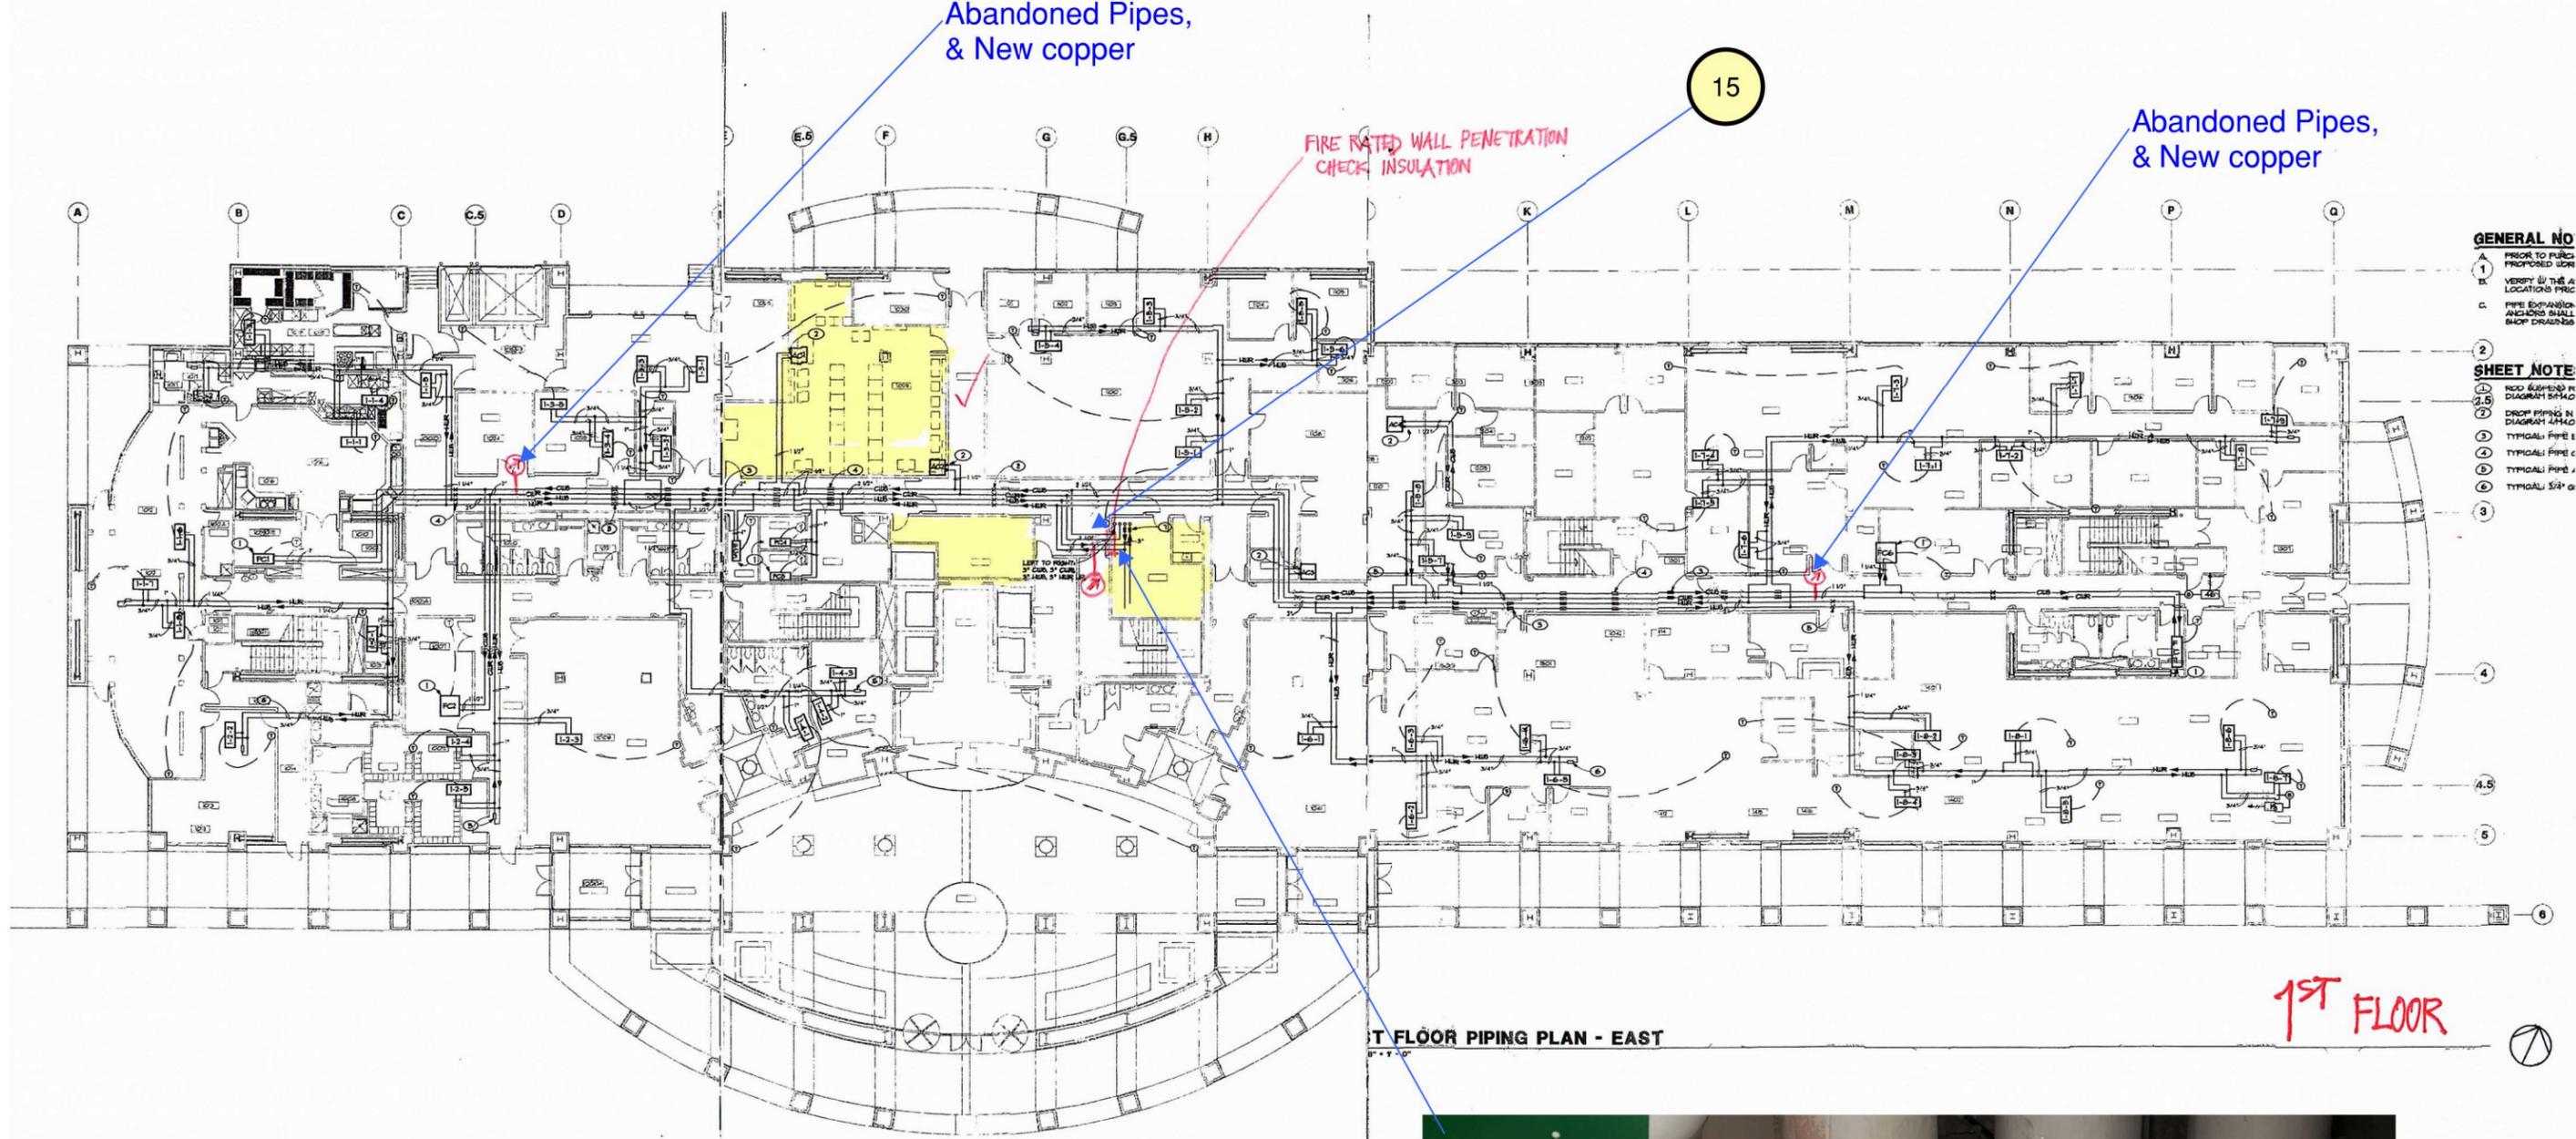

- GENERAL NO**
- 1 PRIOR TO PIPING PROPOSED WORK
 - 2 VERIFY W/ THE ARCHITECT LOCATION PIPING
 - 3 PIPE EXTENSION AND/OR SHALL SHOP DRAWINGS
- SHEET NOTE**
- 1.1 HOD EQUIPMENT IN DIAGRAM 5-1-10
 - 1.2 DROP PIPING IN DIAGRAM 5-1-10
 - 2 TYPICAL PIPE E
 - 3 TYPICAL PIPE C
 - 4 TYPICAL PIPE J
 - 5 TYPICAL 5/4" G

OR PIPING PLAN - WEST

G PLAN - CENTER

1ST FLOOR PIPING PLAN - EAST

1ST FLOOR

*Spencer
1/20/10*



Elevator Assessment





January 02, 2019

Brian Henley
Partner, Architect
KGA ARCHITECTURE
9075 West Diablo Drive, Suite 300
Las Vegas, Nevada 89148

Reference: GRANT SAWYER STATE OFFICE BUILDING - Property Condition Assessment

Dear Brian:

On October 15, 2018 HKA Elevator Consulting, Inc. made a site visit to the Grant Sawyer State Office Building at 555 E Washington Ave located in Las Vegas, NV. The building is 224,000 gross square feet in size and located just north of downtown Las Vegas. The purpose of our visit was to survey four (4) passenger elevators and one (1) service elevator for modernization, repair or replacement. The survey was to determine the existing elevator equipment condition, building and hoistway construction and determine the work by others criteria for the elevator modernization specifications. The following is the result of our survey. The vertical transportation equipment was manufactured and installed by Montgomery Elevator Company in 1995.

ELEVATOR OPTIONS:

- A. Repair major components.

GRANT SAWYER ELEVATOR INVENTORY:

Elevator	Use	Capacity	Speed FPM	Machine Type	Floors Served	Openings	Door Type	Door Opg
1	Passenger	3500	350	OH DC Geared	1,2,3,4,5	Front	C/O	3'-6"
2	Passenger	3500	350	OH DC Geared	1,2,3,4,5	Front	C/O	3'-6"
3	Passenger	3500	350	OH DC Geared	1,2,3,4,5	Front	C/O	3'-6"
4	Passenger	3500	350	OH DC Geared	1,1R, 2,3,4,5, 5R	Front & Rear	C/O	3'-6"
Serv. 5	Service	4000	350	OH DC Geared	1,2,3,4,5,6	Front	S/O	4'-0"

EXECUTIVE SUMMARY OF CONDITIONS:

The existing elevator equipment was manufactured and installed by Montgomery Elevator Company in 1995. The elevator equipment is original to the building and has not been modernized. The current service provider is Otis Elevator Company.

We found the annual and five year code required tests are all overdue. The date of the last inspection was in 2015 for the passenger elevators and 2012 for the service elevator. In our opinion, all elevators should be written up and red-tagged if corrections are not implemented. The last five year full load test was performed in 2012. These tests and inspections should be completed immediately.

The machines are Montgomery geared DC traction model 208E, roped 1:1. The passenger cars have a

30HP DC motor and the service car has a 40HP DC motor. The machines are in fair to poor condition and are now obsolete. Replacement parts are becoming very hard to procure. We noted the hoist ropes are severely rouging / undersized and are in need of replacement as they do not meet current codes. The elevators were all running approximately 10% less than contract speed.

The controllers are Montgomery solid state Ultron model controllers. The controllers and drives are in poor condition and are now obsolete. Replacement parts cannot be obtained. Elevator #2 has been shut down for 2 years due to the need for a new drive unit.

MAJOR REPAIRS*: within 30-120 days

- Replace hoist ropes, equalize, tension, rope lubricators, replace missing clips – 5 elevators
- Replace or repair drive unit - #2
- Perform annual inspections, annual and full 5 year safety tests – 5 elevators
- Test buffers and safety circuits – all 5 elevators
- Adjust door closing pressure to be within code (30 ft. lbs.) – 5 elevators
- Perform complete tear down of brakes including cores and linings – 5 elevators
- Replace machine seal - #3
- Drain, flush and refill machine gear oil, seal leaks – 5 elevators
- Replace controller fan – service elevator
- Perform hoistway clean down including car tops and pits – 5 elevators
- Remove trash, debris, building materials from machine rooms
- Install fire extinguisher – passenger machine room
- Replace car fans - #1 and 3

**Check your service contract as some or all of these repairs may be covered under your existing maintenance agreement.*

We estimate these repairs would cost approximately \$200K.

These estimates do not include any work that will be required to be performed by other contractors to upgrade existing hoistways, machine rooms and electrical work for compliance with code. For the new elevator scenario, this does include the cost to build the new core and only includes four (4) passenger elevators. The service elevator would remain in place and be fully modernized. The old core will need to be removed as well.

AREAS OF CONCERNS:

1. Inspections and code required tests are all overdue.
2. The major equipment components are obsolete.
3. Extensive repairs are immediately necessary.

Please review this information and give me a call to discuss these items prior to developing the rough draft of the modernization specification. Should you have any questions regarding the above, please do not hesitate to call.

Sincerely,
HKA Elevator Consulting, Inc.

Jeff Crusham

Jeff Crusham
Director, National Business Development

PHOTOS NEXT PAGES



GRANT SAWYER STATE OFFICE BUILDING: ELEVATORS #1-5

ELEVATOR NUMBER	Machine Room
-----------------	---------------------

GRANT SAWYER STATE OFFICE BUILDING: ELEVATORS #1-5	
#1-4	<p>Passenger machines and controllers.</p>
#5	

GRANT SAWYER STATE OFFICE BUILDING: ELEVATORS #1-5	
	Service machine and controller.
#1-4	 <p>Passenger controllers.</p>
#1-4	 <p>Materials being stored in room.</p>

GRANT SAWYER STATE OFFICE BUILDING: ELEVATORS #1-5	
#5	 <p>Ladder not secured, stored energy.</p>
Machine	
#4	 <p>Typical passenger worm and gear DC machine with DC motor.</p>

GRANT SAWYER STATE OFFICE BUILDING: ELEVATORS #1-5

#5



Service car worm and gear DC machine with DC motor.

#1



Typical passenger worm and gear DC machine with DC motor.

GRANT SAWYER STATE OFFICE BUILDING: ELEVATORS #1-5

#1



Ropes showing wear. Rope debris.

GRANT SAWYER STATE OFFICE BUILDING: ELEVATORS #1-5

#1



10/15/2018

Typical gear box.

Controller & Motor Drives

GRANT SAWYER STATE OFFICE BUILDING: ELEVATORS #1-5

#1



10/15/2018

Typical Ultron controller.



Typical Ultron controller.

GRANT SAWYER STATE OFFICE BUILDING: ELEVATORS #1-5

#2	
#2	

Drive unit.



Drive is bad. Requires board repair.

GRANT SAWYER STATE OFFICE BUILDING: ELEVATORS #1-5

Pass	
Selector / Governor	
Pass	
Car Top / Hoistway / Ropes	

Controller card racks.

Typical governor.

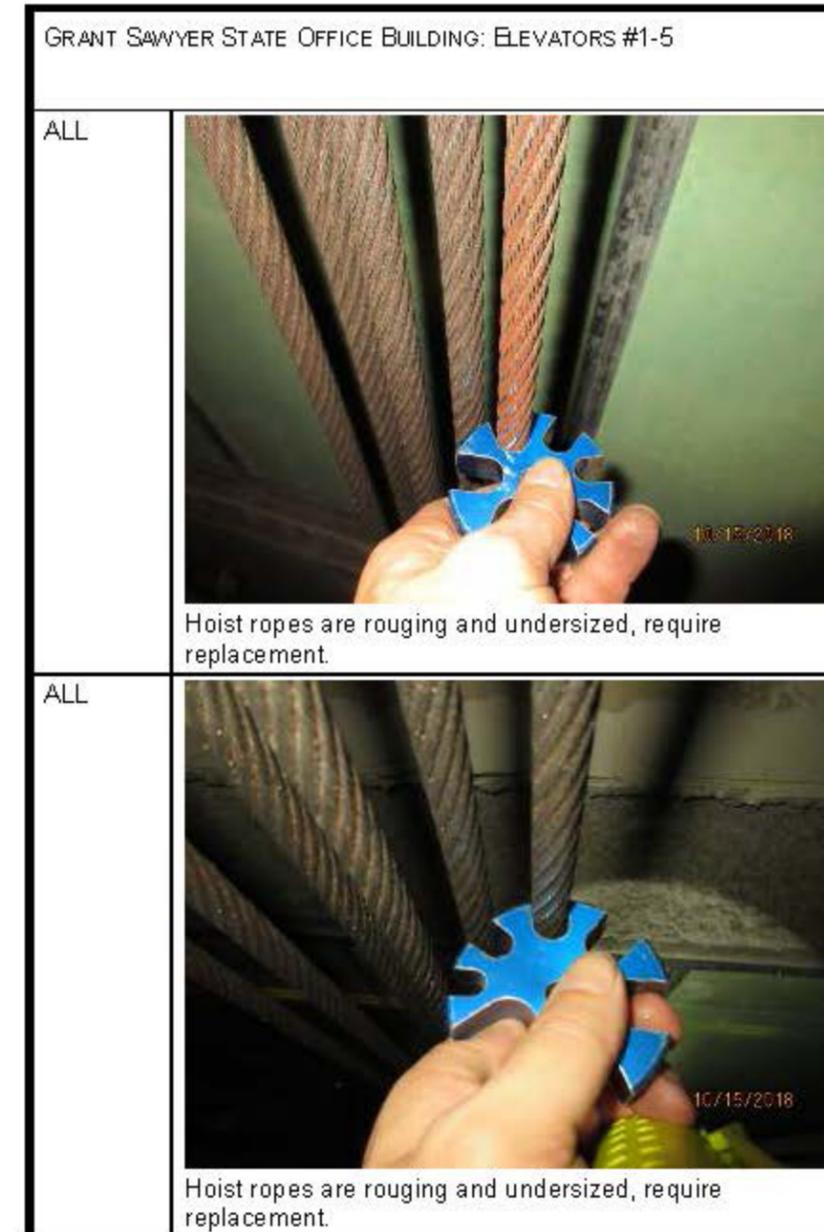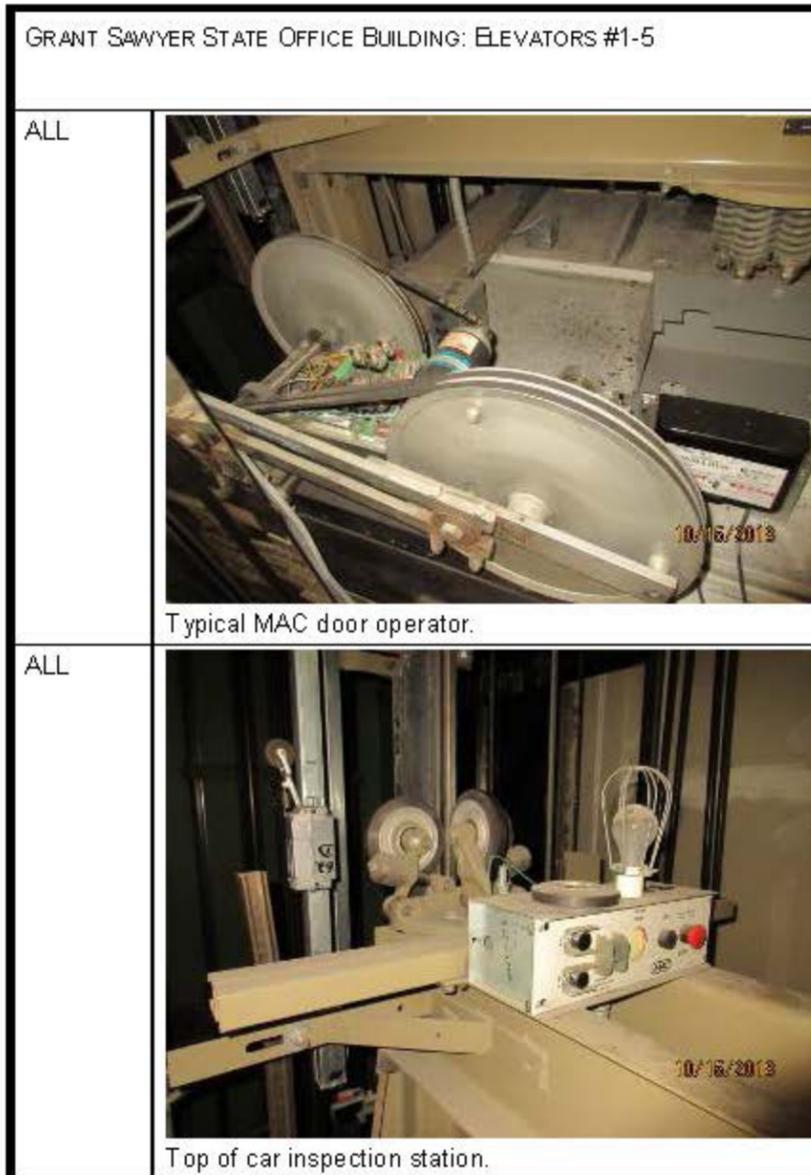

GRANT SAWYER STATE OFFICE BUILDING: ELEVATORS #1-5	
ALL	 <p>10/16/2018</p> <p>Typical door pick up roller assembly.</p>
ALL	 <p>10/15/2018</p> <p>Typical counterweights. These would be retained and reused.</p>

GRANT SAWYER STATE OFFICE BUILDING: ELEVATORS #1-5	
ALL	 <p>10/16/2018</p> <p>Counterweight roller guides.</p>
ALL	 <p>10/16/2018</p> <p>Car roller guides.</p>
Pit Area	

GRANT SAWYER STATE OFFICE BUILDING: ELEVATORS #1-5

ALL



Typical pit showing buffer.

Door & Frames

ALL



GRANT SAWYER STATE OFFICE BUILDING: ELEVATORS #1-5

ALL



Lobbies.

ALL



GRANT SAWYER STATE OFFICE BUILDING: ELEVATORS #1-5



Hall doors may be reused.

ALL



Hall door gibbs.

GRANT SAWYER STATE OFFICE BUILDING: ELEVATORS #1-5

ALL



Hoistway door equipment.

Cabs & Fixtures

ALL



Typical car operating panel

GRANT SAWYER STATE OFFICE BUILDING: ELEVATORS #1-5

#4



Car panel in good condition.


GRANT SAWYER STATE OFFICE BUILDING: ELEVATORS #1-5

#5



Car panel is ADA compliant and in good condition.

ALL

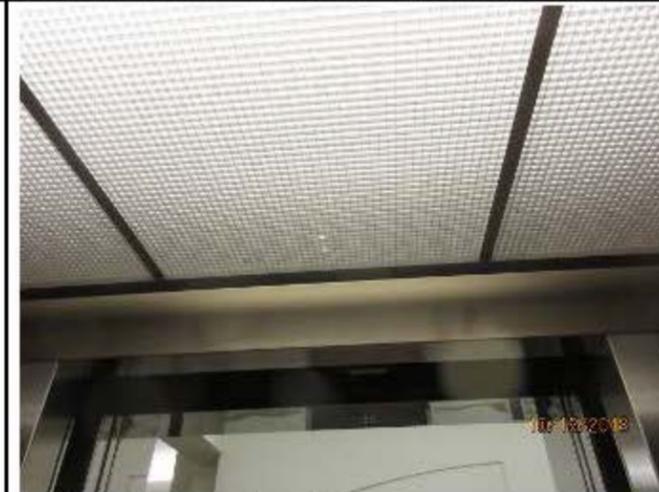

Cab interiors in good condition.

GRANT SAWYER STATE OFFICE BUILDING: ELEVATORS #1-5	
ALL	 <p>10/15/2018</p> <p>Cab interiors in good condition.</p>
#5	 <p>10/15/2018</p> <p>Existing service cab interior.</p>

GRANT SAWYER STATE OFFICE BUILDING: ELEVATORS #1-5	
ALL	 <p>10/16/2018</p> <p>New vandal resistant fixtures meeting ADA will be installed.</p>
ALL	 <p>10/16/2018</p> <p>Hall lanterns can be retained. LED lighting clusters can be added.</p>

GRANT SAWYER STATE OFFICE BUILDING: ELEVATORS #1-5

ALL	 <p>In car lanterns.</p>
Lobby Stations	
ALL	 <p>Elevator lobby station in Fire Control Room.</p>

GRANT SAWYER STATE OFFICE BUILDING: ELEVATORS #1-5

ALL	
Smoke & Heat Detectors	
ALL	There are smoke detectors but there are no heat detectors.
Machine Room Electrical	
ALL	 <p>Existing main line disconnect switches.</p>

GRANT SAWYER STATE OFFICE BUILDING: ELEVATORS #1-5	
ALL	 <p>Car light 100V disconnect switches will be required in machine rooms.</p>
ALL	 <p>Machine room outlets will need to be converted to GFI outlets, one per wall.</p>
Shunt Trip Devices & Sprinklers	

GRANT SAWYER STATE OFFICE BUILDING: ELEVATORS #1-5	
ALL	 <p>Shunt trips in the machine rooms will be required due to sprinklers.</p>
ALL	 <p>There are sump pumps in the pits.</p>
Machine Room Doors / Stairs	

GRANT SAWYER STATE OFFICE BUILDING: ELEVATORS #1-5	
#5	 <p>This ladder will require a variance to be reused for a modernization.</p>
ALL	 <p>All machine room doors meet code.</p>

GRANT SAWYER STATE OFFICE BUILDING: ELEVATORS #1-5	
ALL	 <p>All machine room doors meet code.</p>
Machine Room Ventilation	
ALL	

GRANT SAWYER STATE OFFICE BUILDING: ELEVATORS #1-5	
	 <p>10/16/2018</p> <p>AC is in rooms.</p>
Machine Room Fire Extinguishers	
#5	 <p>10/16/2018</p> <p>ABC fire extinguisher is present in the machine room.</p>
#1-4	There is no fire extinguisher in this room.
Lobby Smoke Protection	

GRANT SAWYER STATE OFFICE BUILDING: ELEVATORS #1-5	
ALL	 <p>10/16/2018</p> <p>The lobbies have smoke control doors.</p>
Pit Access / Platforms	
ALL	 <p>10/15/2018</p> <p>Pits are accessible via pit ladder, will need to be modified to meet new codes.</p>

GRANT SAWYER STATE OFFICE BUILDING: ELEVATORS #1-5


Miscellaneous Items

ALL



Five year CAT 5 full load tests were last performed March 2011.

#1-4

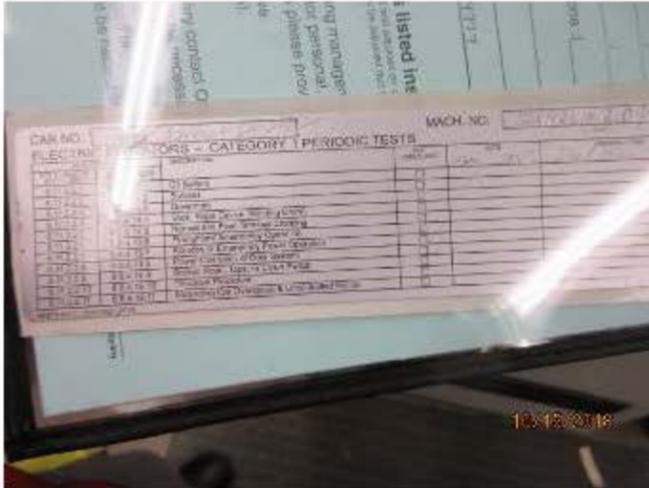

May 2015 was the last annual inspection.

GRANT SAWYER STATE OFFICE BUILDING: ELEVATORS #1-5

#1-4



Last CAT5 full load 5 year test performed in March 2011.

END OF REPORT

End of Volume Two

